



Purchasing Division

ADDENDUM NO. 1

DATE: March 18, 2020
FROM: City of Grand Junction Purchasing Division
TO: All Offerors
RE: 2020 Alley Improvement District IFB-4773-20-DH

Offerors responding to the above referenced solicitation are hereby instructed that the requirements have been clarified, modified, superseded and supplemented as to this date as hereinafter described.

Please make note of the following clarifications:

1. See attached pothole record for the gas line in this project.
2. See attached materials submittal form.
3. The Mandatory Pre-Bid Meeting for this solicitation/project is hereby cancelled. Contractors shall submit all questions/inquiries in writing to the assigned Purchasing Representative (duaneh@gjcity.org), per Section 1.13 Questions Regarding Statement of Work.

The original solicitation for the project noted above is amended as noted.

All other conditions of subject remain the same.

Respectfully,

A handwritten signature in black ink, appearing to read "Duane Hoff Jr.", written over a white background.

Duane Hoff Jr., Senior Buyer
City of Grand Junction, Colorado

Tech:

Node:

CI:

Period:


11th + Ute - City of Grand Junction

1 Hard Surface Pothole

1 Soft Surface Pothole

Potholed + Verified Gas depths / 2 Gauges

Diagram

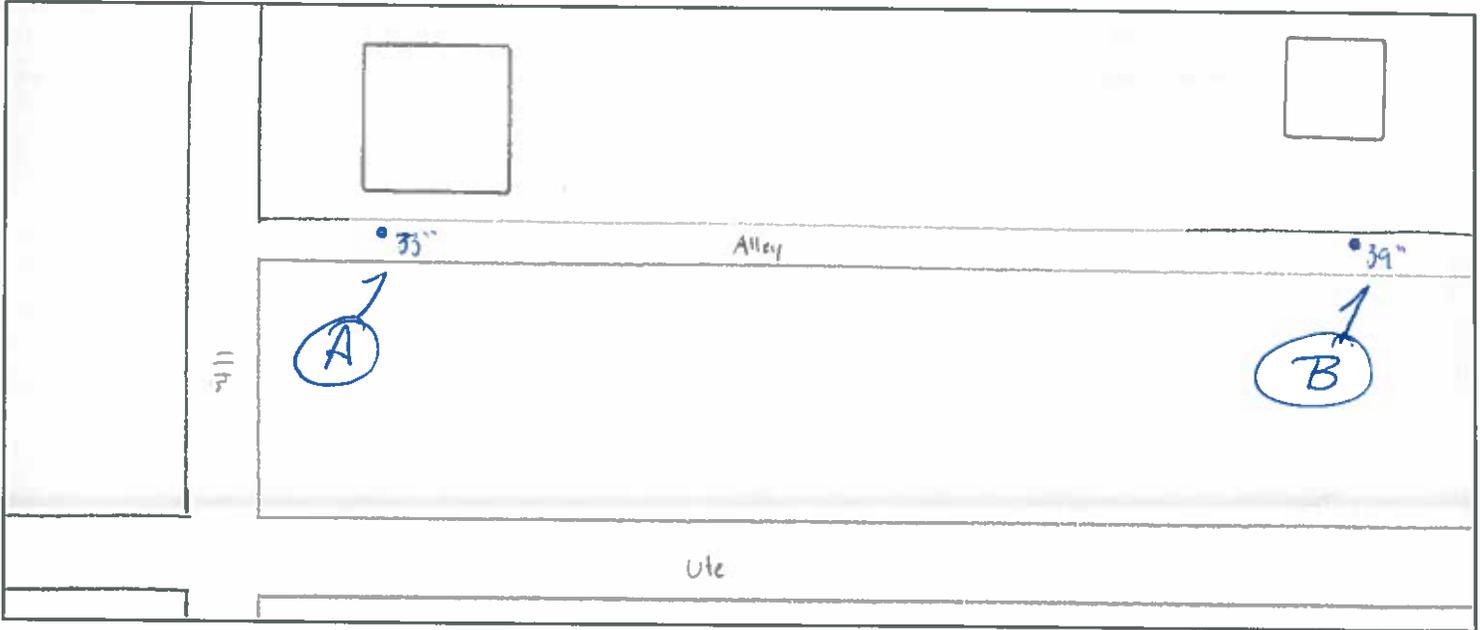

Comments:

(A) - 33" GAS

(B) - 39" GAS

Date: 3-9-20

PROJECT: 2020 Alley Reconstruction – 10th Street to 11th Street between Ute Avenue and Pitkin Avenue

CONTRACTOR: _____

PROJECT ENGINEER: John Eklund

Description	Date Received	Resubmittal Requested	Resubmittal Received	Date Accepted
-------------	---------------	-----------------------	----------------------	---------------

STREET CONSTRUCTION

Base Course Gradation, Proctor Curve				
Bedding Gradation, Type A				
Imported Backfill Material				
Granular Stabilization Material				
Concrete Mix Design				
Asphalt Mix Design				
Conduit				
Manholes				
Service Wye Fittings				
Service Saddle Fittings				
Ring and Covers				
Pipe to Manhole Connection				
Invert Epoxy Material				

EROSION CONTROL / STORMWATER MANAGEMENT

Inlet Protection				
Concrete Washout				
Stormwater Management Plan				

PERMITS, PLANS, OTHER

ACI Flatwork Finisher and Technician (ACICFFT)				
Traffic Control Plan				
Construction Schedule				