


REVISION	DESCRIPTION	DATE
△		
△		
△		
△		


DRAWN BY	JCS	DATE	2019
DESIGNED BY	JCS	DATE	2019
CHECKED BY	BCH	DATE	2019
APPROVED BY	TCP	DATE	2019

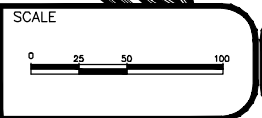

**PUBLIC WORKS
ENGINEERING DIVISION**


**THE RIVERFRONT AT DOS RIOS
OVERLOT GRADING - 1
June 19, 2020**

N:\Landproj\2019 Riverfront at Dos Rios\dwg\00 design\Overlot Grading.dwg, 6/19/2020 8:01:30 AM

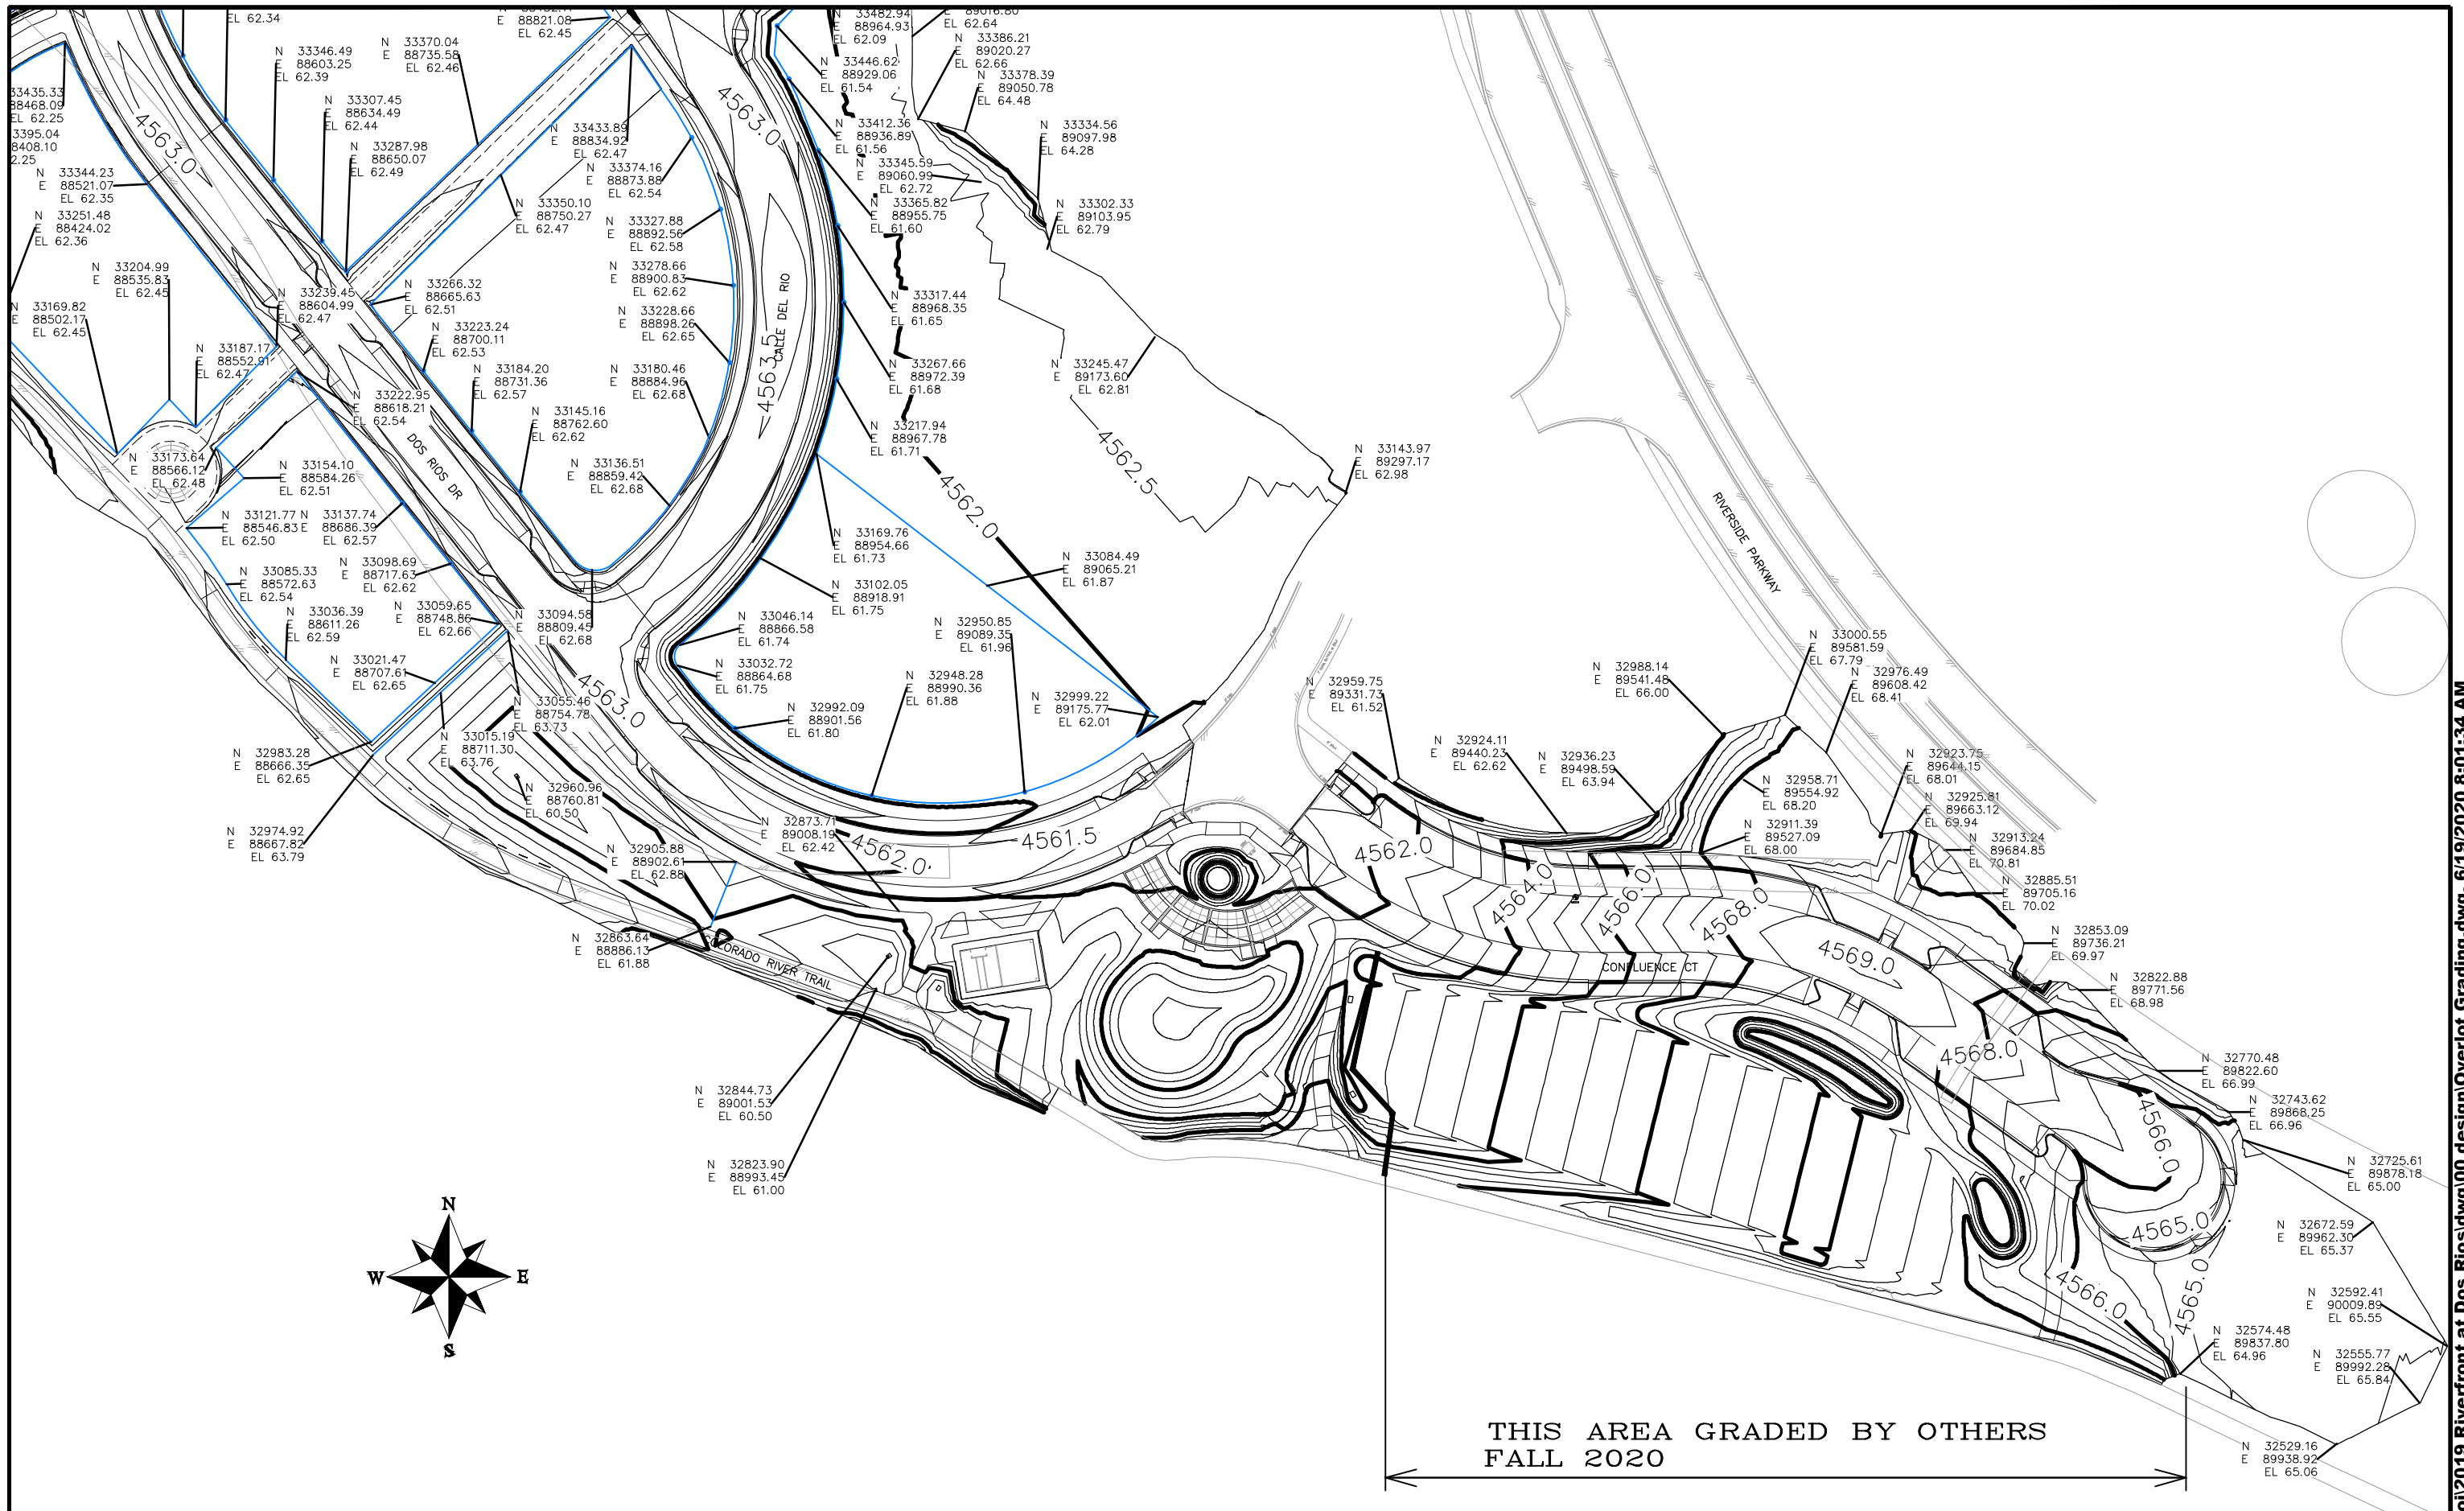

REVISION	DESCRIPTION	DATE
△		
△		
△		
△		

DRAWN BY	JCS	DATE	2019
DESIGNED BY	JCS	DATE	2019
CHECKED BY	BCH	DATE	2019
APPROVED BY	TCP	DATE	2019

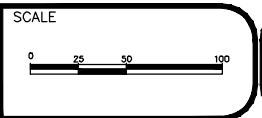

PUBLIC WORKS
ENGINEERING DIVISION

THE RIVERFRONT AT DOS RIOS
OVERLOT GRADING - 2
June 19, 2020

N:\Landproj\2019 Riverfront at Dos Rios\dwg\00 design\Overlot Grading.dwg, 6/19/2020 8:01:34 AM