


REVISIONS	BY
CITY OF GRANDTCT.	

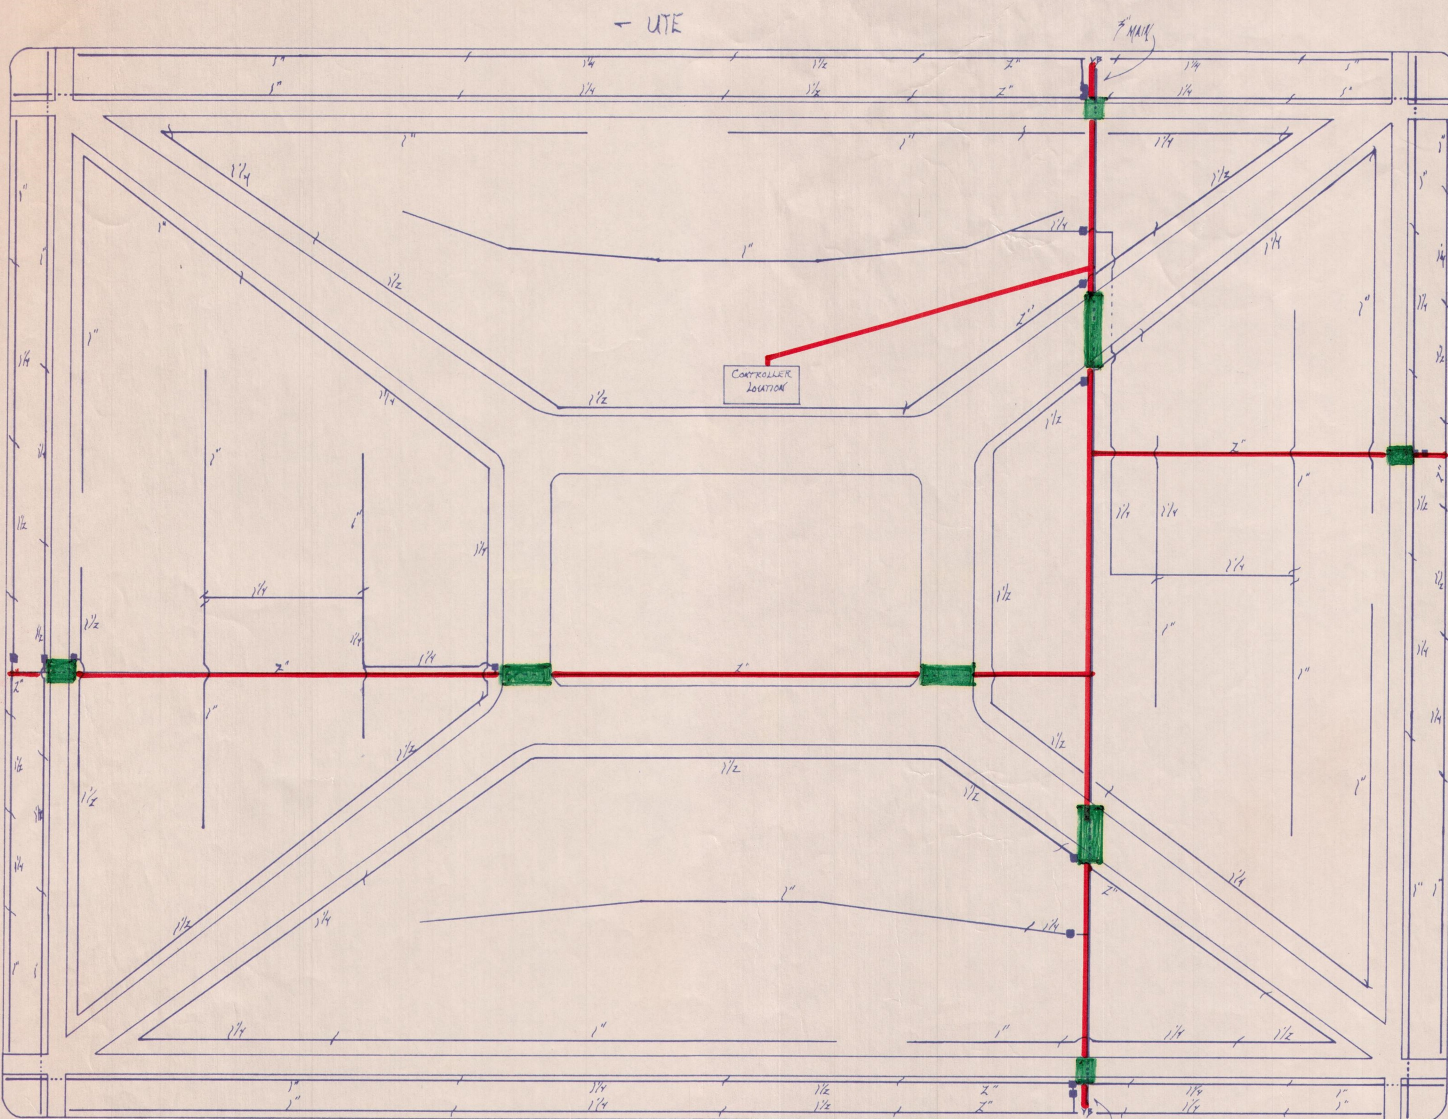


LEGEND
 VP 2" VALVE BREAKER
 ■ 2" ELECTRIC VALVE
 / LOCATION OF PIPE REDUCTION


Sleeve
Wire Location

NOTE - ALL INFORMATION AND PARTS LIST WILL BE AVAILABLE IN THE SPECIFICATIONS PROVIDED BY PARKS SUPERVISOR.

PITKIN →

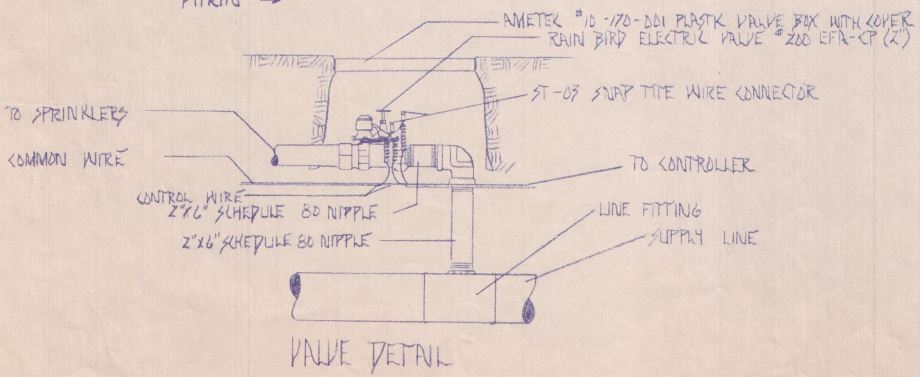

VALVE DETAIL

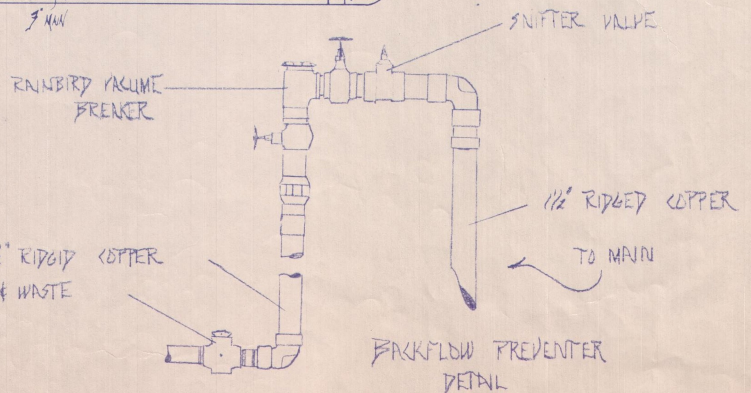

BACKFLOW PREVENTER DETAIL

EMERSON PARK

IRRIGATION SYSTEM

DRAWN KERRY ENGLEHART
CHECKED
DATE 9/27/88
SCALE NO SCALE
JOB NO.
SHEET #1
OF #1 SHEETS