


1st Floor

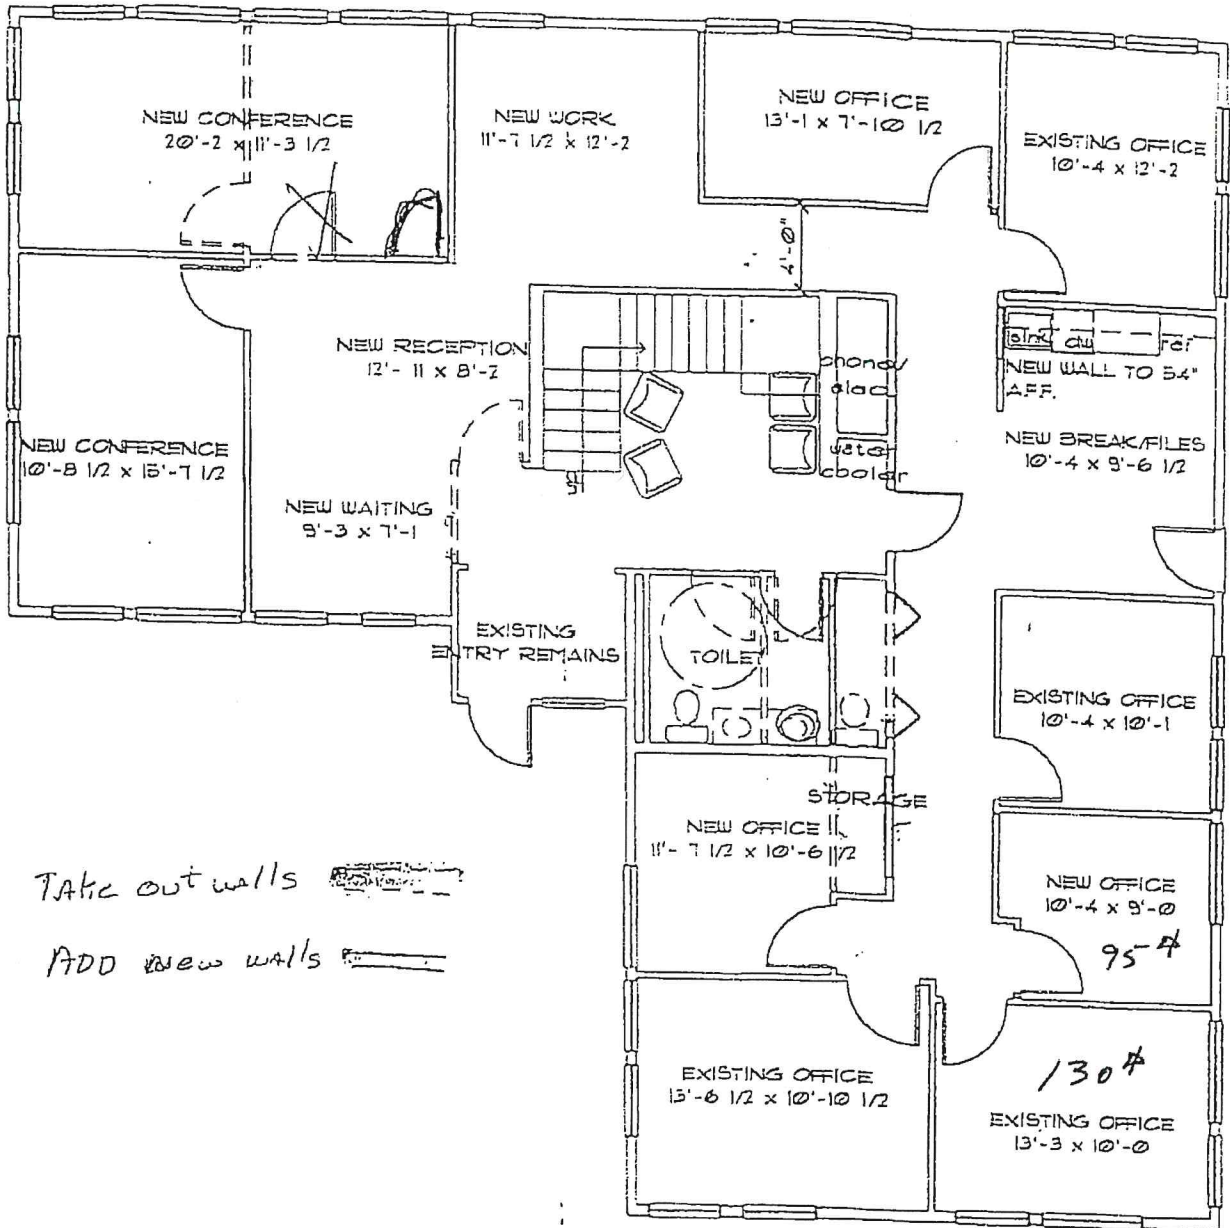


PROPOSED FIRST FLOOR PLAN

no scale

19 may 05 26 sept 05
 21 July 05 03 Oct 05
 15 aug 05

244 Nth 7th STREET BUILDING

244 Nth 7th STREET
 GRAND JUNCTION, COLO

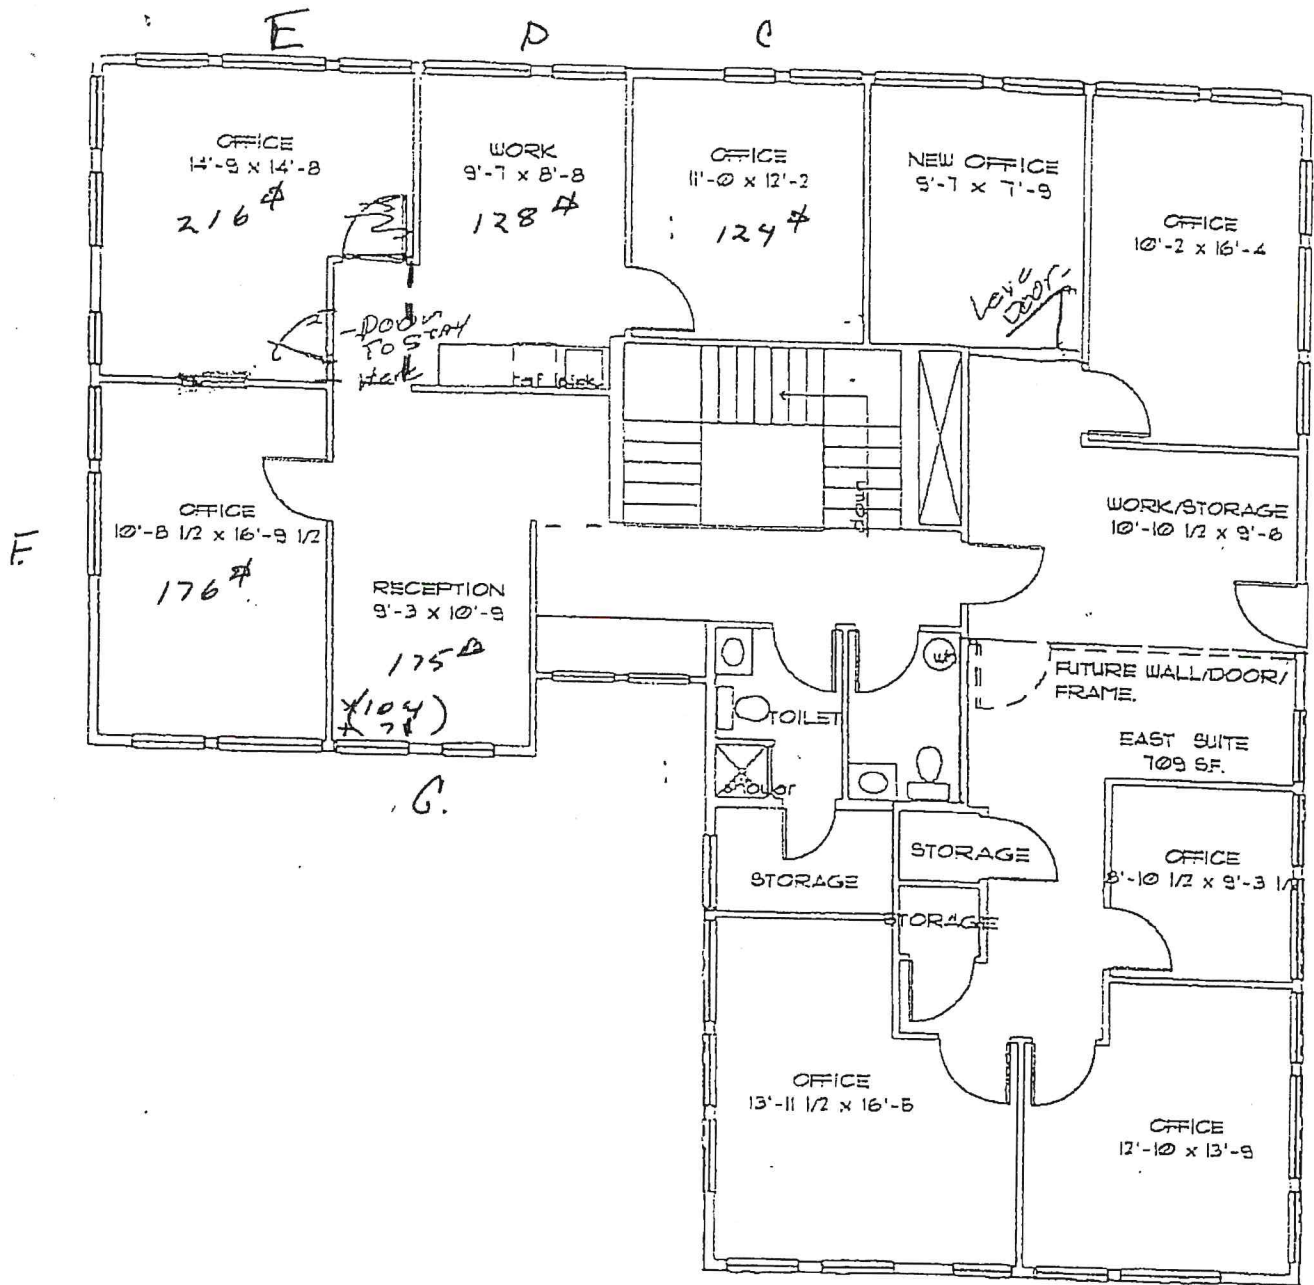

PROPOSED SECOND FLOOR PLAN - AREA CALCS

no scale

19 may 05 26 sept 05
 21 July 05
 15 aug 05

244 Nth 7th STREET BUILDING

244 Nth 7th STREET
 GRAND JUNCTION, COLO.