


New Concrete Pad
12" Larger Than Unit Stand
New 96" Disconnect
New Phase Converter

owner supplied unit is side discharge

See Mech. Note #1

Delete Vari Track Damper & Replace w/ Manual Vol. Damper

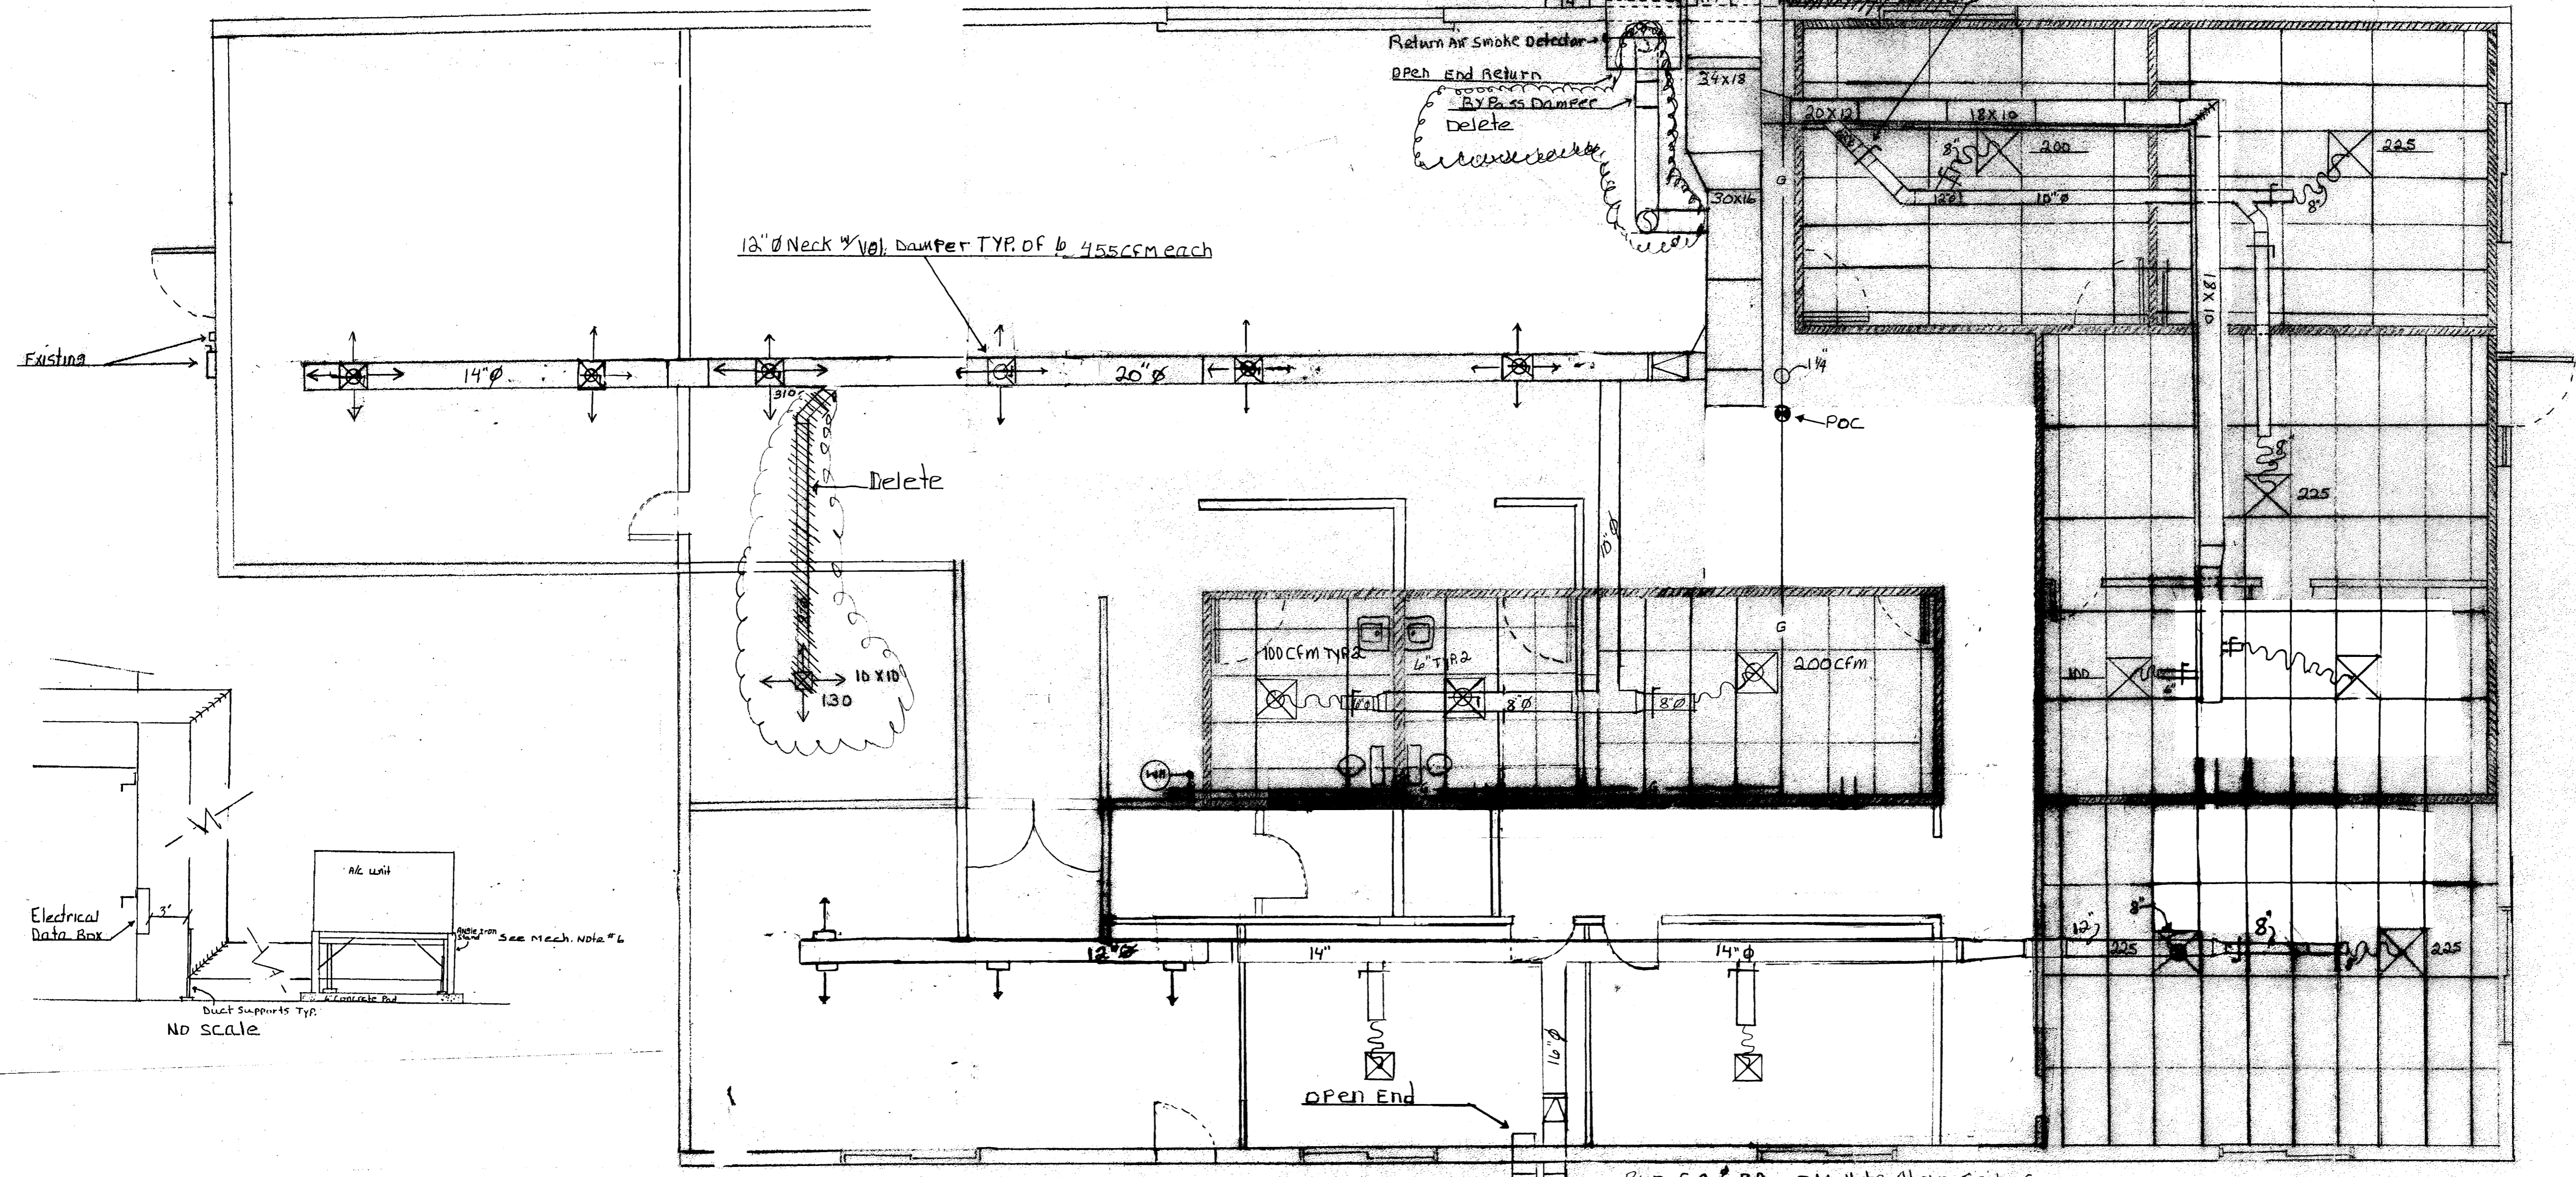

Existing


Delete

Electrical Data Box

A/C Unit


No scale

Open End

Run S.A. & RA UP Hall to Above Ceiling

3
Ton

owner supplied unit
New concrete pad 12" Larger Than unit stand

Mechanical Notes

- 1.) Maintain 3 ft. clearance between outside supply and return duct and electrical data box mounted on outside of wall.
- 2.) Line all exterior duct with 2" liner.
- 3.) Line all concealed duct with 1" liner.
- 4.) Wrap all concealed round pipe with R-value 6.0 insul sleeve.
- 5.) Clean and reuse as many existing office ceiling diffusers as possible
- 6.) Use 4" x 4" x 3/8" angle for unit support stand.
- 7.) Use 1/2" drop in anchors to anchor unit stand to concrete pad.
- 8.) Concrete pad for RTU 6" deep x 10'0" x 7'0".
- 9.) Concrete pad to be level.

Electrical Notes

- 1.) Existing electrical service to building is single phase. Owners RTU is three phase. Use phase converter to adapt existing electrical service.
- 2.) Demo existing 200 amp overhead electrical service.
- 3.) Supply and install a 400 amp single phase overhead service with 200 amp and 100 amp 2 pole breakers.
- 4.) Refore existing 200 amp panel inside building.
- 5.) Supply and install 100 amp single phase feeder to phase converter.
- 6.) Supply and install 20 kva phase converter in Nema 3R enclosure.
- 7.) Supply and install 100 amp 3 phase fused disconnect with 90 amp fuses next to phase converter.
- 8.) Supply and install feeders to disconnect and HVAC unit including final connections.
- 9.) Supply and install duct detector and indicator light as required by building code.
- 10.) Install power conv. Outlet for AC-1, powered separately from AC-1.

CITY OF GRAND JUNCTION
2529 HIGH COUNTRY COURT 81501

M-1

TEMPSTAR

WARNING

IMPROPER INSTALLATION, MAINTENANCE, OR REPAIR OF THIS UNIT CAN CAUSE PROPERTY DAMAGE OR INJURY. ALWAYS USE THE CORRECT TOOLS AND PROCEDURES. ALWAYS FOLLOW THE INSTRUCTIONS AND SAFETY WARNINGS. 










