


$\phi = 28^\circ$  | SILTY SAND or CLAYEY SAND


**LOAD CONDITION A** | NO LIVE LOAD SURCHARGE, NO BACK SLOPE, NO TOE SLOPE

**2 BLO2K HIGH SECTION**

(2) 28" (710 mm) Blocks

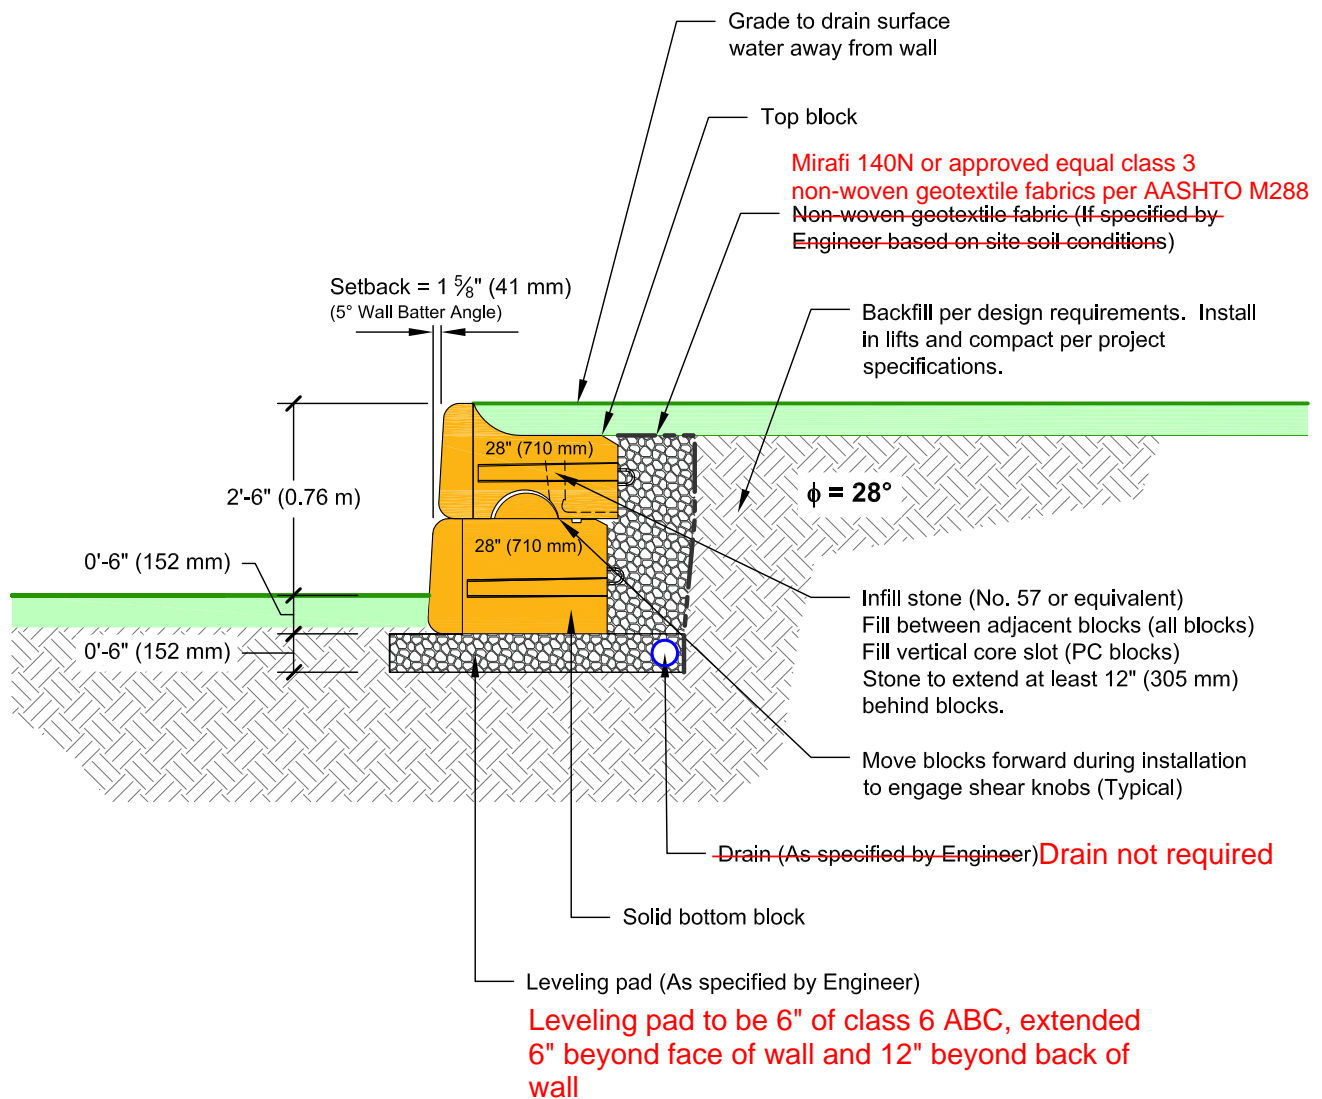

This drawing is for reference only. Determination of the suitability and/or manner of use of any details contained in this document is the sole responsibility of the design engineer of record. Final project designs, including all construction details, shall be prepared by a licensed professional engineer using the actual conditions of the proposed site. Final wall design must address both internal and external drainage and all modes of wall stability.

DRAWN BY: C. Kruger	TITLE: Preliminary Wall Section Silty Sand or Clayey Sand, $\phi = 28^\circ$ No Live Load Surcharge, No Back Slope, No Toe Slope	 05481 US 31 SOUTH, CHARLEVOIX, MI 49720 (866) 222-8400 ext 3010 • <a href="mailto:engineering@redi-rock.com">engineering@redi-rock.com</a> <a href="http://www.redi-rock.com">www.redi-rock.com</a>
APPROVED BY: J. Johnson		
DATE: June 10, 2015		
SHEET: 1 of 1		
FILE: A_28_B_28_36_cad.dwg		