

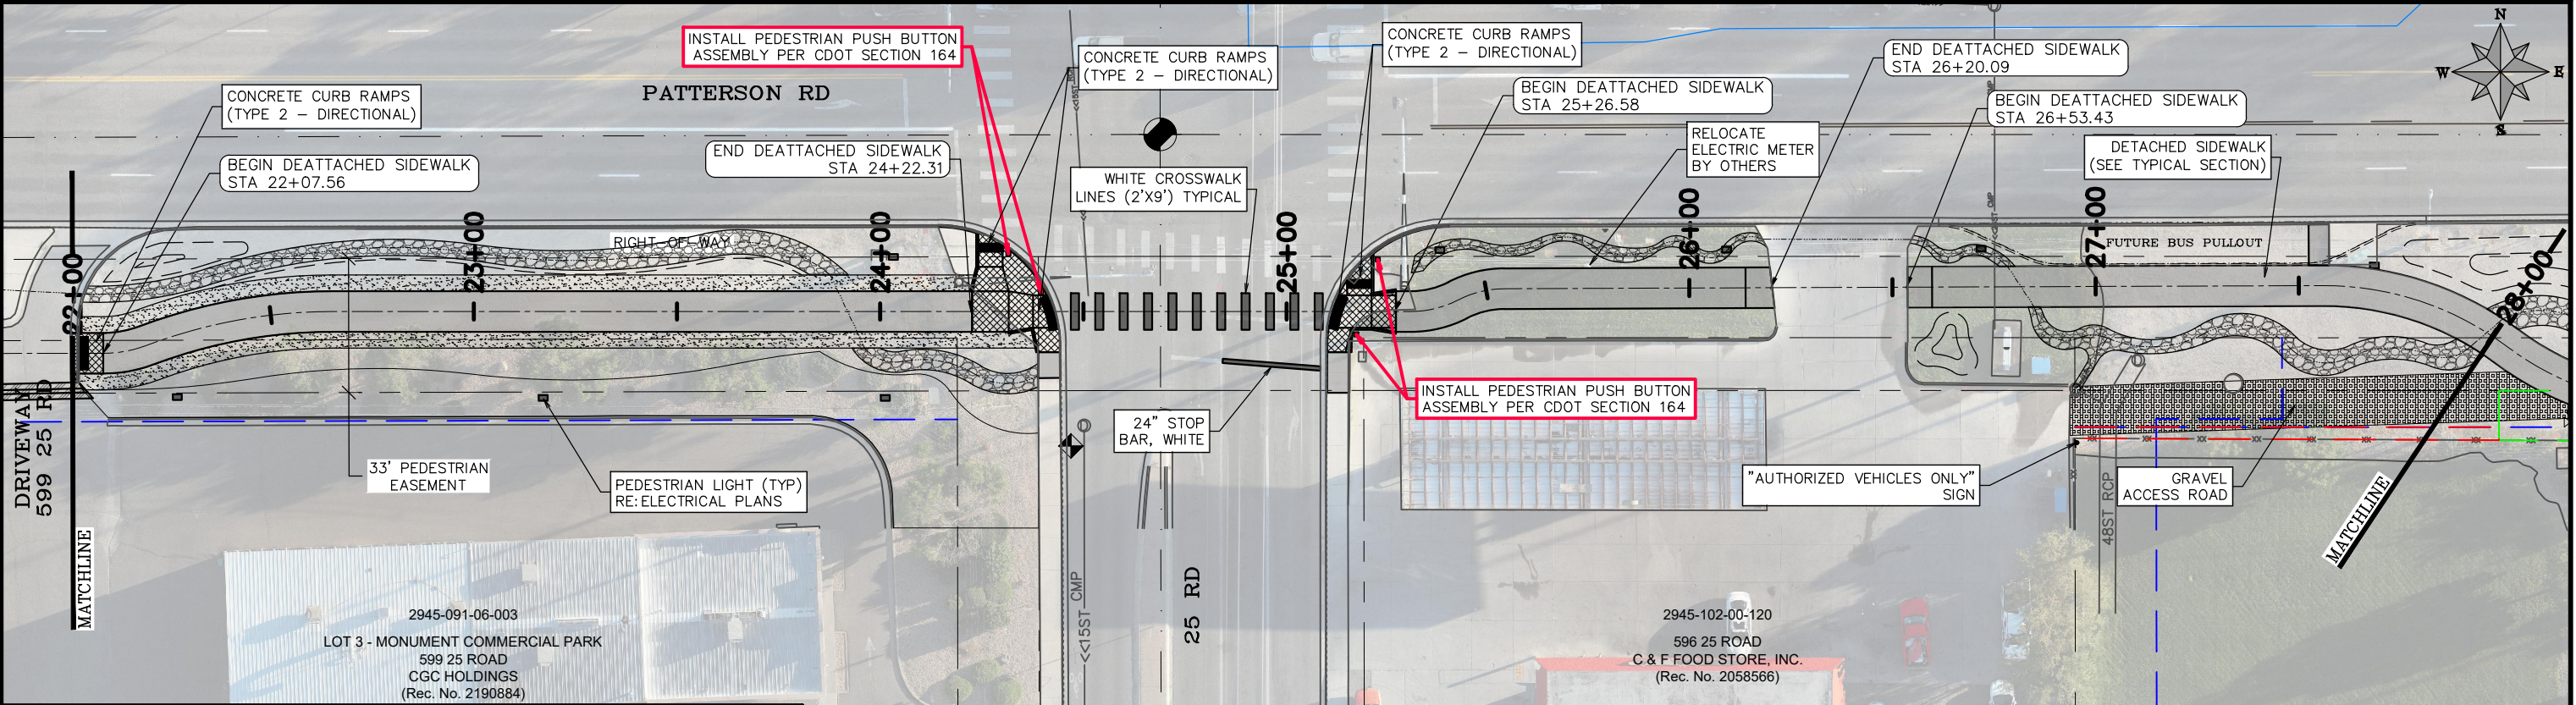


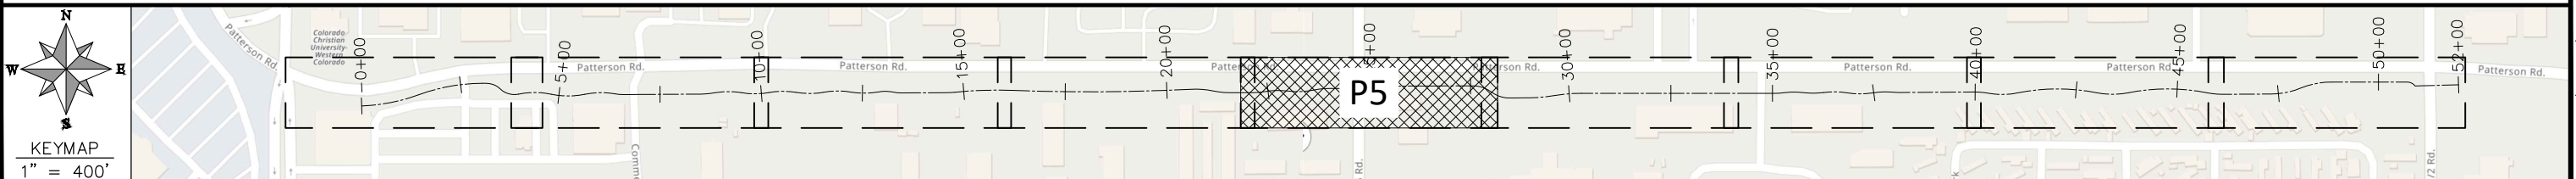


LEGEND			
	ASPHALT		GRAVEL SHOULDER
	CONCRETE RAMP		GRAVEL ACCESS ROAD
	CONCRETE		
	TEMPORARY CONSTRUCTION EASEMENT		EASEMENT
			SIDEWALK EASEMENT
			LANDSCAPE EASEMENT

CONTRACTOR TO VERIFY EXISTING
FLOWLINE ELEVATION AT TIE-IN
LOCATIONS PRIOR TO CONSTRUCTION

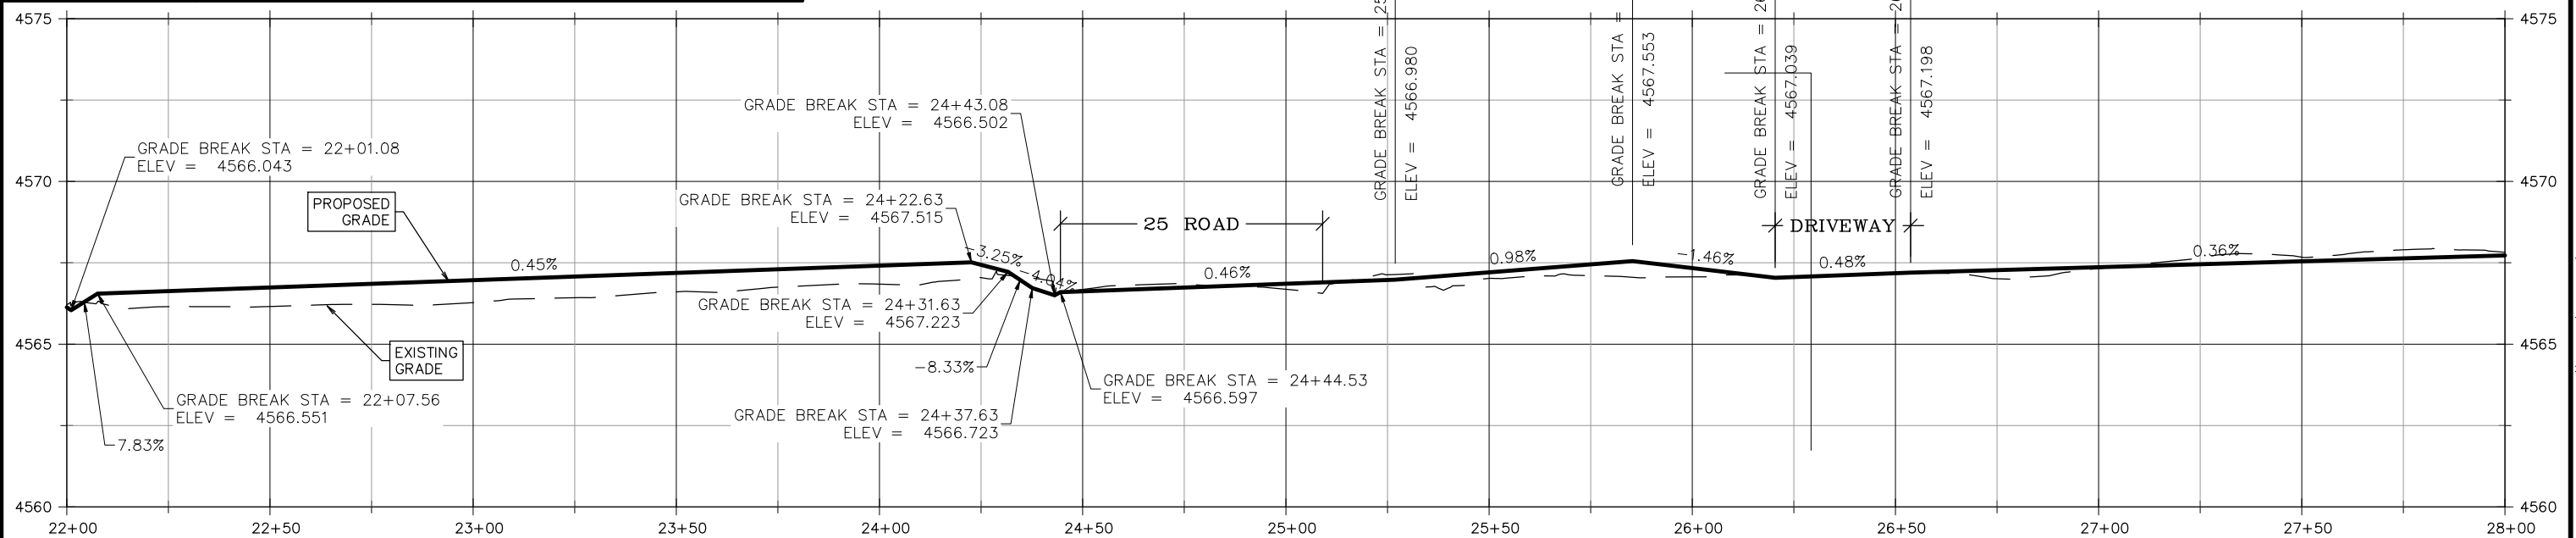

REVISION	DESCRIPTION	DATE	DRAWN BY	HMC	DATE	2025
REVISION A	UPDATED ANNOTATION	12/08/2025	DESIGNED BY	KH	DATE	2025
REVISION B			CHECKED BY	KH	DATE	2025
REVISION C			APPROVED BY	KH	DATE	2025

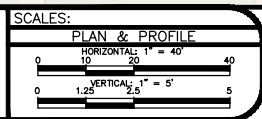

ENGINEERING AND
TRANSPORTATION DEPARTMENT
PROJECT NO. C1012

PATTERSON SIDEWALK
PLAN AND PROFILE - (P5)
December 12, 2025

N:\EngProj\TRANSPORTATION\C1012 (Patterson Trail 24half to 25half)\GOCAD\DESIGN\PLAN AND PROFILE\F2303.dwg - PLOTTED 12/12/2025 8:38:58 AM