

**BASE "ME2", "ME3" & "ME4"**

NO SCALE

**GENERAL SITE NOTES:**

- PROVIDE A SEPARATE GREEN INSULATED GROUND WIRE SIZED PER NATIONAL ELECTRICAL CODE TABLE 250.122 IN ALL BRANCH CIRCUIT AND FEEDER WIREWAYS CONTAINING POWER CONDUCTORS. GROUND WIRE IS NOT INCLUDED IN HACHURE COUNT ON DRAWINGS.
- ALL RACEWAYS INSTALLED UNDERGROUND, OR UNDER THE BUILDING SHALL BE NO SMALLER THAN 3/4". ALL CONDUCTORS INSTALLED UNDERGROUND OR UNDER THE BUILDING SHALL BE NO SMALLER THAN 1/2".
- WHERE 200 VOLT BRANCH CIRCUITS EXCEED 75', INCREASE WIRE SIZE TO #10, AND INCREASE RACEWAY SIZE TO 1".
- UNDERGROUND CONDUITS SHALL BE RUN IN A COMMON TRENCH AS MUCH AS POSSIBLE. POWER AND SIGNAL CONDUITS SHALL BE SEPARATED A MINIMUM OF 12". MAJOR CONDUIT RUNS SHOWN ON THIS PLAN. SEE BUILDING PLANS FOR ADDITIONAL SITE BRANCH CIRCUITS.
- ALL CONDUITS SHALL BE BURIED A MINIMUM OF 36" BELOW FINISHED GRADE. BED CONDUITS 6" BELOW AND 6" ABOVE IN LOCAL MATERIAL WITH NO ROCKS LARGER THAN 1" IN DIAMETER, OR IMPORT SAND IF ACCEPTABLE LOCAL MATERIAL IS UNAVAILABLE. PLACE WARNING TAPE 1'-0" ABOVE ALL BURIED CONDUITS. SEE L-LINE DIAGRAM FOR FEEDER CONDUIT SIZES. SEE SIGNAL RISERS FOR COMMUNICATION CONDUIT SIZES.
- SEE SPECIFICATIONS FOR ADDITIONAL CONSTRAINTS ON POWER AND COMMUNICATIONS SERVICES, AND OUTSIDE BRANCH CIRCUITS AND FEEDERS.

**NOTES REFERENCED ON THE PLANS:**

- RELOCATE EXISTING GENERATOR AND AUTOMATIC TRANSFER SWITCH FROM OLD ORCHARD MESA FIRE STATION. RECONNECT GENERATOR FOR 30' OUTPUT. ADD THIRD POLE TO AUTOMATIC TRANSFER SWITCH. ORIENT GENERATOR SO THAT AIR DISCHARGE FACES THE OPEN END OF THE ENCLOSURE. LOCATE CONDUIT STUB UPS PER EXISTING GENERATOR.
- ORIENT UTILITY TRANSFORMER SO THAT THE TERMINAL COMPARTMENT HAS A MINIMUM OF 8' CLEARANCE FOR HOT STICK OPERATIONS. LOCATE CONDUIT STUB UPS PER UTILITY COMPANY REQUIREMENTS.
- PANEL L1C FOR GENERATOR BATTERY CHARGER AND BLOCK HEATER. PROVIDE 3/4" PVC TO THE AUTOMATIC TRANSFER SWITCHES FOR THE GENERATOR START SIGNAL.
- PROVIDE 3" TELEPHONE CONDUIT, 1-1/2" CABLE SERVICE CONDUIT AND (2)-2" CONDUITS FOR FUTURE FIBER OPTIC CABLES.
- STUB 1 1/2" PVC POWER AND SIGNAL CONDUITS NORTH OF THE BUILDING FOR FUTURE STORAGE BUILDING.
- STUB 1-1/2" CONDUIT FROM SPRINKLER CONTROLLER IN IT ROOM TO VALVE BOX OUTSIDE THE BUILDING. COORDINATE LOCATION OF VALVE BOX WITH SPRINKLER SYSTEM INSTALLER.
- REPLACE 90 AMP 2 POLE GENERATOR OUTPUT BREAKER WITH 70 AMP 3 POLE.
- CONFIRM PEDESTAL LOCATIONS WITH UTILITY COMPANIES PRIOR TO RUNNING CONDUIT.

**CHAMBERLIN ARCHITECTS**  
C H A M B E R L I N  
A R C H I T E C T S  
E N H A N C I N G E V E R Y D A Y L I V I N G T H R O U G H D E S I G N

**CHAMBERLIN ARCHITECTS**  
437 Main St.  
Grand Junction, Colorado 81501  
T 970.242.6804  
725 Saint Joseph St., Suite B1  
Rapid City, South Dakota 57701  
T 605.355.6804  
www.chamberlinarchitects.com


**GVCS**  
GRAND VALLEY ENGINEERING SOLUTIONS  
ELECTRICAL CONSULTING ENGINEERS  
2961 CIRCLING HAWK COURT, GRAND JUNCTION, CO 81503  
(970) 256-0353 FAX: (970) 245-6319


## ORCHARD MESA FIRE STATION #4

GRAND JUNCTION, COLORADO

## LEGEND, SITE PLAN, ONE LINE & DETAILS

NO: ISSUED FOR: DATE:  
 □ □ □ □ □  
 PROJECT STATUS: 100% CD  
 DRAWN BY: KLT CHECKED BY: WLM  
 DATE: 04/10/2015 SHEET NO:  
 E101

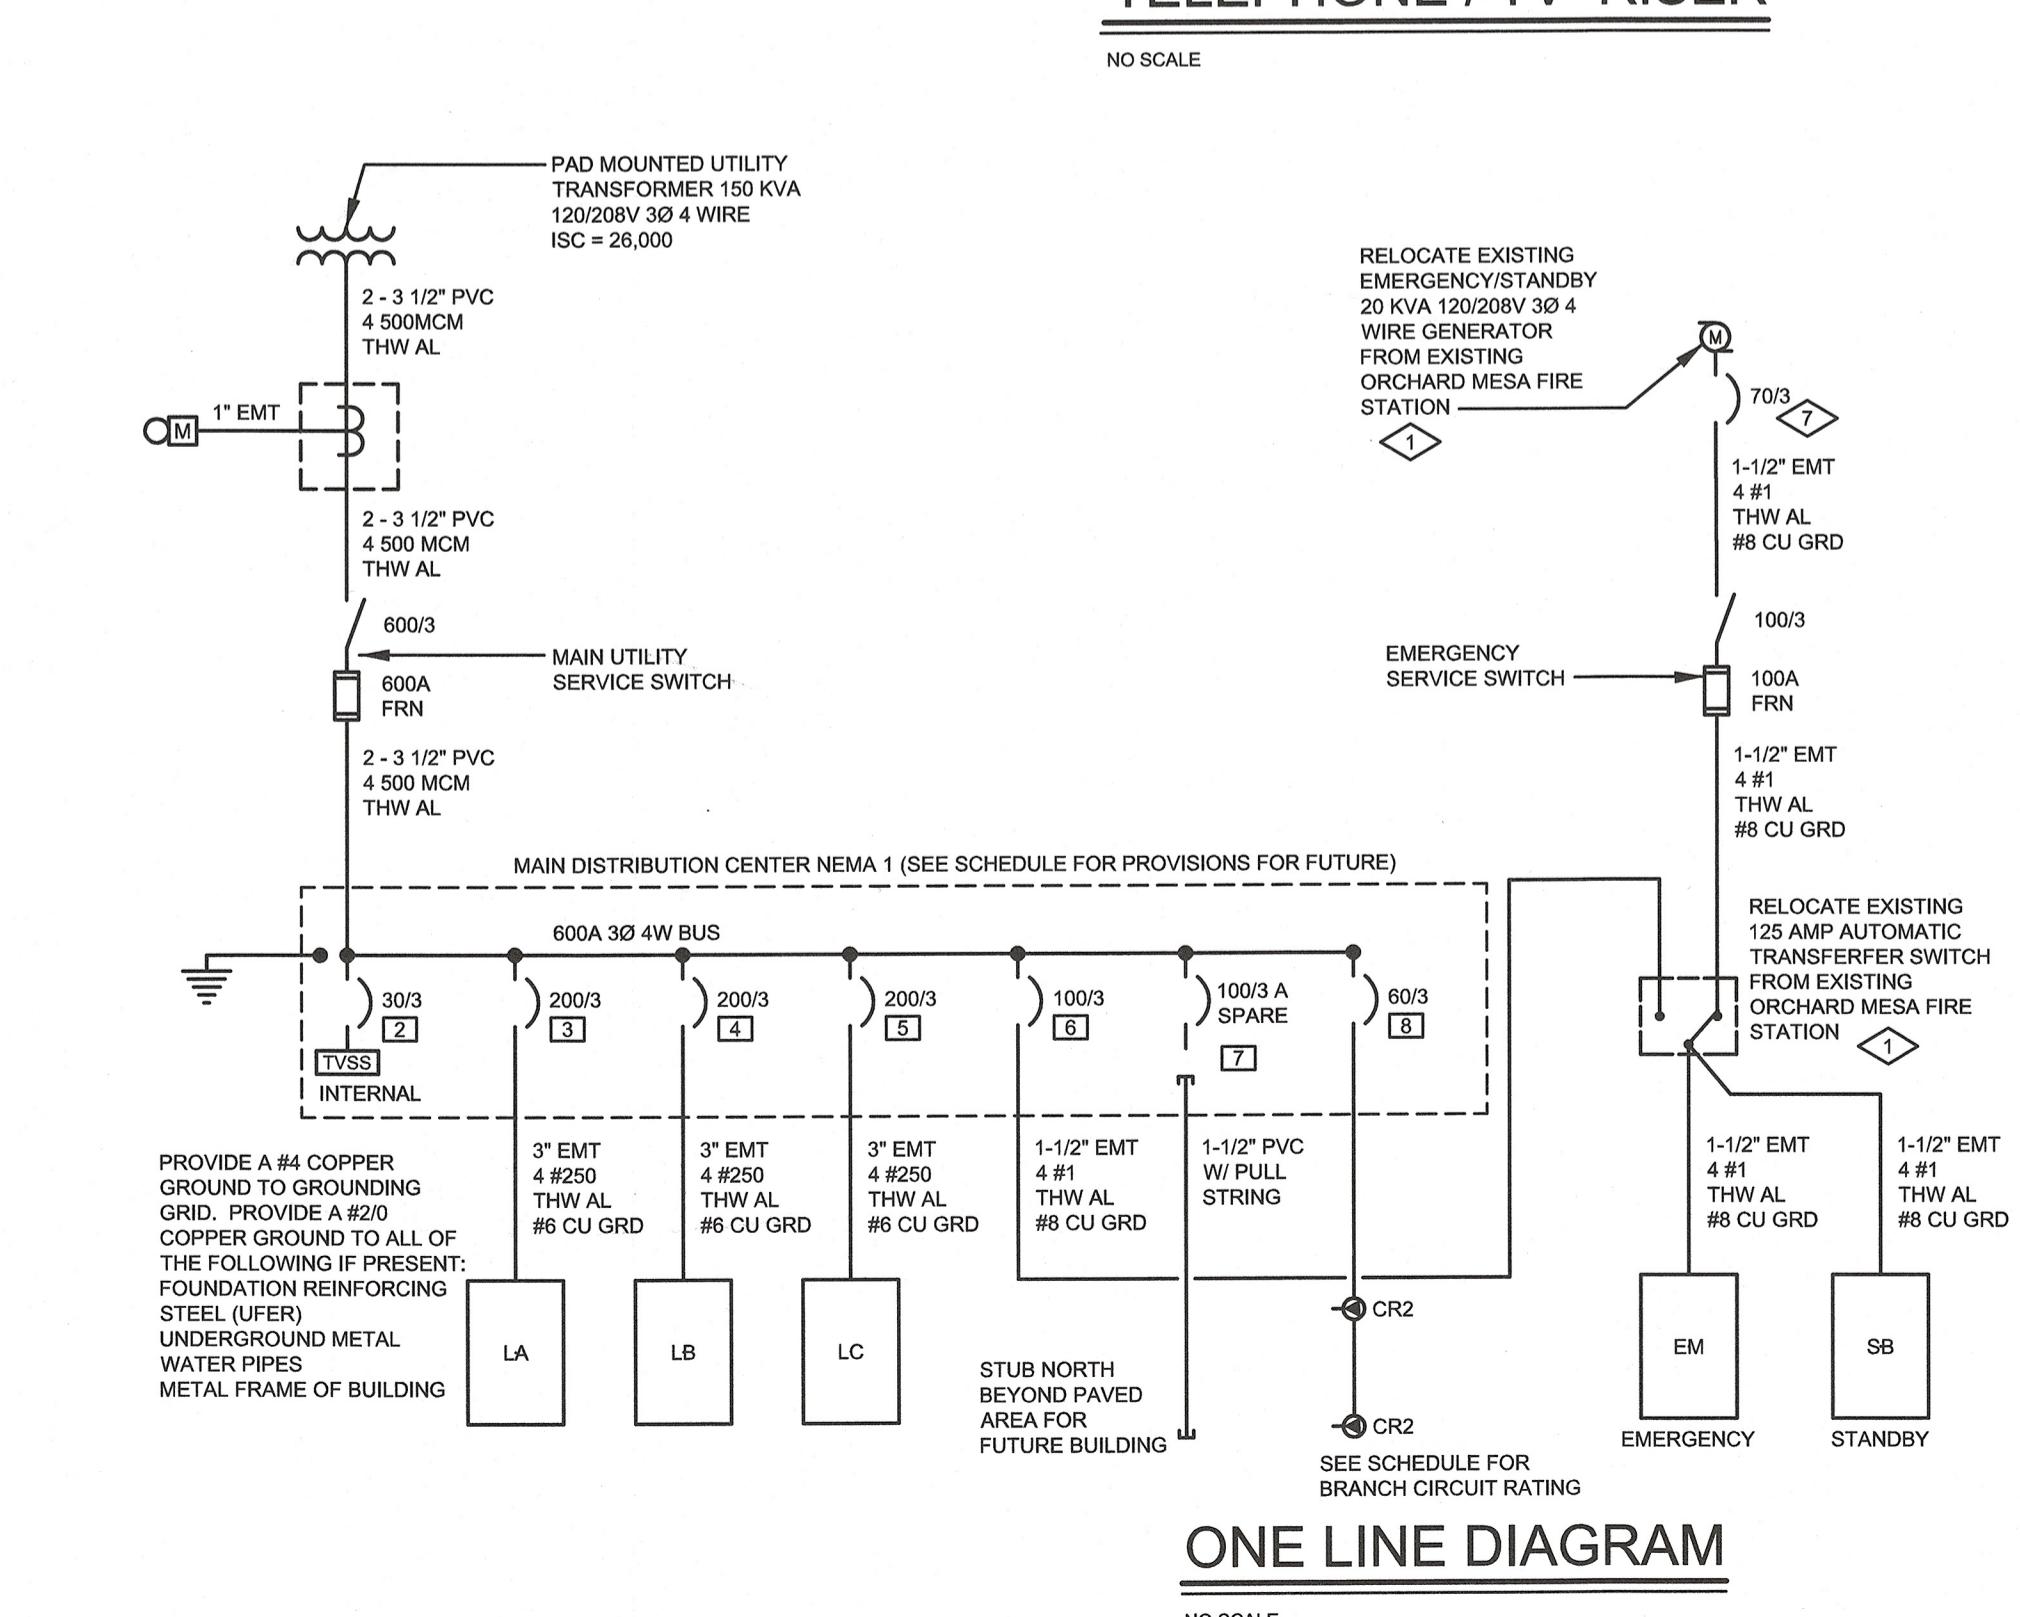

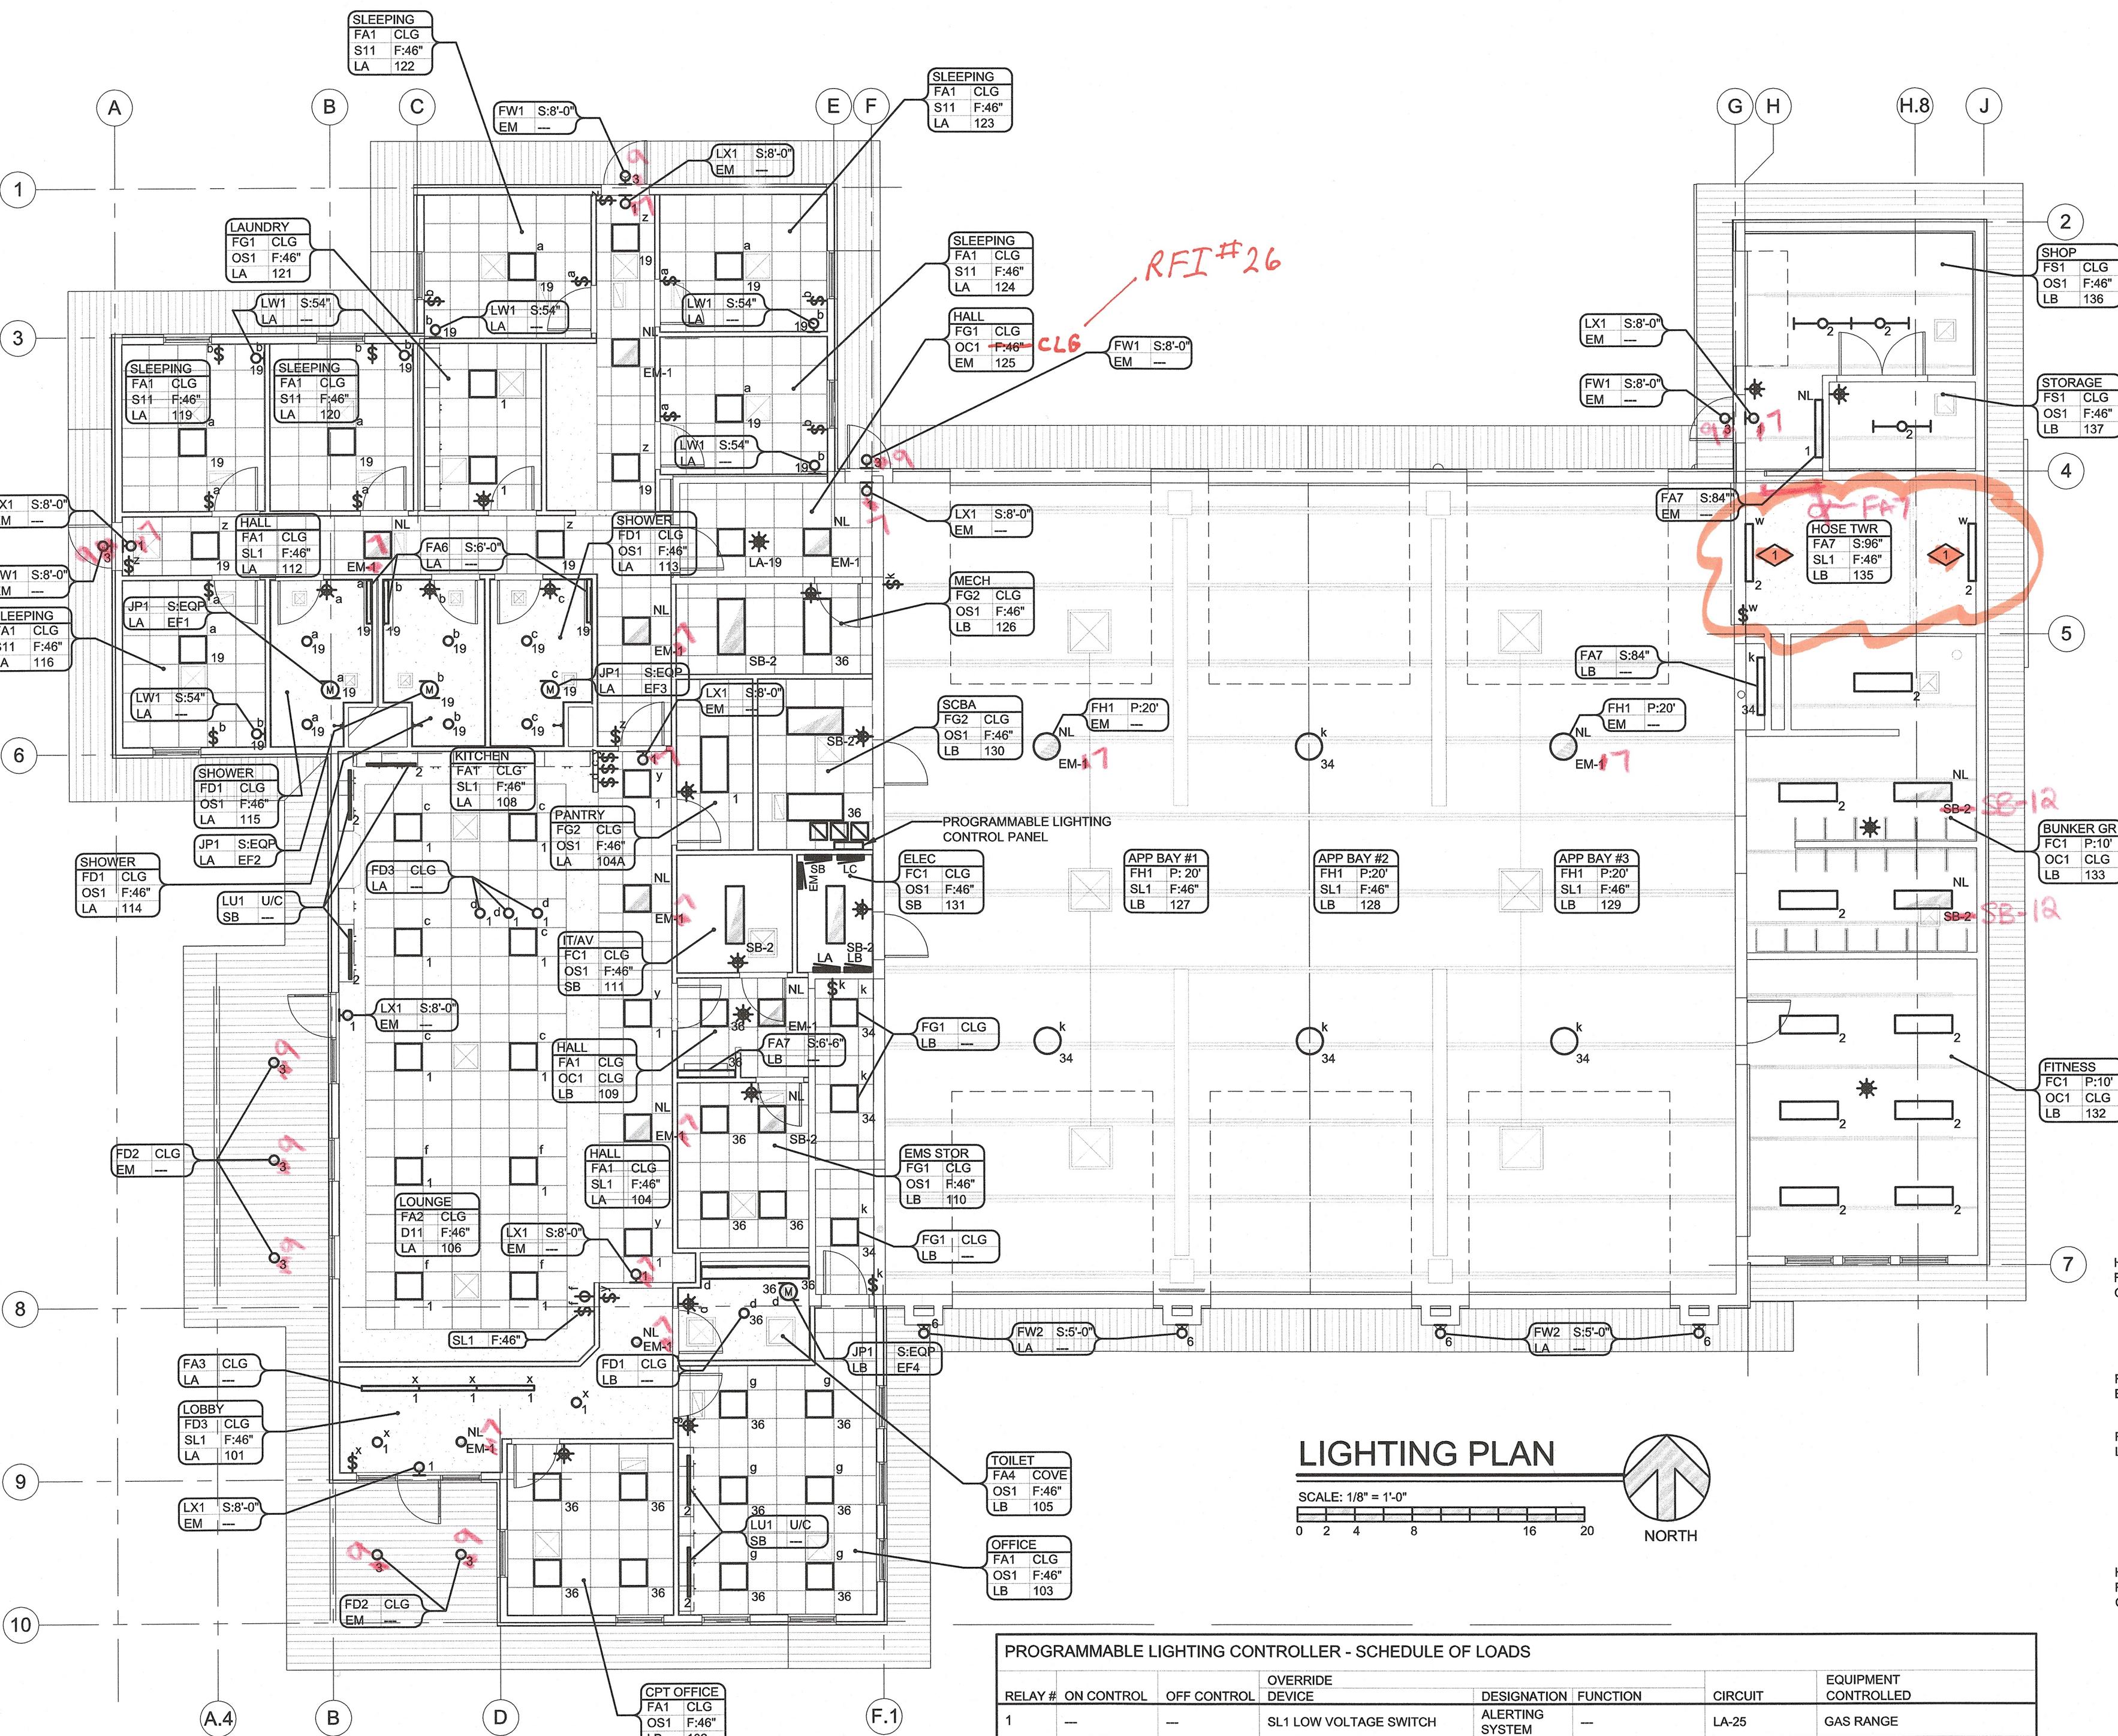


LIGHTING PLAN  
SCALE: 1/8" = 1'-0"  
NORTH

PROGRAMMABLE LIGHTING CONTROLLER - SCHEDULE OF LOADS

RELAY #	ON CONTROL	OFF CONTROL	OVERIDE DEVICE	DESIGNATION	FUNCTION	CIRCUIT	EQUIPMENT CONTROLLED
1	—	—	SL1 LOW VOLTAGE SWITCH	ALERTING SYSTEM	—	LA-25	GAS RANGE
2	7:00AM MON-SUN	8:00 PM MON-SUN	SL1 LOW VOLTAGE SWITCH	* z *	2 HOUR OVERRIDE ON/OFF	LA-19	HALL 112 @ SLEEPING ROOMS
3	7:00AM MON-SUN	10:00 PM MON-SUN	SL1 LOW VOLTAGE SWITCH	* y *	2 HOUR OVERRIDE ON/OFF	LA-1	HALL 104 @ KITCHEN & DINING
4	7:00AM MON-SUN	6:00 PM MON-SUN	SL1 LOW VOLTAGE SWITCH	* x *	2 HOUR OVERRIDE ON/OFF	LA-1	LOBBY
5	7:00AM MON-SUN	8:00 PM MON-SUN	SL1 LOW VOLTAGE SWITCH	* k *	2 HOUR OVERRIDE ON/OFF	EM-1	APPARATUS BAY LIGHTING
6	—	6:00 PM MON-SUN	—	* w *	2 HOUR OVERRIDE ON/OFF	LB-2	HOSE TOWER LIGHTS
7	DUSK	DAWN	—	—	—	LA-6	EXTERIOR LIGHTING DUSK TO DAWN (BUILDING)
8	DUSK 6:00 AM	10:00 PM MON-SUN	—	—	—	LA-2	PARKING LOT LIGHTING DUSK TO TIMED OFF
9	DOOR OPENS ON ALARM	—	ALERTING SYSTEM	—	—	SB-1	APPATATUS BAY DOOR
10	DOOR OPENS ON ALARM	—	ALERTING SYSTEM	—	—	SB-3	APPATATUS BAY DOOR
11	DOOR OPENS ON ALARM	—	ALERTING SYSTEM	—	—	SB-5	APPATATUS BAY DOOR
12	DUSK	10:00 PM	ALERTING SYSTEM	—	—	LA-2	ENTRY DRIVE TYPE ME4' LIGHTS
13	—	10:00 PM MON-SUN	SL1 LOW VOLTAGE SWITCH	* c *	ON/OFF	LA-1	KITCHEN LIGHTS
14	—	12:00 PM MON-SUN	SL1 LOW VOLTAGE SWITCH	* d *	ON/OFF	LA-1	KITCHEN LIGHTS
15	—	12:00 PM MON-SUN	SL1 LOW VOLTAGE SWITCH	* f *	ON/OFF	LA-1	LOUNGE
16	SPARE	—	—	—	—	—	—

CONFIRM SCHEDULE WITH OWNER BEFORE PROGRAMMING CONTROLLER

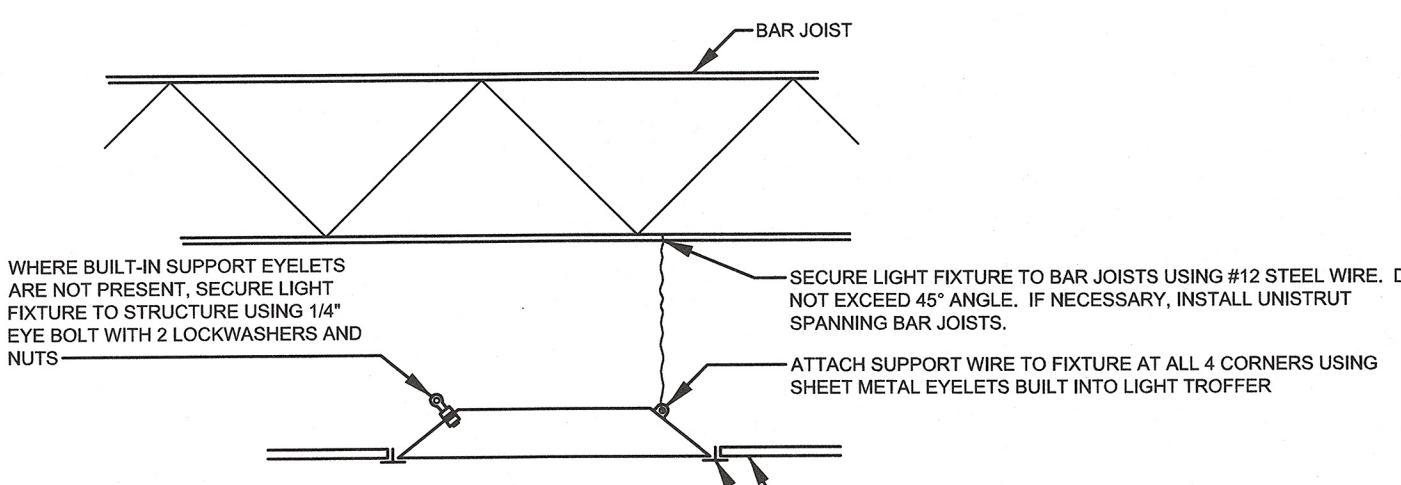


### SEISMIC SUPPORT OF LIGHT TROFFERS

NO SCALE

NOTES REFERENCED ON THE PLANS:

1. PROVIDE ONE TYPE "FA7" FIXTURE AT EACH STAIR LANDING. MOUNT FIXTURES 8'-0" ABOVE STAIR LANDING.

SEE RFI #24

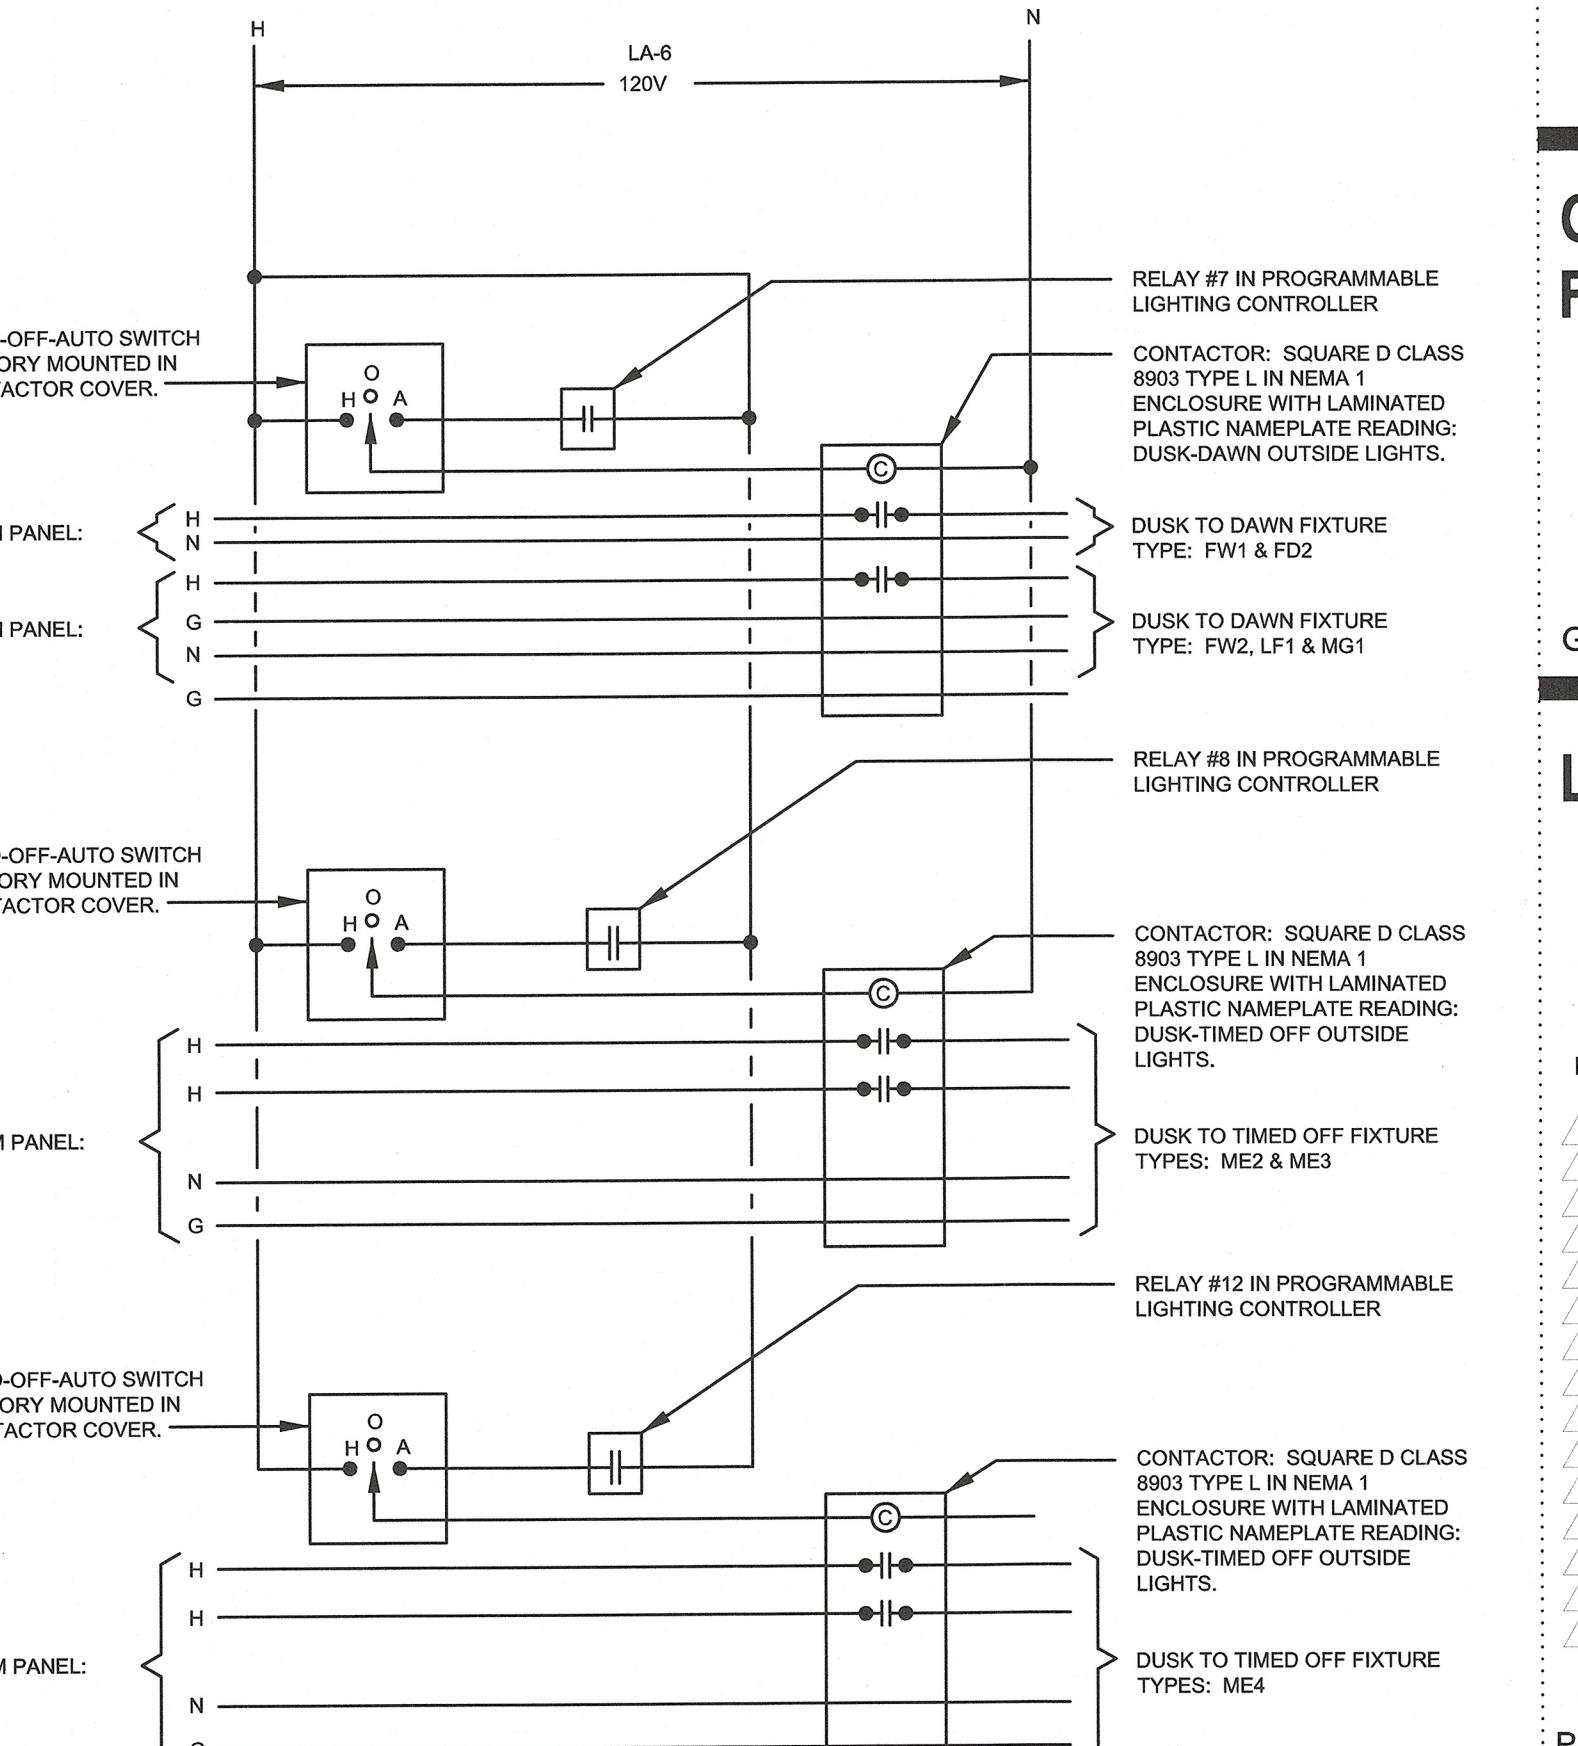

### EXTERIOR LIGHTING CONTROL

NO SCALE

## ORCHARD MESA FIRE STATION #4

GRAND JUNCTION, COLORADO

## LIGHTING PLAN

NO: ISSUED FOR: DATE:




PROJECT STATUS: 100% CD

DRAWN BY: KLT CHECKED BY: WLM

DATE: 04/10/2015 SHEET NO:

PROJECT NO: 1443/140330 E201

2012 Chamberlin Architects

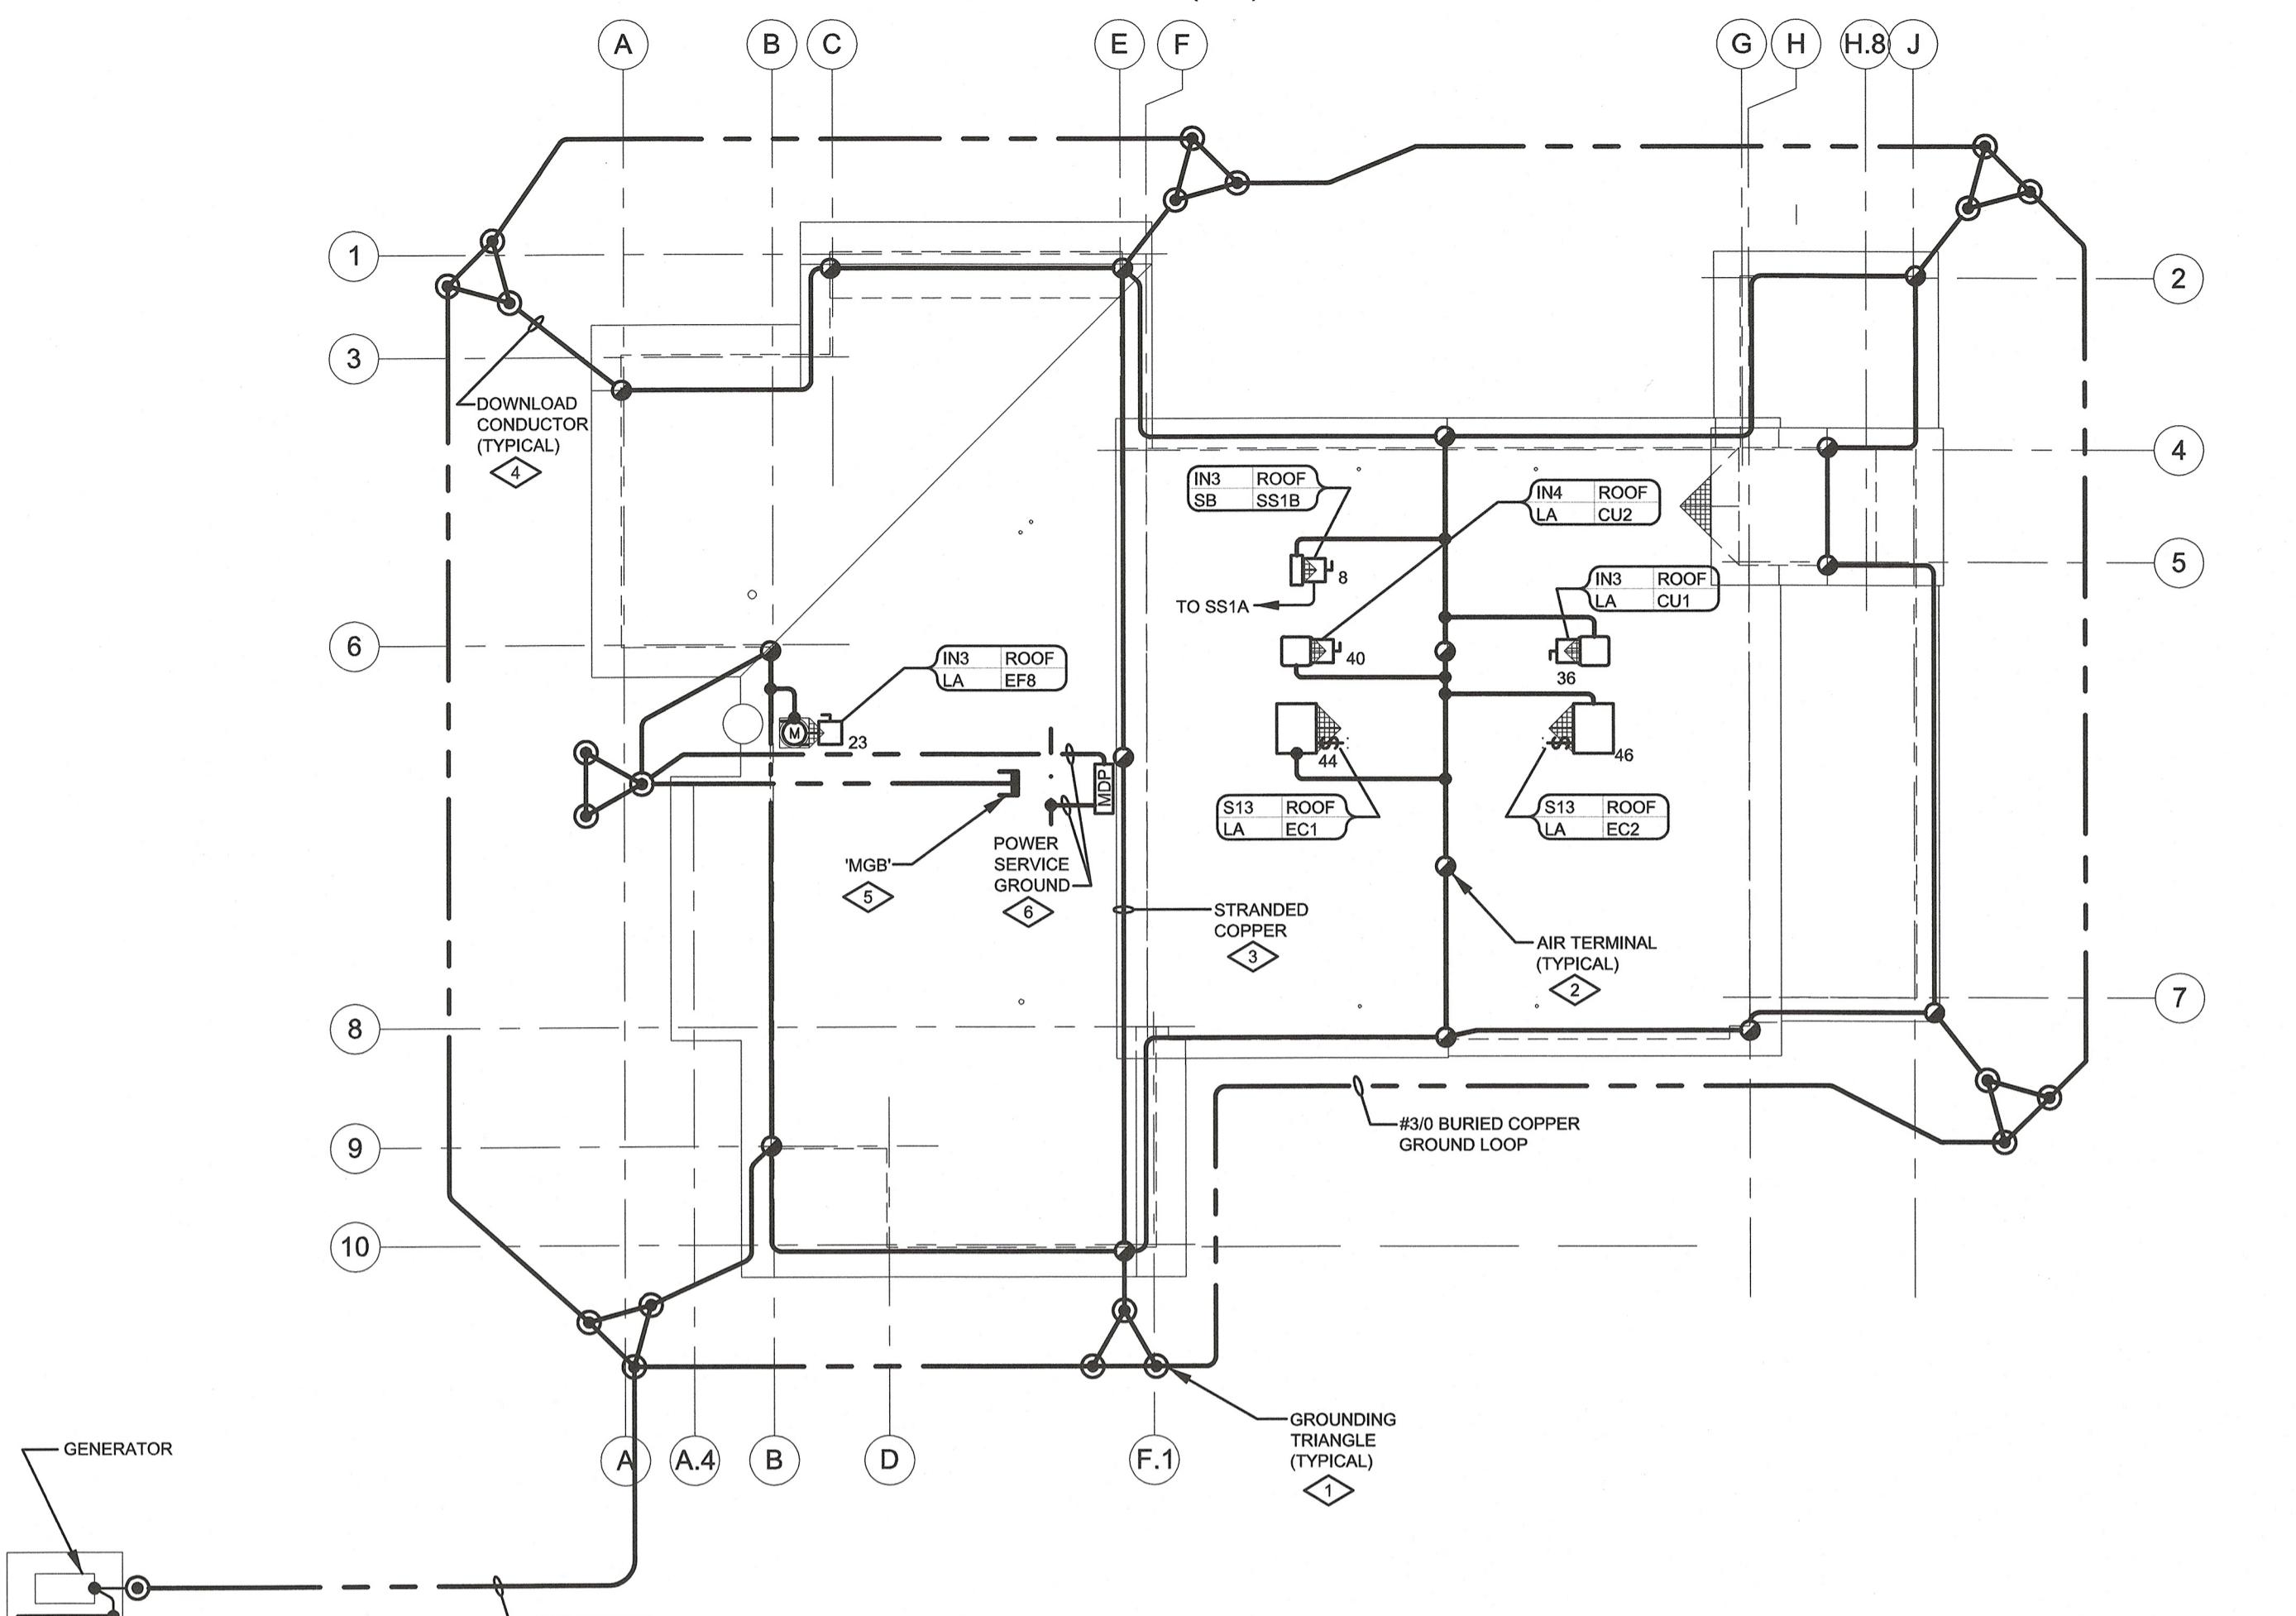

### LIGHTNING PROTECTION / ROOF PLAN

SCALE: 1/16" = 1'-0"  
0 4 8 16 32 40



SITE LIGHTING SCHEDULE										
LIGHTING FIXTURE			LAMP		BALLAST / DRIVER TYPE 1		BALLAST / DRIVER TYPE 2		DESCRIPTION	
DESCRIPTION	MANUFACTURER CATALOG # FIRST HALF	MANUFACTURER CATALOG # SECOND HALF	MOUNTING AIMING	QUANTITY - TYPE	MANUFACTURER CATALOG NUMBER	STARTING METHOD	BALLAST FACTOR	STARTING METHOD	BALLAST FACTOR	
DIMENSIONS	APPROVED ALTERNATES	HOUSING MATERIAL	REFLECTOR HOUSING FINISH	CATALOG NUMBER	CATALOG NUMBER	INSTANT	HARMONICS	INSTANT	HARMONICS	
LF1 L.E.D: FLOOD LIGHT 3.14" H X 8.8" W X 24.8" L	HUBBELL AFL-12LU-5K-BZ — LITHONIA, METALUX CAST ALUMINUM	GROUND ADJUSTABLE TEMPERED GLASS — DARK BRONZE	SELECTED BY FIXTURE MANUFACTURER SELECTED BY FIXTURE MANUFACTURER	1 - 22 WATT LED ARRAY 1000 L ≥82	5100 DEG K ≥50,000 HOURS	1 - STANDARD LED DRIVER SELECTED BY FIXTURE MANUFACTURER SELECTED BY FIXTURE MANUFACTURER	— ≥1.00 ≤20%	SECOND BALLAST / DRIVER TYPE NOT REQUIRED — — —	— — —	LF1: L.E.D: FLOOD LIGHT 120 V 22 W ENVIRONMENT: -20F TO 120 DEG F & WET.
ME2 METAL HALIDE: CUT-OFF: 22" H X 25" W X 25" L X 25" DIA	KIM 1A RA252 250PMH BL HA12 L-TMI CAL16-641188 BL-P ANTIQUE ST LIGHT, AAL ALUMINUM	16' POLE CUT-OFF — HYDROFORMED BLACK	1 - 250 W CLEAR PULSE START MXR/250/U/MED 13300 L ≥60	3900 DEG K ≥12,000 HOURS	1 - H.I.D.: CORE & COIL PULSE START SELECTED BY FIXTURE MANUFACTURER PULSE -20 DEG F	INSTANT ≥80 ≥20%	— — —	SECOND BALLAST / DRIVER TYPE NOT REQUIRED — — —	— — —	ME2: METAL HALIDE: CUT-OFF 208 V 290W W ENVIRONMENT: -20F TO 120 DEG F & WET. PROVIDE STEPPED ALUMINUM 16' POLE AND BRACHT ARM. PROVIDE TYPE II DISTRIBUTION.
ME3 METAL HALIDE: CUT OFF: 22" H X 25" W X 25" L X 25" DIA	KIM 1A RA254 250PMH BL HA12 L-TMI CAL16-641188 BL-P ANTIQUE ST LIGHT, AAL ALUMINUM	16' POLE CUT-OFF — HYDROFORMED BLACK	1 - 250 W CLEAR PULSE START G.E. MXR/250/U/MED 13300 L ≥60	3900 DEG K ≥12,000 HOURS	1 - H.I.D.: CORE & COIL PULSE START SELECTED BY FIXTURE MANUFACTURER PULSE -20 DEG F	INSTANT ≥80 ≥20%	— — —	SECOND BALLAST / DRIVER TYPE NOT REQUIRED — — —	— — —	ME3: METAL HALIDE: CUT OFF 208 V 290W W ENVIRONMENT: -20F TO 120 DEG F & WET. PROVIDE 16' STEPPED ALUMINUM 16' POLE AND BRACHT ARM. PROVIDE TYPE IV DISTRIBUTION.
ME4 METAL HALIDE: CUT OFF: 16.5" H X 17" W X 17" L X 17" DIA	KIM 1A RA172 150PMH BL HA12 S-TMI CAL16-534188 BL-P ANTIQUE ST LIGHT, AAL ALUMINUM	16' POLE CUT-OFF — HYDROFORMED BLACK	1 - 150 W CLEAR PULSE START G.E. MXR/150/U/MED 13300 L ≥65	3400 DEG K ≥15,000 HOURS	1 - H.I.D.: CORE & COIL PULSE START SELECTED BY FIXTURE MANUFACTURER PULSE -20 DEG F	— ≥80 ≥20%	— — —	SECOND BALLAST / DRIVER TYPE NOT REQUIRED — — —	— — —	ME4: METAL HALIDE: CUT OFF 208 V 185W W ENVIRONMENT: -20F TO 120 DEG F & WET. PROVIDE 6' STEPPED ALUMINUM 16' POLE AND BRACHT ARM. PROVIDE TYPE II DISTRIBUTION.
MG1 METAL HALIDE: FLUORESCENT 20" H X 12" W X 12" L	HYDREL M9720 SS 150W *** CP FLC 125 GARDCO, SPALDING CAST ALUMINUM	GROUND ADJUSTABLE CLEAR HYDROFORMED NATURAL ALUMINUM	1 - 150W CLEAR PULSE START G.E. MXR/150/U/MED 13300 L ≥70	3200 DEG K ≥12,000 HOURS	1 - H.I.D.: ELECTRONIC PULSE START ADVANCE 127EMH70EPS-F PULSE -20 DEG F	— ≥1.00 ≥20%	— — —	SECOND BALLAST / DRIVER TYPE NOT REQUIRED — — —	— — —	MG1: METAL HALIDE: FLOODLIGHT 120 V 210 W ENVIRONMENT: -20F TO 120 DEG F & WET. IN GRADE ADJUSTABLE FLOOD LIGHT.

### LIGHTNING PROTECTION NOTES:

- 1 PROVIDE LIGHTNING PROTECTION AND GROUNDING PER NFPA 780, AND IN ACCORDANCE WITH THESE SPECIFICATIONS AND PER MOTOROLA R56- STANDARDS AND GUIDELINES FOR COMMUNICATIONS SITES. WORK SHALL BE SUBCONTRACTED TO A NATIONAL LIGHTNING PROTECTION DESIGN BLD VENDOR.
- 2 GROUND RODS TO BE DRIVEN BY HAND SLEDGING, SLIDE HAMMER, OR POWER DRIVER TO THE RING WIRE DEPTH, UTILIZING A GROUND ROD DRIVING SHIELD TO PREVENT MUSHROOMING OF THE TOPS OF THE RODS.
- 3 WHERE GROUND RODS CANNOT BE DRIVEN VERTICALLY, DRIVE PARALLEL TO OR AWAY FROM EXTERIOR WALL, ANGLE SHALL NOT EXCEED 45°.
- 4 GROUND RODS ARE TO BE DRIVEN IN UNDISTURBED OR THOROUGHLY COMPACTED FILL AREAS.
- 5 DO NOT DRIVE OR LAY RODS IN GRAVEL BEDS WHICH ARE USED FOR DRAINAGE, UNLESS THE RODS EXTEND THROUGH SUCH BEDS FAR ENOUGH TO PROVIDE AT LEAST 8'-0" OF CONTACT WITH THE UNDISTURBED EARTH UNDERNEATH.
- 6 BEFORE BACK FILLING THE GROUNDING ELECTRODE SYSTEM, AN ELECTRICAL CONTINUITY CHECK SHALL BE MADE, AT THIS TIME TO ENSURE THAT ALL CONNECTIONS ARE INTACT. A WRITTEN RECORD OF THIS CHECK, WITH PHOTOS, SHALL BE PLACED IN THE OFFICE RECORDS FOR FUTURE REFERENCE.
- 7 AFTER BACK FILLING AND COMPACTING, AN EARTH RESISTIVITY MEASUREMENT SHALL BE MADE ON THE EXTERIOR GROUND RING SYSTEM PRIOR TO CONNECTION TO THE BUILDING GROUND SYSTEM. THE READING SHALL BE 5 OHMS OR LESS AND BE INCLUDED IN THE OFFICE RECORDS FOR FUTURE REFERENCE.
- 8 ALL GROUNDING CABLE IN CONCRETE OR THROUGH WALLS SHALL BE IN 1" PVC CONDUIT. NO METALLIC CONDUIT SHALL BE USED FOR GROUNDING CONDUCTOR SLEEVES.
- 9 ALL REINFORCING STEEL AND ALL OTHER EMBEDDED METALLIC ITEMS SHALL BE GROUNDED PER THE NEC AND ALL LOCAL ELECTRICAL CODES.
- 10 WHERE MECHANICAL CONNECTORS (TWO HOLE OR CLAMP) ARE USED, APPLY A LIBERAL PROTECTIVE COATING OF AN ANTI-OXIDE COMPOUND SUCH AS "NO OXIDE" BY DEARBORN CHEMICAL COMPANY ON ALL CONNECTORS. PROVIDE LOCWSHERS ON ALL CONNECTORS. USE STAINLESS STEEL CONNECTORS WHERE POSSIBLE. THOROUGHLY REMOVE ALL PAINT AND CLEAN ALL DIRT FROM SURFACES REQUIRING GROUND CONNECTIONS, REPAINT TO MATCH EXISTING AFTER CONNECTION IS MADE TO MAINTAIN CORROSION RESISTANCE. ALL GROUND CONNECTIONS SHALL BE APPROVED FOR THE TYPES OF METALS BEING ATTACHED TO.
- 11 FURNISH AND INSTALL ALL MATERIALS AND LABOR REQUIRED TO PROVIDE A COMPLETE FUNCTIONAL LIGHTNING PROTECTION AND COMMON GROUND SYSTEM FOR THE BUILDING AS SHOWN AND DETAILED ON THE PLANS.
- 12 ALL MATERIALS FOR THIS SYSTEM SHALL BE NEW AND THE STANDARD PRODUCT OF A MANUFACTURER REGULARLY ENGAGED IN THE PRODUCTION OF LIGHTNING PROTECTION SYSTEMS AND SHALL BE OF THE LATEST APPROVED DESIGNS. EQUIPMENT SHALL BE UL LISTED.
- 13 SYSTEM MATERIALS IN GENERAL SHALL BE COPPER AND HIGH COPPER-CONTENT BRONZE CASTINGS, AND SHALL COMPLY IN WEIGHT, SIZE, AND COMPOSITION FOR THE CLASS OF STRUCTURE TO BE PROTECTED. THE SYSTEM SHALL CONSIST OF ALL NECESSARY CABLES, AIR TERMINALS, MOUNTING BASES, FITTINGS, COUPLINGS, CONNECTORS, FASTENERS, ETC., AS REQUIRED TO GIVE A COMPLETE AND COORDINATED SYSTEM. ALL CABLE AND ALL AIR TERMINALS SHALL BEAR PROPER UL LABELS.
- 14 ALL SYSTEM FITTINGS EXCEPT CABLE HOLDERS, REGARDLESS OF STRUCTURE CLASSIFICATION SHALL BE HEAVY-DUTY TYPE MADE FROM BRONZE CASTINGS AND SECURED WITH BOLTED-PRESSURE CLAMPS. PRESSURE PLATED MADE FROM STAMPED OR PRESSED METAL PARTS, OR FITTINGS UTILIZING CRIMP-TYPE PRESSURE DEVICES WILL NOT BE ALLOWED. ALL BOLTS, SCREWS AND RELATED TYPE HARDWARE SHALL BE 300 SERIES STAINLESS STEEL. ALL CABLE TO CABLE, CABLE TO LUG, CABLE TO GROUND ROD, AND CABLE TO STRUCTURAL STEEL CONNECTIONS SHALL BE EXOTHERMICALLY WELDED OR ACCEPTED EQUIVALENT. CONTRACTOR SHALL NOTIFY ENGINEER WHERE CONNECTIONS CANNOT BE USED.
- 15 A COMMON GROUND SHALL BE PROVIDED BETWEEN THE LIGHTNING PROTECTION SYSTEM AND THE BUILDING ELECTRIC AND TELEPHONE SERVICE GROUNDS. IN ADDITION, ALL UNDERGROUND METALLIC PIPING SYSTEMS SHALL BE BONDED WITH FULL SIZE CONDUCTOR; INCLUDING WATER, GAS, SEWER, AND ANY OTHER PIPING SYSTEM, AT POINTS WHERE THESE PIPING SYSTEMS ENTER THE BUILDING. BONDING OF UTILITY PIPING SYSTEMS IS SUBJECT TO THEIR COOPERATION AND APPROVAL.
- 16 BONDING OF ALL METALLIC OBJECTS AND SYSTEMS AT ROOF LEVELS AND ELSEWHERE ON THE STRUCTURE SHALL BE COMPLETE. PRIMARY BONDS FOR METAL BODIES OF CONDUCTANCE SHALL BE BONDED WITH APPROPRIATE FITTINGS AND CONDUCTOR; AND SHALL CONSIST OF, BUT NOT BE LIMITED TO, THE FOLLOWING: ROOF EXHAUST FAN, ETC. EXTERIOR ARCHITECTURAL METAL ASIA AND/OR CURTAIN WALLS OR MULLIONS, WHICH EXTEND THE FULL HEIGHT OF THE STRUCTURE SHALL ALSO BE BONDED, IF NOT INHERENTLY BONDED THROUGH THE BUILDING FRAME.

### NOTES REFERENCED ON THE PLANS:

- ① PROVIDE 5/8" X 10'-0" COPPER CLAD GROUND RODS AT LOCATIONS SHOWN. INSTALL GROUND RODS IN A TRIANGULAR CONFIGURATION 8'-0" ON A SIDE.
- ② PROVIDE AIR TERMINAL ON ROOF AS INDICATED. AIR TERMINALS SHALL BE SOLID, 5/8" DIAMETER ROUND COPPER BAR, FULL NICKEL PLATED, AND OF SUFFICIENT LENGTH TO PROJECT 10" MINIMUM ABOVE THE OBJECT TO BE PROTECTED, AND UL LABELED. SPACING SHALL NOT EXCEED 20'-0" BETWEEN TERMINALS ALONG PEAKS. PROVIDE MASTIC COMPATIBLE WITH ROOF AND ALL NECESSARY HARDWARE TO SECURELY MOUNT AIR TERMINALS IN A PERMANENT AND RIGID MANNER. COORDINATE WITH ROOF INSTALLER FOR PROVIDING AN ADDITIONAL 12" X 12" PIECE OF ROOF MEMBRANE AT EACH TERMINAL LOCATION, DO NOT PENETRATE ROOF MEMBRANE.
- ③ PROVIDE IPC32S STRANDED COPPER, OR APPROVED EQUIVALENT, SIZED BY THE LIGHTNING PROTECTION DESIGN VENDOR FOR INTERCONNECTING CONDUCTORS. ROUTE ALONG ROOF BETWEEN TERMINALS AS INDICATED. SECURE CONDUCTORS TO ROOF WITH APPROVED FASTENERS, SPACED 3'-0" MAXIMUM. COORDINATE WITH ROOF INSTALLER FOR PROVIDING AN ADDITIONAL 6" X 6" PIECE OF ROOF MEMBRANE AT EACH ROOF ATTACHMENT LOCATION, DO NOT PENETRATE ROOF MEMBRANE. TYPICAL FOR ALL INTERCONNECTING CONDUCTORS.
- ④ PROVIDE DOWNLOAD CONDUCTOR TO CONNECT LIGHTNING PROTECTION SYSTEM TO GROUND LOOP. CONCEAL CONDUCTOR IN STRUCTURE, ROUTE CONDUCTOR DOWN CORNERS OF BUILDING IN LOCATIONS SHOWN. COORDINATE DETAILS WITH ARCHITECTURAL AND STRUCTURAL ENGINEER. PROVIDE EXOTHERMIC WELD AT CONNECTION TO BURIED GROUND ROD.
- ⑤ PROVIDE COPPER MASTER GROUND BAR (MGB) IN IT ROOM ON WEST WALL. MGB SHALL BE 2" TALL X 1/4" THICK X 2'-0" LONG COPPER MOUNTED TO THE WALL ON STAND OFFS 24" ABOVE THE FLOOR.
- ⑥ BOND POWER SERVICE TO GROUND LOOP USING #20 COPPER CONDUCTOR. BOND POWER SERVICE TO REINFORCING STEEL IN FOUNDATION USING #20 COPPER CONDUCTOR.

## ORCHARD MESA FIRE STATION #4

GRAND JUNCTION, COLORADO

## LIGHTNING PROTECTION / ROOF PLAN

NO: ISSUED FOR: DATE:



PROJECT STATUS: 100% CD

DRAWN BY: KLT CHECKED BY: WLM

DATE: 04/10/2015 SHEET NO:

PROJECT NO: 1443/140330 E302

LIGHTING SCHEDULE												
LIGHTING FIXTURE		MANUFACTURER CATALOG # FIRST HALF		MOUNTING AIMING DIFFUSER REFLECTOR HOUSING FINISH		LAMP QUANTITY - TYPE MANUFACTURER CATALOG NUMBER		BALLAST / DRIVER TYPE 1 QUANTITY - TYPE MANUFACTURER CATALOG NUMBER		BALLAST / DRIVER TYPE 2 QUANTITY - TYPE MANUFACTURER CATALOG NUMBER		DESCRIPTION
DESCRIPTION DIMENSIONS		APPROVED ALTERNATES		HOUSING MATERIAL		LUMENS C.R.I.		COLOR TEMPERATURE LAMP LIFE		STARTING METHOD BALLAST FACTOR		
FA1	COLUMBIA TRE 22-17 G RFA E U	—	CEILING RECESSED DIRECT/INDIRECT RIBBED FROSTED ACRYLIC	—	LITHONIA, METALUX SHEET STEEL	3 - 17 WATT 24" T8 LINEAR FLUORESCENT G.E. F17T8/XL/SPX35/ECO	1350 L	3500 DEG K	INSTANT	>=1.00	—	FA1: FLUORESCENT: ARCHITECTURAL 120 V 44 W ENVIRONMENT: ABOVE 50F & DRY. TROFFER WITH ARCHITECTURAL LENS.
FA2	COLUMBIA TRE 22-17 G RFA ED U	—	CEILING RECESSED DIRECT/INDIRECT RIBBED FROSTED ACRYLIC	—	LITHONIA, METALUX SHEET STEEL	3 - 17 WATT 24" T8 LINEAR FLUORESCENT G.E. F17T8/XL/SPX35/ECO	1350 L	3500 DEG K	INSTANT	>=1.00	—	FA2: FLUORESCENT: ARCHITECTURAL 120 V 44 W ENVIRONMENT: ABOVE 50F & DRY. TROFFER WITH ARCHITECTURAL LENS AND ELECTRONIC DIMMING BALLAST.
FA3	FOCAL POINT FAV NS 175 2C 120 S F 2EG SN WH 4' PINNACLE, METALUX SHEET STEEL	—	CEILING RECESSED DIRECT/ACCENT PERFORATED METAL	—	—	1 - 21 WATT 33" T5 FLUORESCENT - MR16 G.E. F21W/T5/835/ECO - C35MR16/C/G12	2100 L	3500 DEG K	PROGM	>=1.00	—	FA3: FLUORESCENT: ARCHITECTURAL 120 V 46 W ENVIRONMENT: ABOVE 50F & DRY. FLANGED MOUNTED WITH 1 LAMPS IN CROSS SECTION. SUPPLY WITH EXTENDED GIMBAL AND SNOOT FOR THE MR16 LAMPS. PROVIDE WITH (2) 35 WATT MR16 LAMPS.
FA4	FOCAL POINT FV2 20 4T 1C 120 C RC WH 4' LITHONIA, METALUX SHEET STEEL	—	CEILING RECESSED DIRECT/ACCENT PERFORATED METAL	—	—	1 - 28 WATT 46" T5 LINEAR FLUORESCENT G.E. F28W/T5/835/ECO	2900 L	3500 DEG K	PROGM	>=1.00	—	FA4: FLUORESCENT: ARCHITECTURAL 120 V 34 W ENVIRONMENT: ABOVE 50F & DRY. PERMITER LINEAR WALLWASH FIXTURE WITH WHITE BAFFLE. ONE LAMP IN CROSS SECTION. SEE PLANS FOR REQUIRED LENGTHS.
FA6	SHAPER 600-36-W/T5/22-17-AVA LITHONIA, METALUX SHEET STEEL	NATURAL ALUMINUM	WALL SURFACE DIRECT/INDIRECT MATTE WHITE ACRYLIC	—	—	2 - 21 WATT 36" T5 LINEAR FLUORESCENT G.E. F21W/T5/835/ECO	2100 L	3500 DEG K	INSTANT	>=1.00	—	FA6: FLUORESCENT: ARCHITECTURAL 120 V 50 W ENVIRONMENT: ABOVE 50F & DRY. DECORATIVE WALL LINEAR FIXTURE WITH NATURAL ALUMINUM END CAPS.
FA7	ALERA LIGHTING MD 4 1U1DT5 W/CB E U ZT DC LITHONIA, METALUX SHEET STEEL	—	WALL SURFACE DIRECT/INDIRECT WHITE CROSS BAFFLE	—	METALLIC SILVER	2 - 28 WATT 46" T5 LINEAR FLUORESCENT G.E. F28W/T5/835/ECO	2900 L	3500 DEG K	PROGM	>=1.00	—	FA7: FLUORESCENT: ARCHITECTURAL 120 V 68 W ENVIRONMENT: ABOVE 50F & DRY. ONE LAMP UP AND ONE LAMP DOWN. PROVIDE WITH ACRYLIC LENS ON TOP OF FIXTURE AND CROSS BAFFLE ON BOTTOM.
FC1	COLUMBIA WC 4-3 32-E U	—	CEILING SURFACE DIRECT/ACCENT .125" ACRYLIC PRISMATIC	—	PAINTED WHITE	3 - 32 WATT 48" T8 LINEAR FLUORESCENT G.E. F32T8/LX/SPX35/HL/ECO	3100 L	3500 DEG K	INSTANT	>=1.00	—	FC1: FLUORESCENT: SURFACE WRAP 120 V 95 W ENVIRONMENT: ABOVE 50F & DRY.
FD1	PRESCOLITE CFT632HEB-STF602H CL B6	—	CEILING RECESSED DIRECT CLEAR LENS SEMI-SPEC CLEAR ALZAK CLEAR ALZAK	—	—	1 - 32 WATT TRIPLE BIAX FLUORESCENT G.E. F32TBX/835/A/ECO	2400 L	3500 DEG K	INSTANT	>=1.00	—	FD1: FLUORESCENT: DOWNLIGHT 120 V 36 W ENVIRONMENT: ABOVE 50 DEG F & WET. 6" DIA. LENSED DOWNLIGHT. FIXTURE TO BE PROVIDED WITH MULTI-VOLT BALLAST.
FD2	GOTHAM LGFLP 1/32TRT 6SB CGL 12 LITHONIA, HALO SHEET STEEL	—	CEILING RECESSED DIRECT CLEAR LENS SEMI-SPEC CLEAR ALZAK CLEAR ALZAK	—	—	1 - 32 WATT TRIPLE BIAX FLUORESCENT G.E. F26DBX/835/ECO/4P	1710 L	3500 DEG K	INSTANT	>=1.00	—	FD2: FLUORESCENT: DOWNLIGHT 120 V 32 W ENVIRONMENT: -20F TO 120 DEG F & DAMP. 6" DIA. HORIZONTAL LENSED DOWNLIGHT.
FD3	PRESCOLITE PDRGF-32TRT-6-WG-DWHE-120 LITHONIA, HALO SHEET STEEL	—	CEILING RECESSED DIRECT WHITE GLASS SEMI-SPEC CLEAR ALZAK CLEAR ALZAK	—	—	1 - 32 WATT TRIPLE BIAX FLUORESCENT G.E. F32TBX/835/A/ECO	2400 L	3500 DEG K	INSTANT	>=1.00	—	FD3: FLUORESCENT: DOWNLIGHT 120 V 36 W ENVIRONMENT: ABOVE 50 DEG F & DRY. 6" DIA. DOWNLIGHT WITH DECORATIVE DROPPED WHITE GLASS SHADE.
FG1	COLUMBIA JT2 22-17 G FS A12125 E U LITHONIA, METALUX SHEET STEEL	—	CEILING RECESSED DIRECT .125" ACRYLIC PRISMATIC	—	PAINTED WHITE	3 - 17 WATT 24" T8 LINEAR FLUORESCENT G.E. F17T8/XL/SPX35/ECO	1350 L	3500 DEG K	INSTANT	>=1.00	—	FG1: FLUORESCENT: GRID TROFFER 120 V 47 W ENVIRONMENT: ABOVE 50F & DRY.
FG2	COLUMBIA JT2 24-3 32 G FS A12125 E U LITHONIA, METALUX SHEET STEEL	—	CEILING RECESSED DIRECT .125" ACRYLIC PRISMATIC	—	PAINTED WHITE	3 - 32 WATT 48" T8 LINEAR FLUORESCENT G.E. F32T8/LX/SPX35/HL/ECO	3100 L	3500 DEG K	INSTANT	>=1.00	—	FG2: FLUORESCENT: GRID TROFFER 120 V 94 W ENVIRONMENT: ABOVE 50F & DRY.
FH1	G.E. LIGHTING OBC W 38' F O F E 15	—	PENDANT DIRECT ACRYLIC	—	WHITE	8 - 32 WATT TRIPLE BIAX FLUORESCENT G.E. F32TBX/835/A/ECO	2400 L	3500 DEG K	INSTANT	>=1.00	—	FH1: FLUORESCENT: HIGHBAY 120 V 272W W ENVIRONMENT: ABOVE 50 DEG F & DRY. PROVIDE WITH CORD AND HOOK.
FS1	COLUMBIA CS 4 2 32 E U	—	WALL SURFACE DIRECT WHITE ACRYLIC	—	PAINTED WHITE	2 - 32 WATT 48" T8 LINEAR FLUORESCENT G.E. F32TBX/835/HL/ECO	3100 L	3500 DEG K	PROGM	>=1.00	—	FS1: FLUORESCENT: OPEN STRIP 120 V 65 W ENVIRONMENT: ABOVE 50F & DRY.
FW1	SHAPER 600-2 W/P CFU/2/283 2W-TRIPLD-120-ALP HUBBELL, LITHONIA SHEET STEEL	—	WALL SURFACE CUT-OFF WHITE ACRYLIC	—	ALUMINUM PAINT	2 - 32 WATT TRIPLE BIAX FLUORESCENT G.E. F32TBX/835/A/ECO	2400 L	3500 DEG K	INSTANT	>=1.00	—	FW1: FLUORESCENT: EGRESS 120 V 68 W ENVIRONMENT: -20F TO 120 DEG F & WET. EXTERIOR EGRESS FIXTURE. EMERGENCY EGRESS.
FW2	SHAPER 674 43" WP T5 2/21 277V ALP KIM, LIGHTOLIER SHEET STEEL	—	WALL SURFACE DIRECT MATTE WHITE ACRYLIC	—	ALUMINUM PAINTED	2 - 21 WATT 33" T5 LINEAR FLUORESCENT G.E. F21W/T5/835/ECO	2100 L	3500 DEG K	PROGM	>=1.00	—	FW2: FLUORESCENT: ENCLOSED & GASKETED 120 V 48 W ENVIRONMENT: ABOVE 50F & DRY. LUMINOUS WALL SCONCE WITH DECORATIVE TRIM BARS.
LU1	WILLIAMS 1SF 3 18/835 AF12 125 WRS/120 DRV 120 ALKCO, LITHONIA EXTRUDED ALUMINUM	—	UNDER CABINET DIRECT CLEAR POLYCARBONATE	—	PEARL	1 - 21 WATT LED ARRAY G.E. LED2BDP38S-FL/TP	1000 L	4000 DEG K	INSTANT	>=1.00	—	LU1: L.E.D: UNDER CABINET 120 V 21 W ENVIRONMENT: ABOVE 50F & DRY. PROVIDE WITH ROCKER SWITCH.
LW1	BRUCK LIGHTING SYSTEMS 137 100 BK	—	CEILING RECESSED ADJUSTABLE CLEAR LENS	—	BLACK	1 - 3 WATT LED ARRAY SELECTED BY FIXTURE MANUFACTURER SELECTED BY FIXTURE MANUFACTURER	500 L	3000 DEG K	INSTANT	>=1.00	—	LW1: L.E.D: WALL 120 V 3 W ENVIRONMENT: ABOVE 50F & DRY. FLEXIBLE GOOSE NECK FIXTURE WITH BUILT-IN ROCKER SWITCH.
LX1	DUAL-LITE LX G W G	—	UNIVERSAL DIRECT GREEN PLASTIC	—	WHITE	1 - L.E.D. PROPRIETARY SELECTED BY FIXTURE MANUFACTURER SELECTED BY FIXTURE MANUFACTURER	200 L	3500 DEG K	INSTANT	>=1.00	—	LX1: L.E.D: EXIT 120 V 3.5 W ENVIRONMENT: ABOVE 50F & DRY. PUNCH ARROWS TO SHOW DIRECTION OF EGRESS.

GENERAL NOTES:

1. IF THE FIXTURE CATALOG NUMBER CONFLICTS WITH THE FIXTURE DESCRIPTION, THE FIXTURE DESCRIPTION TAKES PRECEDENCE.
2. THE FIXTURE MANUFACTURER SHALL SUPPLY LAMPS AND ALL ACCESSORIES NEEDED FOR THE INSTALLATION OF HIS FIXTURES.
3. THE COLOR TEMPERATURE OF ALL LAMPS SHALL BE THE SAME. COLOR TOLERANCES IN THE SCHEDULE TO THE ENGINEER'S ATTENTION PRIOR TO RELEASING FIXTURES FOR MANUFACTURE.
4. BATTERIES IN BATTERY BACK-UP FIXTURES SHALL BE SIZED TO PROVIDE 50% OF A SINGLE LAMP READING LUMEN OUTPUT FOR 90 MINUTES.
5. BATTERIES PROVIDED SHALL HAVE THE LOWEST MERCURY CONTENT AVAILABLE FOR THEIR TYPE.
6. LAMPS PROVIDED SHALL HAVE THE LOWEST MERCURY CONTENT AVAILABLE FOR THEIR TYPE.
7. SUBMIT AND RECEIVE APPROVAL FROM THE ENGINEER FOR ALL LIGHT FIXTURES, BALLASTS, AND BACK-UP BATTERIES PRIOR TO RELEASING FIXTURES FOR MANUFACTURE.

STATEMENT OF COMPLIANCE WITH THE INTERNATIONAL ENERGY CONSERVATION CODE - 2009	
SECTION 505.2 - INTERIOR LIGHTING CONTROLS	
THIS SECTION REQUIRES A MANUAL LIGHTING CONTROL FOR EACH ROOM, EXCEPT SECURITY AREAS, EMERGENCY AREAS, AND MEANS OF EGRESS LIGHTING.	
FOR THIS PROJECT, SWITCHES HAVE BEEN PROVIDED FOR EACH ROOM WHERE MANDATED.	
SECTION 505.2.2.1 - ADDITIONAL INTERIOR LIGHTING CONTROLS	
THIS SECTION REQUIRES A LIGHT REDUCING CONTROL FOR EACH ROOM, EXCEPT THOSE WITH ONLY ONE LUMINAIRE, OCCUPANT-SENSING DEVICE, PUBLIC AREAS, SLEEPING UNIT, OR SPACE LESS THAN 0.6 WATTS PER SQUARE FOOT.	
FOR THIS PROJECT, THIS SECTION HAS BEEN COMPLIED WITH THROUGH THE USE OF BI-LEVEL SWITCHING OF FIXTURES.	
SECTION 505.2.2.2 - AUTOMATIC LIGHTING SHUTOFF	
THIS SECTION REQUIRES AN AUTOMATIC LIGHTING SHUTOFF DEVICE IN NON-RESIDENTIAL BUILDINGS OF 5000 SQUARE FEET OR MORE. THIS AUTOMATIC DEVICE SHALL BE A PROGRAMMABLE TIME-OF-DAY CONTROLLER, AN OCCUPANCY SENSOR, OR A SIGNAL FROM ANOTHER CONTROL OR ALARM SYSTEM WHICH INDICATES THAT THE ROOM IS UNOCCUPIED.	
FOR THIS PROJECT, THIS DEVICE WOULD ENDANGER OCCUPANT SAFETY OR SECURITY. THIS DEVICE WILL NOT BE PROVIDED. THIS IS AN INDUSTRIAL BUILDING WHERE HEAVY MACHINERY IS CONSTANTLY IN MOTION, AND WHERE POTENTIALLY LIFE THREATENING OPERATIONS (WELDING) ARE BEING PERFORMED CONSTANTLY.	
SECTION 505.2.4 - EXTERIOR LIGHTING CONTROLS	
THIS SECTION REQUIRES EXTERIOR LIGHTING NOT INTENDED FOR 24-HOUR OPERATION TO HAVE AUTOMATIC SWITCHING OR PHOTOCELL CONTROLS. FURTHER, IT REQUIRES TIME SWITCHES TO BE ASTRONOMICAL 7-DAY, AND A MINIMUM 4-HOUR BACKUP.	
FOR THIS PROJECT, THE EXTERIOR LIGHTING SYSTEM IS CONTROLLED BY A PHOTOCELL TIME CLOCK COMBINATION.	
SECTION 505.3 - TANDEM WIRING	
THIS SECTION REQUIRES TANDEM WIRING FOR 1 AND 3 LAMP FIXTURES MOUNTED IN CONTINUOUS ROWS OR RECESSED IN ACCESSIBLE CEILINGS WITHIN 10' OF EACH OTHER. IT ALLOWS AN EXCEPTION IF ELECTRONIC HIGH FREQUENCY BALLASTS ARE USED OR IF FIXTURES ARE NOT ON SAME SWITCH CONTROL.	
THIS PROJECT WAS DESIGNED UTILIZING ELECTRONIC HIGH FREQUENCY BALLASTS.	
SECTION 505.4 - EXIT SIGNS	
THIS SECTION REQUIRES INTERNALLY ILLUMINATED EXIT SIGNS NOT EXCEED 5W/SIDE.	
LED EXIT SIGNS HAVE BEEN SPECIFIED. THEIR POWER CONSUMPTION MEETS THIS REQUIREMENT.	
SECTION 505.5 - INTERIOR LIGHTING POWER	
THIS SECTION REQUIRES THAT THE CONNECTED LOAD FOR ALL INTERIOR LIGHTING NOT EXCEED POWER DENSITIES LISTED IN TABLE 505.5.2. IT ALLOWS EXCEPTIONS FOR MERCHANDISING.	
FOR THIS PROJECT, THE CONNECTED LOAD POWER DENSITY IS .08 WATTS PER SQUARE FOOT. THIS BUILDING IS 8,428 SQ.FT. THE LIGHTING SYSTEM CONSUMES 7,350 WATTS. THE POWER DENSITY FOR THIS PROJECT IS .87 WATTS PER SQUARE FOOT. THIS IS WITHIN THE MAXIMUM POWER DENSITY LISTED IN TABLE 505.5.	
SECTION 505.6 - EXTERIOR LIGHTING POWER	
THIS SECTION REQUIRES THAT ALL EXTERIOR LIGHT SOURCES OVER 100 WATTS HAVE AN EFFICACY OF AT LEAST 60 LUMENS PER WATT. IT ALLOWS AN EXCEPTION FOR LOW VOLTAGE LANDSCAPE LIGHTING. IT ALSO ALLOWS AN EXCEPTION, WHERE APPROVED, FOR HISTORICAL, SAFETY, SIGNAGE, OR EMERGENCY LIGHTING.	
FOR THIS PROJECT, ALL EXTERIOR FIXTURES ARE METAL HALIDE OR FLUORESCENT, AND MEET THIS MINIMUM EFFICACY REQUIREMENT.	
TABLE 506.2 - LIGHTING POWER DENSITIES FOR BUILDING EXTERIORS	
THIS TABLE REQUIRES A MAXIMUM POWER DENSITY OF .15 WATT SQ.FT FOR PARKING LOTS AND DRIVES.	
FOR THIS PROJECT, THE PARKING LOT LIGHTING POWER DENSITY IS .09 WATT.	
TABLE 506.2 - LIGHTING POWER DENSITIES FOR BUILDING EXTERIORS	
THIS TABLE RE	