



6/5/2025 5:05:52 PM Autodesk Docs://Grand Junction Community Recreation Center/GJCRC\_ARCH\_R24.rvt


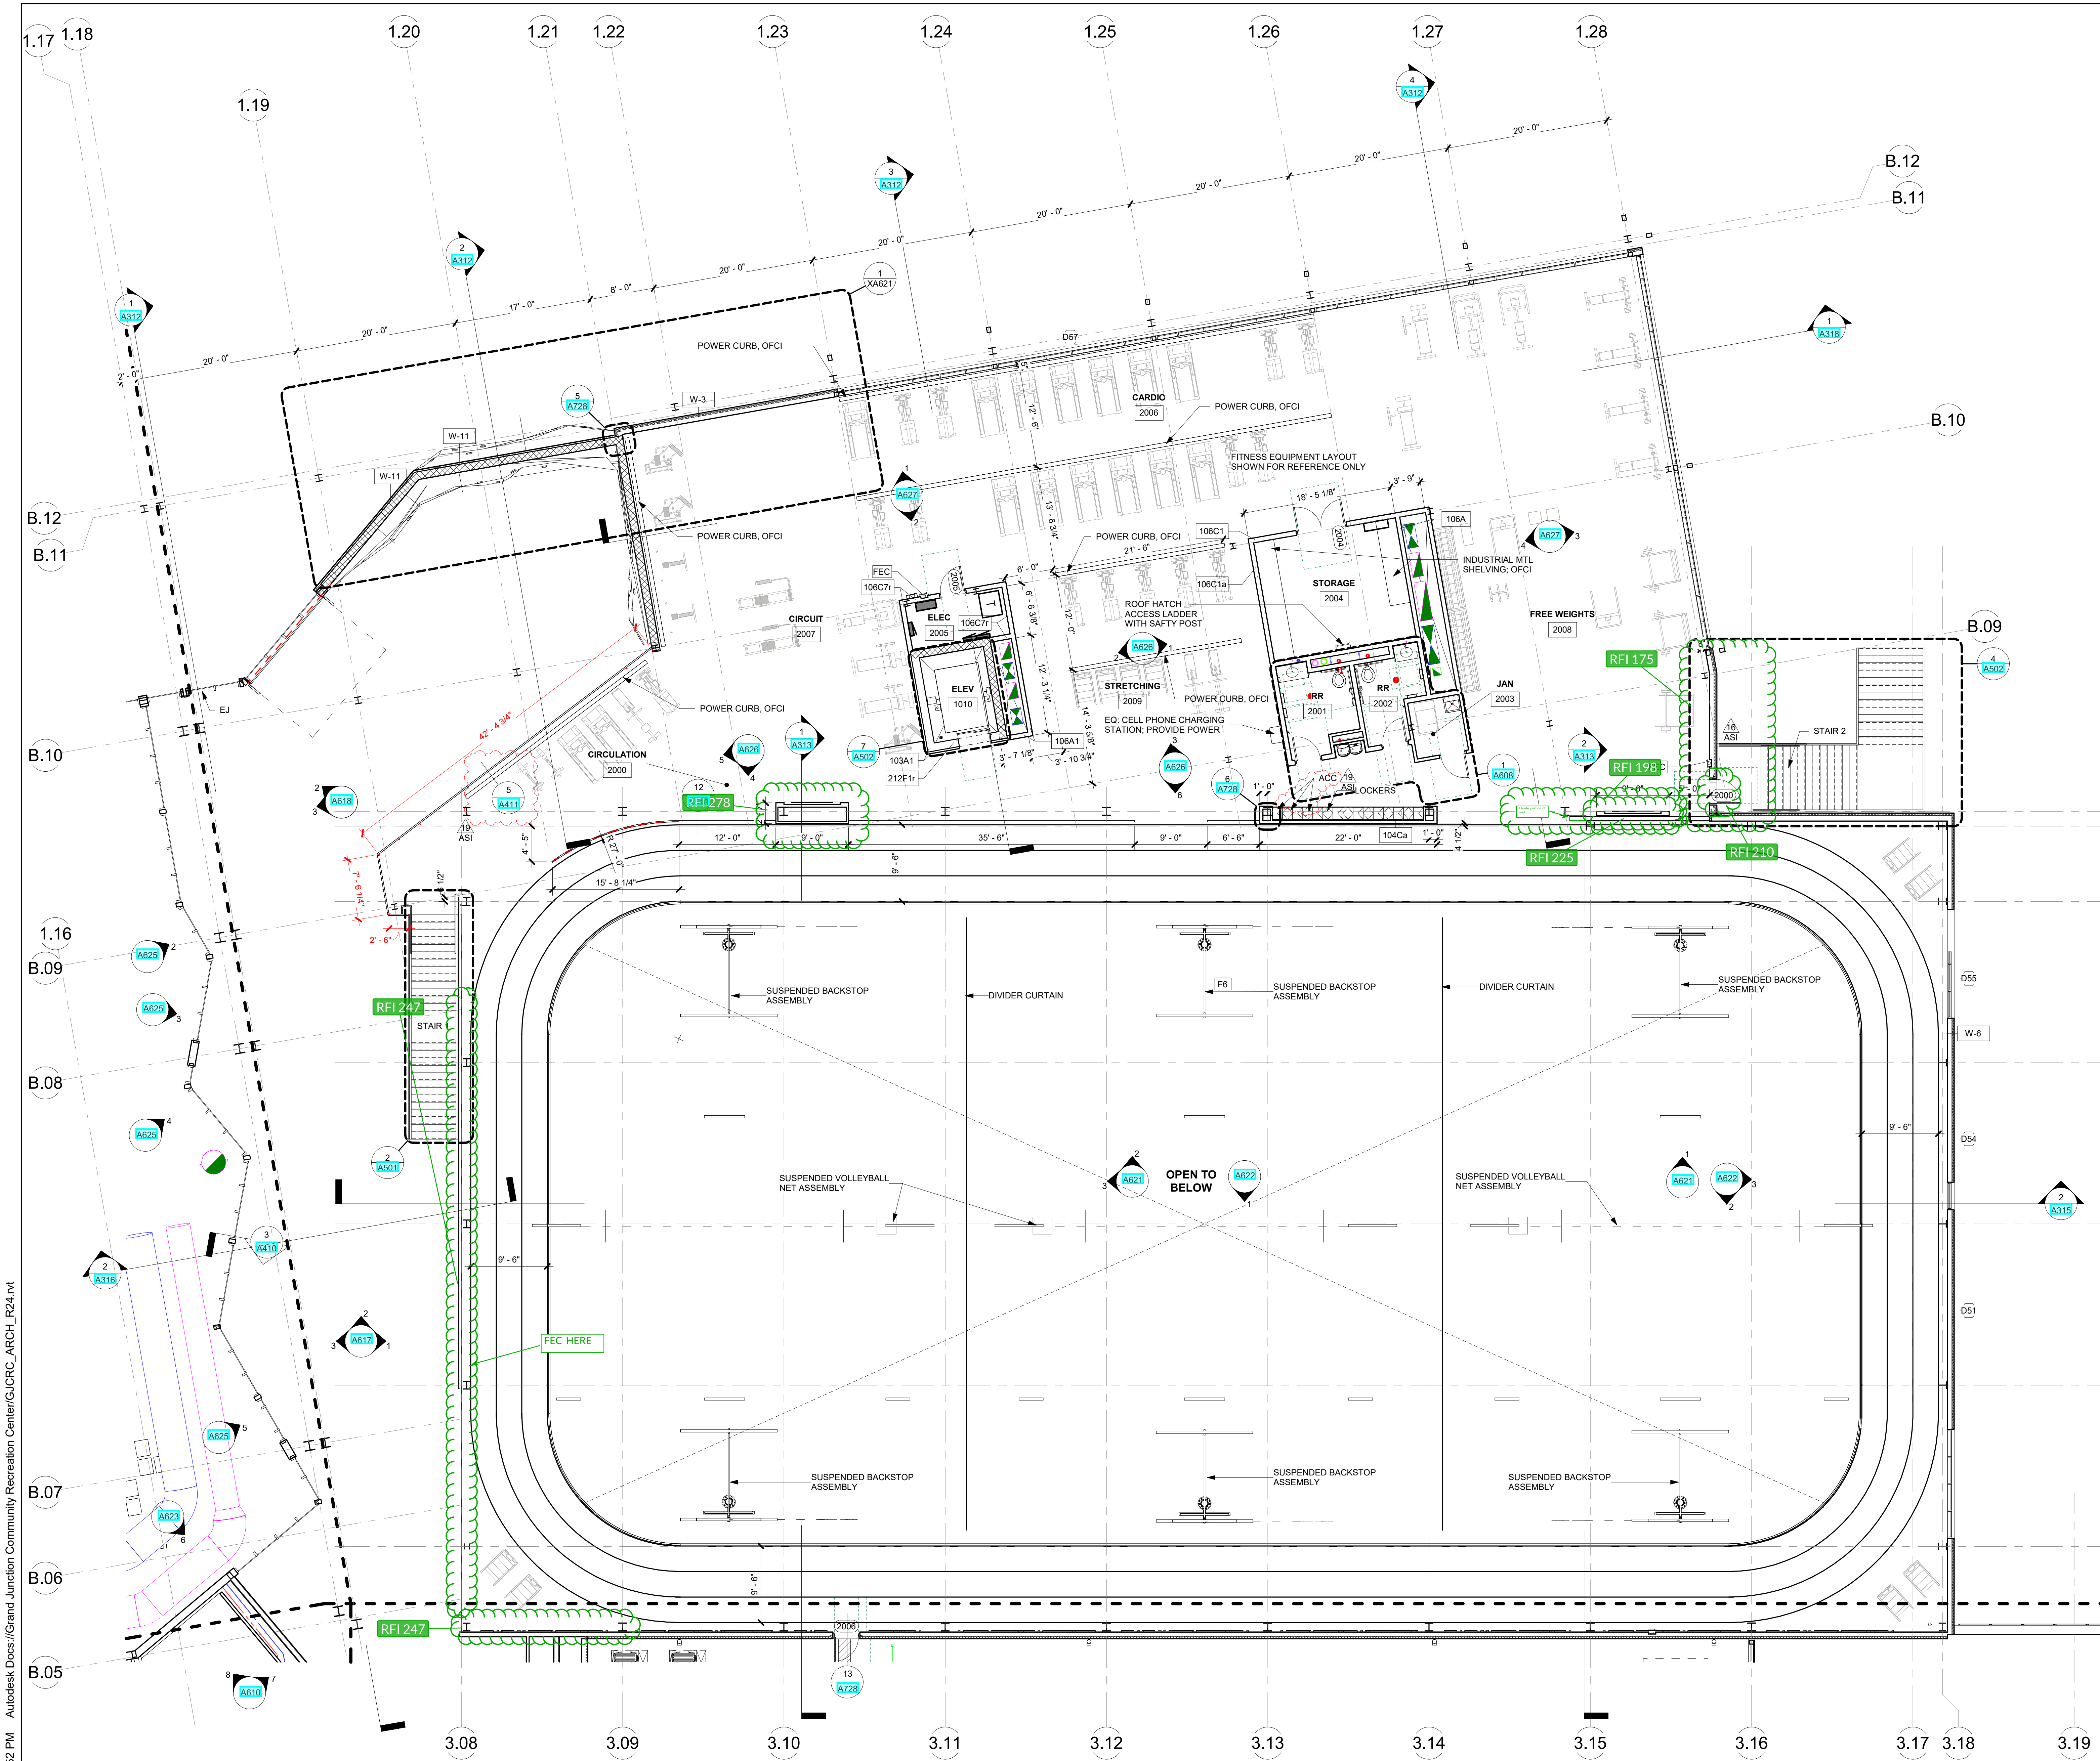


1 MEZZANINE FLOOR PLAN - AREA D  
1/8" = 1'-0"

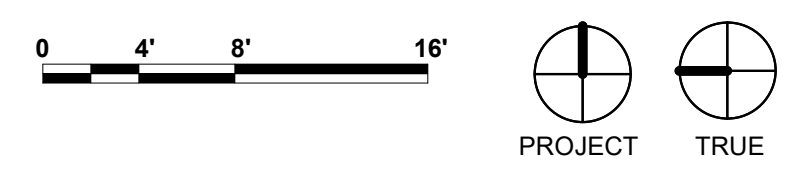

brsarch.com

GRAND JUNCTION COMMUNITY  
RECREATION CENTER  
2836 RECREATION WAY, GRAND  
JUNCTION, CO 81506

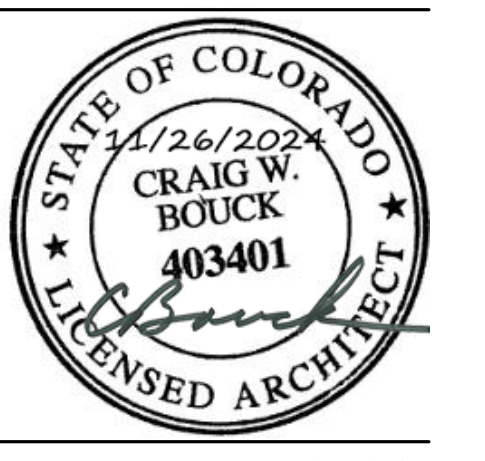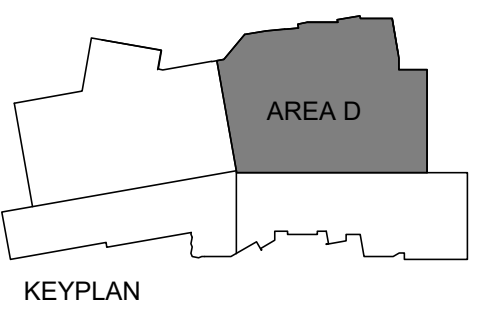

Project Number: 2023.024

Issue: ASI-019

Date: 6/5/2025

Drawn By: LSB

Checked By: MK

Revisions:

| Rev. | Description | Date:      |
|------|-------------|------------|
| 1    | Addendum #1 | 2024.08.15 |
| 2    | Addendum #2 | 2024.08.29 |
| 4    | Addendum #4 | 2024.11.26 |
| 34   | ASI #016    | 2025.04.29 |
| 39   | ASI #019    | 2025.06.05 |

Sheet title:  
MEZZANINE FLOOR PLAN -  
AREA D

A122  
© 2024 Barker Rinker Seacat Architecture