

10/2/2025 12:34:50 PM Autodesk Docs://Grand Junction Community Recreation Center/GJRC_ARCH_R24.rvt



RCP LEGEND

- WALL EXTENDS TO B.O. DECK ABOVE
- WALL EXTENDS TO 8" BELOW B.O. DECK

SEE MECHANICAL AND ELECTRICAL LEGENDS FOR ADDITIONAL SYMBOLS

- PAINT FINISH INDICATOR, REFERENCE FINISH LEGEND
- FLOOR FINISH INDICATOR, RE: FINISH LEGEND
- FINISH INDICATOR, REFERENCE FINISH LEGEND

- C1 - SAT 1 2X2 SUSPENDED ACOUSTICAL TILE
- C2 - SAT 2 2X2 SUSPENDED ACOUSTICAL TILE - VINYL COATED
- C3 - GYP. BD. CEILING
- C4 - APC CEILING
- C5 - EXTERIOR METAL SOFFIT
- C6 - WOOD SLAT CEILING
- C7 - GYP BD CEILING W/1" SHAFT LINER ANSUL263 U417
- EXPOSED DECK

NOTES:




- WHERE ACOUSTICAL TILE IS SHOWN AS A CLOUD, PROVIDE 6" EXTRUDED ALUMINUM TRIM JOIN.
- SOFFIT EDGES ARE SHOWN WITH HEAVY LINES.
- ONLY PRIMARY GRID LINES ARE SHOWN IN OVERALL RCPs FOR REFERENCE. REFER TO GRID PLAN FOR ALL GRID LINES.
- REFER TO A801 FOR GYM EQUIPMENT.
- AT NATATORIUM WHERE ROOF EXTENDS OVER EXTERIOR WALL, PROVIDE SPRAY INSULATING COATING @ BOTTOM OF DECK & STRUCTURAL STEEL. INSTALL 2'-0" FROM INSIDE FACE OF WALL & 2'-0" FROM EXTERIOR FACE OF WALL. TOP COAT INSULATING COATING W/ HPC COATING. RE: SPECS

RCP GENERAL NOTES

- ALL CEILING ELEVATIONS LISTED AS A.F.F. DIMENSIONS.
- SEE INTERIOR ELEVATIONS FOR CLARIFICATION IF NECESSARY. REFER TO WALL TYPES LISTED ON G20. THOSE WALLS, DESIGNATED ON PLANS AND WITHIN DETAILS MAY BE INTENDED TO CONTAIN SOME SOUND, WATER VAPOR, SMOKE AND/OR FIRE ATTENUATION.
- ALL WALLS SHALL EXTEND TO B.O. DECK UNLESS OTHERWISE NOTED.
- UNLESS NOTED OTHERWISE, DIMENSIONS SHOWN ON RCPs TO STUD WALLS ARE TO FINISH FACE OF WALL.
- UNLESS NOTED OTHERWISE, DIMENSIONS TO CIRCULAR OR ROUND COMPONENTS ARE TO CENTERLINE OF FIXTURE OR CEILING CLOUD.
- CEILING STRUCTURE AND BUILDING SYSTEMS DIRECTLY ABOVE CEILING CLOUDS TO BE FINISHED AS EXPOSED SURFACES WHEN WITHIN VISIBLE RANGE OF BUILDING OCCUPANTS. COORDINATE WITH ARCHITECT AS NEEDED.
- REFER TO INTERIOR FINISH SCHEDULE & LEGEND FOR ADDITIONAL CEILING FINISH INFORMATION

1 A214 ENLARGED AREA RCP - AREA D
1/8" = 1'-0"

0 4' 8' 16'

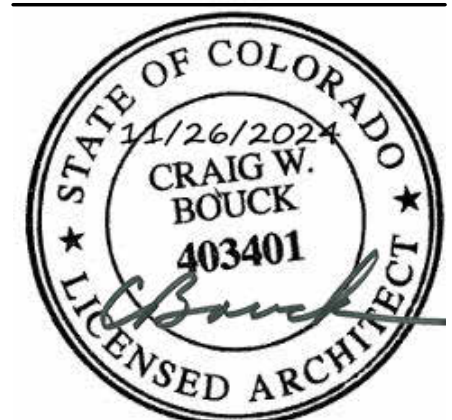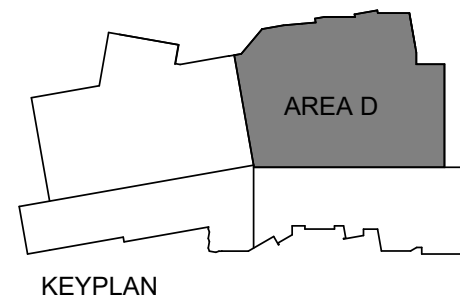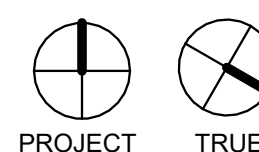

Project Number:	2023.024	
Issue:	CONFORMANCE SET	
Date:	11/26/2024	
Drawn By:	CL	
Checked By:	JW	
Revisions:		
Rev.	Description	Date:
1	Addendum #1	2024.08.15
2	Addendum #2	2024.08.29
4	Addendum #4	2024.11.26
39	ASI #019	2025.06.05
60	ASI-025	2025.10.03

Sheet title:
FIRST FLOOR RCP - AREA D