



**BARKER
RINKER
SEACAT**
ARCHITECTURE

brsarch.com


DHM DESIGN

900 S. Broadway
Suite 300
Denver, CO 80209
303.872.5566
www.dhmdesign.com

REUSE OF DOCUMENT
This document is the property of DHM Design Corp. The ideas and design incorporated on this document is an instrument of professional service and shall not be used for any other project without written authorization of DHM Design Corp.

GRAND JUNCTION COMMUNITY RECREATION CENTER
GRAND JUNCTION, CO

**KEY PLAN
L403**

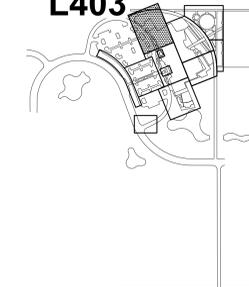

LEGEND

- SURVEY SECTION LINE
- PROPERTY LINE
- LOT LINE
- FO EXISTING FIBER OPTIC
- EXISTING ELECTRIC LINE
- EXISTING FENCE
- EXISTING TREE TO REMAIN
- EXISTING SURVEY MONUMENT
- EXISTING SIGN
- CONCRETE PAVING
- CONCRETE PAVING - COLORED
- CONCRETE PAVER
- CRUSHER FINES PAVING
- GRAVEL ROAD BASE
- 3/4" CRUSHED ROCK MULCH
- POURED-IN-PLACE SURFACING
- SYNTHETIC TURF
- CONCRETE EDGE
- STEEL EDGER
- X-X FENCE - 6' HEIGHT
- FENCE - 8' HEIGHT
- DECORATIVE SCREEN
- CHAINLINK FENCE - 6' HEIGHT
- POND, RE: CIVIL
- BOULDER BLOCK SEATING
- BIKE LOCKERS
- BIKE RACK
- SITE FURNITURE
- CJ CONSTRUCTION JOINT

NOTES

1. RE: SHEET L400 FOR ENLARGEMENT PLAN NOTES.

4 BIKE LOCKER - 4 LOCKERS
L706 OFCI

1 CONCRETE PAVING
L700

1 CONCRETE PAVING
L700

PR-015
REVISED: BIKE LOCKERS AND CONCRETE PAVING JOINT LAYOUT (RFI 321).
REMOVED: BOULDER SEATING IN SELECT AREAS (RFI 326).

ALTERNATE #20

- BASE BID: NO MAINTENANCE SHED
- ALTERNATE: MAINTENANCE SHED, RE: ARCHITECTURE

ALTERNATE #62

- BASE BID: FIRELANE MATERIAL - ASPHALT PAVING
- ALTERNATE: FIRELANE MATERIAL - CONCRETE PAVING
- RE: CIVIL FOR FIRELANE LAYOUT, MATERIALS, AND DETAILS



ACCEPTANCE BLOCK
THE CITY OF GRAND JUNCTION REVIEW CONSTITUTES GENERAL COMPLIANCE WITH THE CITY'S DEVELOPMENT STANDARDS, SUBJECT TO THESE PLANS BEING SEALED, SIGNED, AND DATED BY THE PROFESSIONAL SEAL, REVIEWED BY THE CITY ENGINEER AND COMPLETED APPROVAL OF THE CITY ENGINEER. THE CITY ENGINEER'S REVIEW DOES NOT CONSTITUTE AN ENDORSEMENT OF THE DESIGN. THE CITY ENGINEER'S REVIEW DOES NOT GUARANTEE THE ACCURACY OF THE INFORMATION OR THE DESIGN OR CALCULATIONS REMAIN THE RESPONSIBILITY OF THE PROFESSIONAL OF RECORD.
CONSTRUCTION MUST COMMENCE WITHIN ONE YEAR FROM THE DATE OF PLAN SIGNATURE.




Project Number: 2023.024
Issue: CONFORMANCE SET
Date: 11/26/2024
Drawn By: EAUN/PI/BB
Checked By: MTW/JJ

Rev.	Description	Date
1	Addendum #1	2024.08.15
2	Addendum #2	2024.08.20
3	Addendum #3	2024.09.25
4	Addendum #4	2024.11.28
5	PR-011	2025.10.01
6	PR-015	2025.11.17

Sheet title:
ENLARGEMENT PLAN

L403
© 2017 Barker Rinker Seacat Architecture

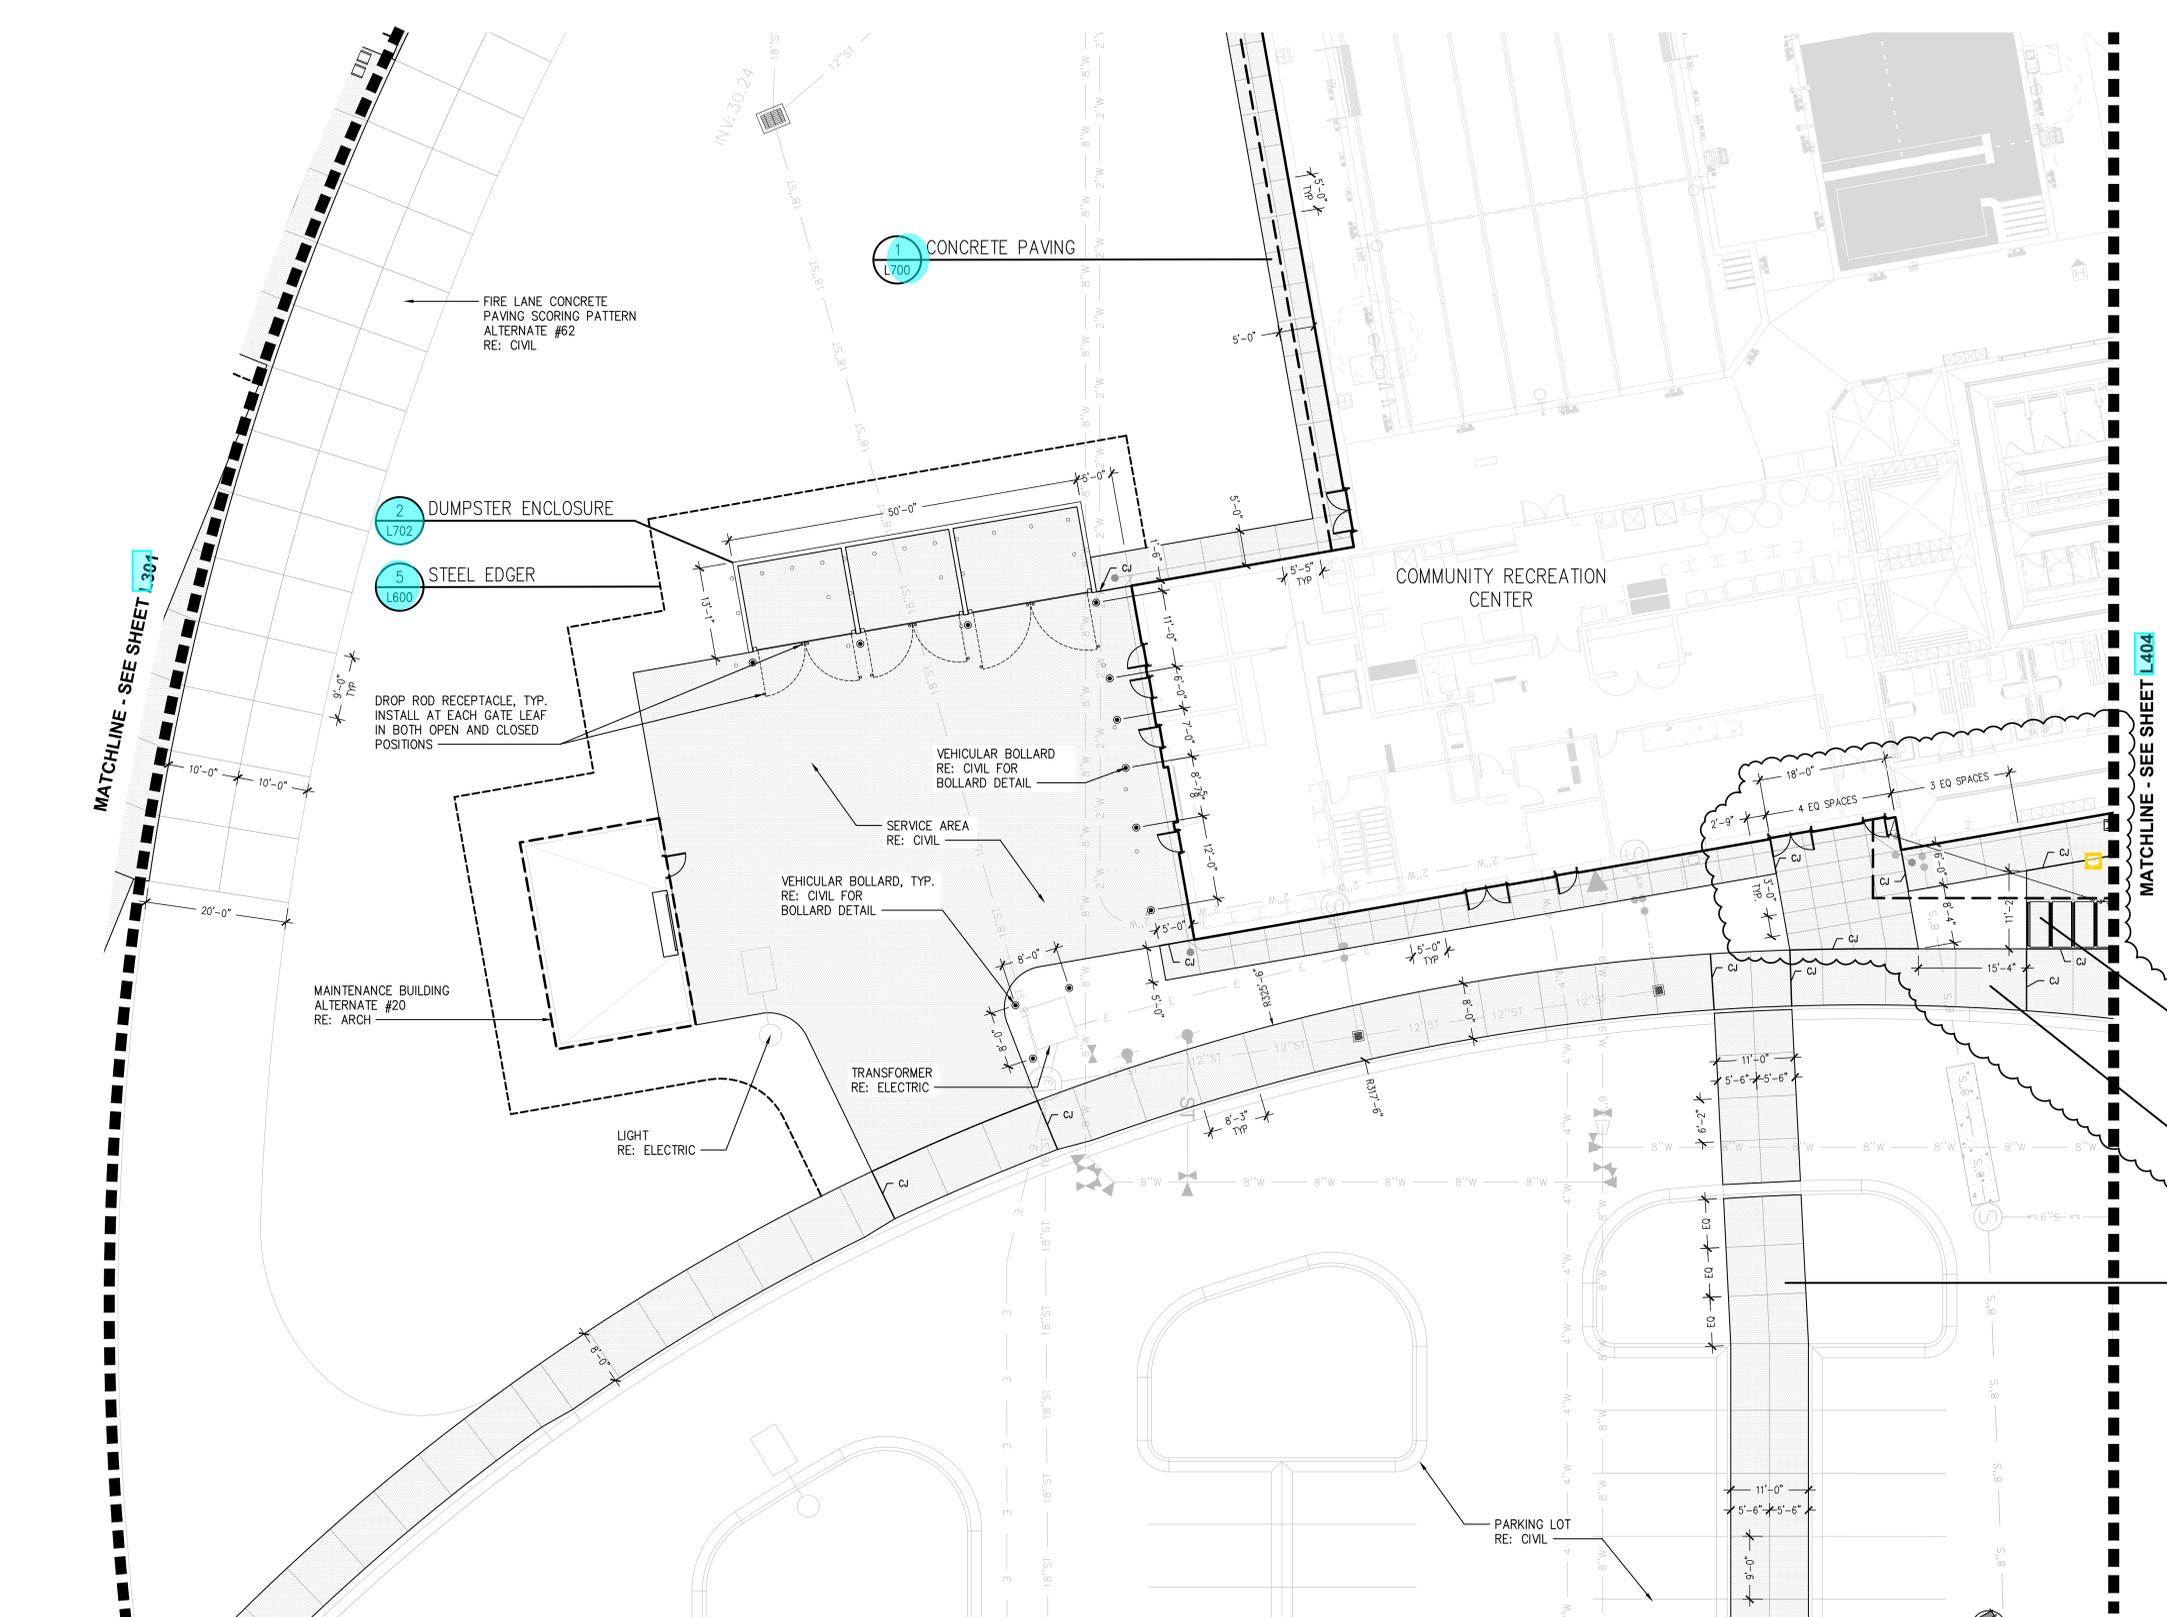

**1 PLAZA AND SERVICE AREA ENLARGEMENT
ALTERNATE #20 AND #62**

2/15/2024 3:14:38 PM Autodesk Docs://Grand Junction Community Recreation Center/2024.02.01_GJCR_ARCH_ARCH_R24.rvt



**BARKER
RINKER
SEACAT**
ARCHITECTURE

brsarch.com


DHM DESIGN

900 S. Broadway
Suite 300
Denver, CO 80209
303.872.5566
www.dhmdesign.com

REUSE OF DOCUMENT
This document is the property
of DHM Design Corp. The ideas and
design incorporated on this
document is an instrument of
professional service and shall not be
used for any other project without
written authorization of DHM Design Corp.

**GRAND JUNCTION COMMUNITY
RECREATION CENTER**
GRAND JUNCTION, CO

KEY PLAN

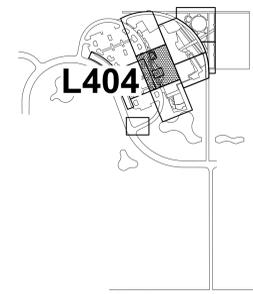

LEGEND

- SURVEY SECTION LINE
- PROPERTY LINE
- LOT LINE
- EXISTING FIBER OPTIC
- EXISTING ELECTRIC LINE
- EXISTING FENCE
- EXISTING TREE TO REMAIN
- EXISTING SURVEY MONUMENT
- CONCRETE PAVING
- CONCRETE PAVING - COLORED
- CONCRETE PAVER
- CRUSHER FINES PAVING
- GRAVEL ROAD BASE
-
- POURED-IN-PLACE SURFACING
- SYNTHETIC TURF
- CONCRETE EDGE
- STEEL EDGER
- FENCE - 6' HEIGHT
- FENCE - 8' HEIGHT
- DECORATIVE SCREEN
- CHAINLINK FENCE - 6' HEIGHT
- POND, RE: CIVIL
- BOULDER BLOCK SEATING
- BIKE LOCKERS
- BIKE RACK
- SITE FURNITURE
- CONSTRUCTION JOINT

NOTES

1. RE: SHEET L400 FOR ENLARGEMENT PLAN NOTES.
2. MATERIALS AND FINISHES NOT SPECIFICALLY IDENTIFIED AS 'ALTERNATE #10' ARE TO BE INCLUDED IN BASE BID.
3. SEE SHEET L405 FOR ENTRY PLAZA BASE BID MATERIALS.

7 CONCRETE EDGE - 1'-0"
L700

CONCRETE PAVING IN PARKING LOT
RE: CIVIL

PR-015

- REMOVED: CONCRETE SCORING (RFI 321) AND BIKE LOCKERS.
- REMOVED: BOULDER SEATING IN SELECT AREAS (RFI 326) AND BIKE LOCKERS SOUTH OF ENTRY.

ALTERNATE #10

- CONCRETE PAVERS
- CONCRETE EDGE



Project Number: 2023.024
Issue: CONFORMANCE SET
Date: 11/26/2024


Drawn By: EAUN/PI/BB
Checked By: MTW/JJ

Revisions:

Rev.	Description	Date
1	Addendum #1	2024.08.15
2	Addendum #2	2024.08.20
3	Addendum #3	2024.09.25
4	Addendum #4	2024.11.28
5	PR-011	2025.10.01
6	PR-015	2025.11.17

Sheet title:
ENLARGEMENT PLAN


L404
© 2017 Barker Rinker Seacat Architecture

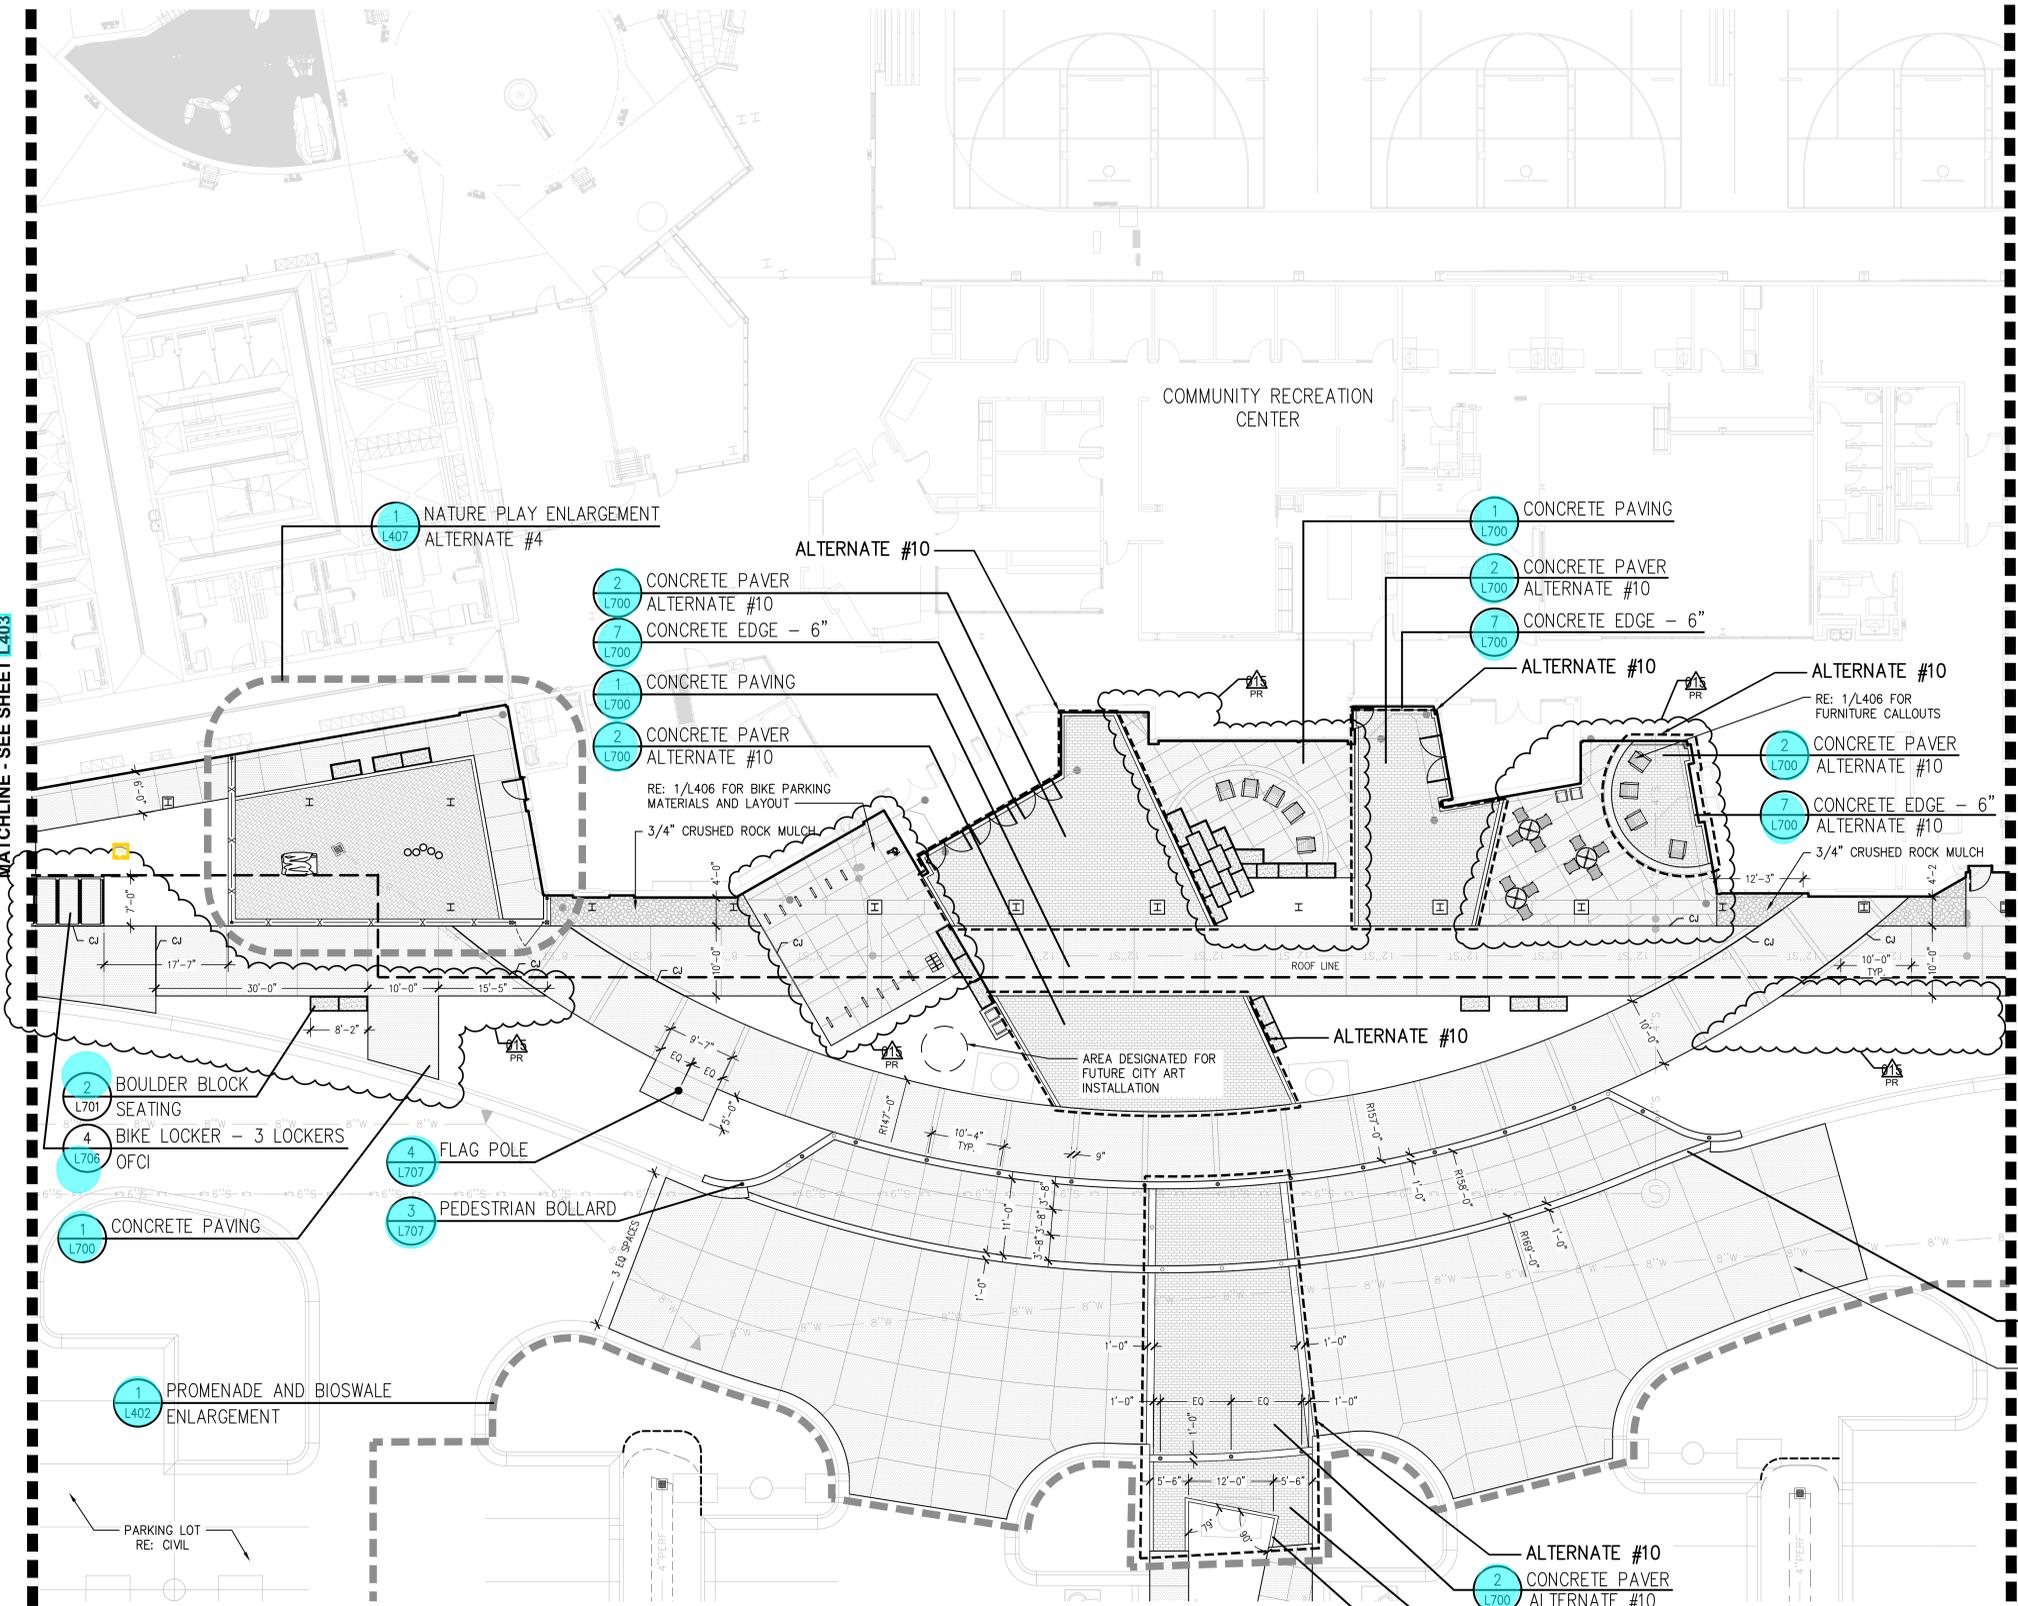

MATCHLINE - SEE SHEET L403

MATCHLINE - SEE SHEET L409

1 ENTRY PLAZA ENLARGEMENT
ALTERNATE #10

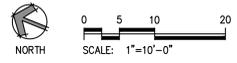

ACCEPTANCE BLOCK
THE CITY OF GRAND JUNCTION REVIEW CONSTITUTES GENERAL COMPLIANCE WITH THE CITY'S
DEVELOPMENT STANDARDS, SUBJECT TO THESE PLANS BEING SEALED, SIGNED, AND DATED BY
THE PROFESSIONAL SEAL, REVIEWED BY THE CITY ENGINEER AND THE CITY PLANNING DEPARTMENT.
THE CITY ENGINEER, THE CITY PLANNING DEPARTMENT, AND THE CITY ENGINEER SHALL NOT BE
RESPONSIBLE FOR THE DESIGN OR CALCULATIONS REMAINING THE RESPONSIBILITY OF THE
PROFESSIONAL SEAL.
CONSTRUCTION MUST COMMENCE WITHIN ONE YEAR FROM THE DATE OF PLAN SIGNATURE.

2/15/2024 3:14:38 PM Autodesk Docs://Grand Junction Community Recreation Center/2024.02.01_GJCR_ARCH_R24.rvt