



**BARKER  
RINKER  
SEACAT**  
ARCHITECTURE

brsarch.com






**GRAND JUNCTION COMMUNITY  
RECREATION CENTER**  
GRAND JUNCTION, CO

Project Number: 23357  
Issue: CONFORMANCE SET  
Date: 11.26.2024  
Drawn By: MDG  
Checked By: RIG

Revisions:	Rev.	Description	Date:
1	Addendum #1	2024.08.15	
3	Addendum #3	2024.09.25	
4	Addendum #4	2024.11.26	
7	PR-007	2025.08.12	

Sheet title:  
FIRST FLOOR MECHANICAL  
EQUIPMENT PLAN

**PL401**  
© 2017 Barker Rinker Seacat Architecture

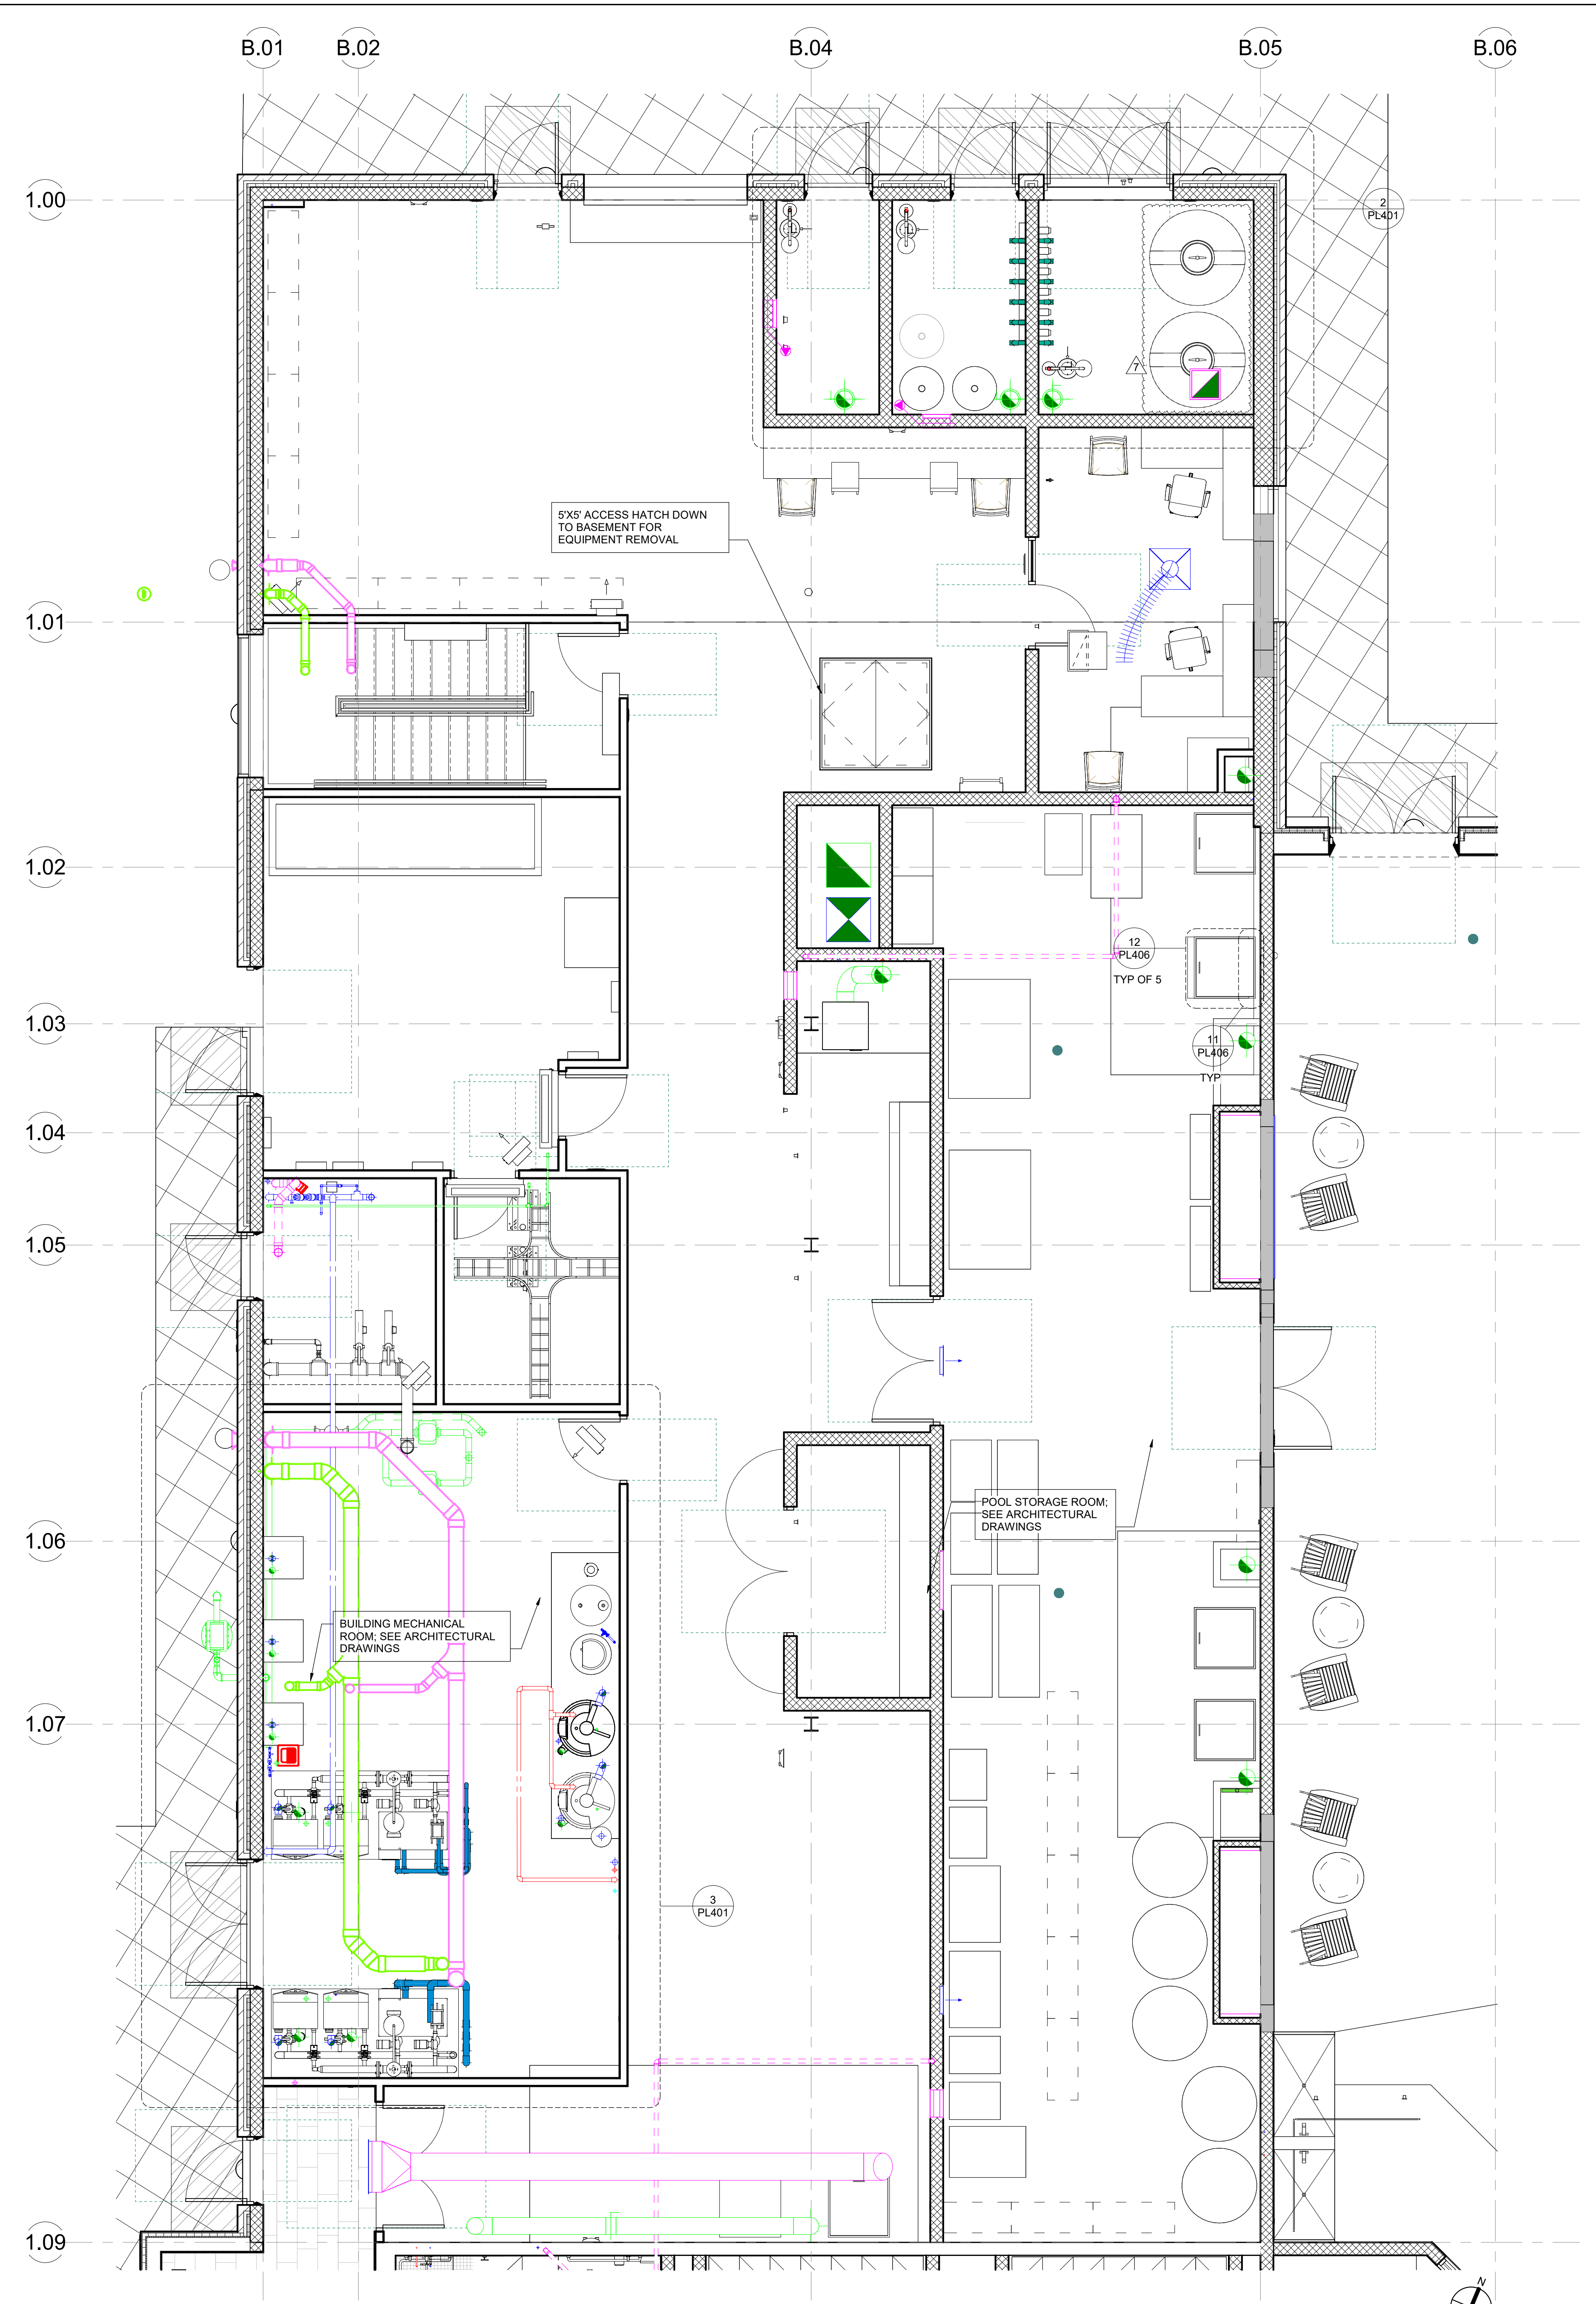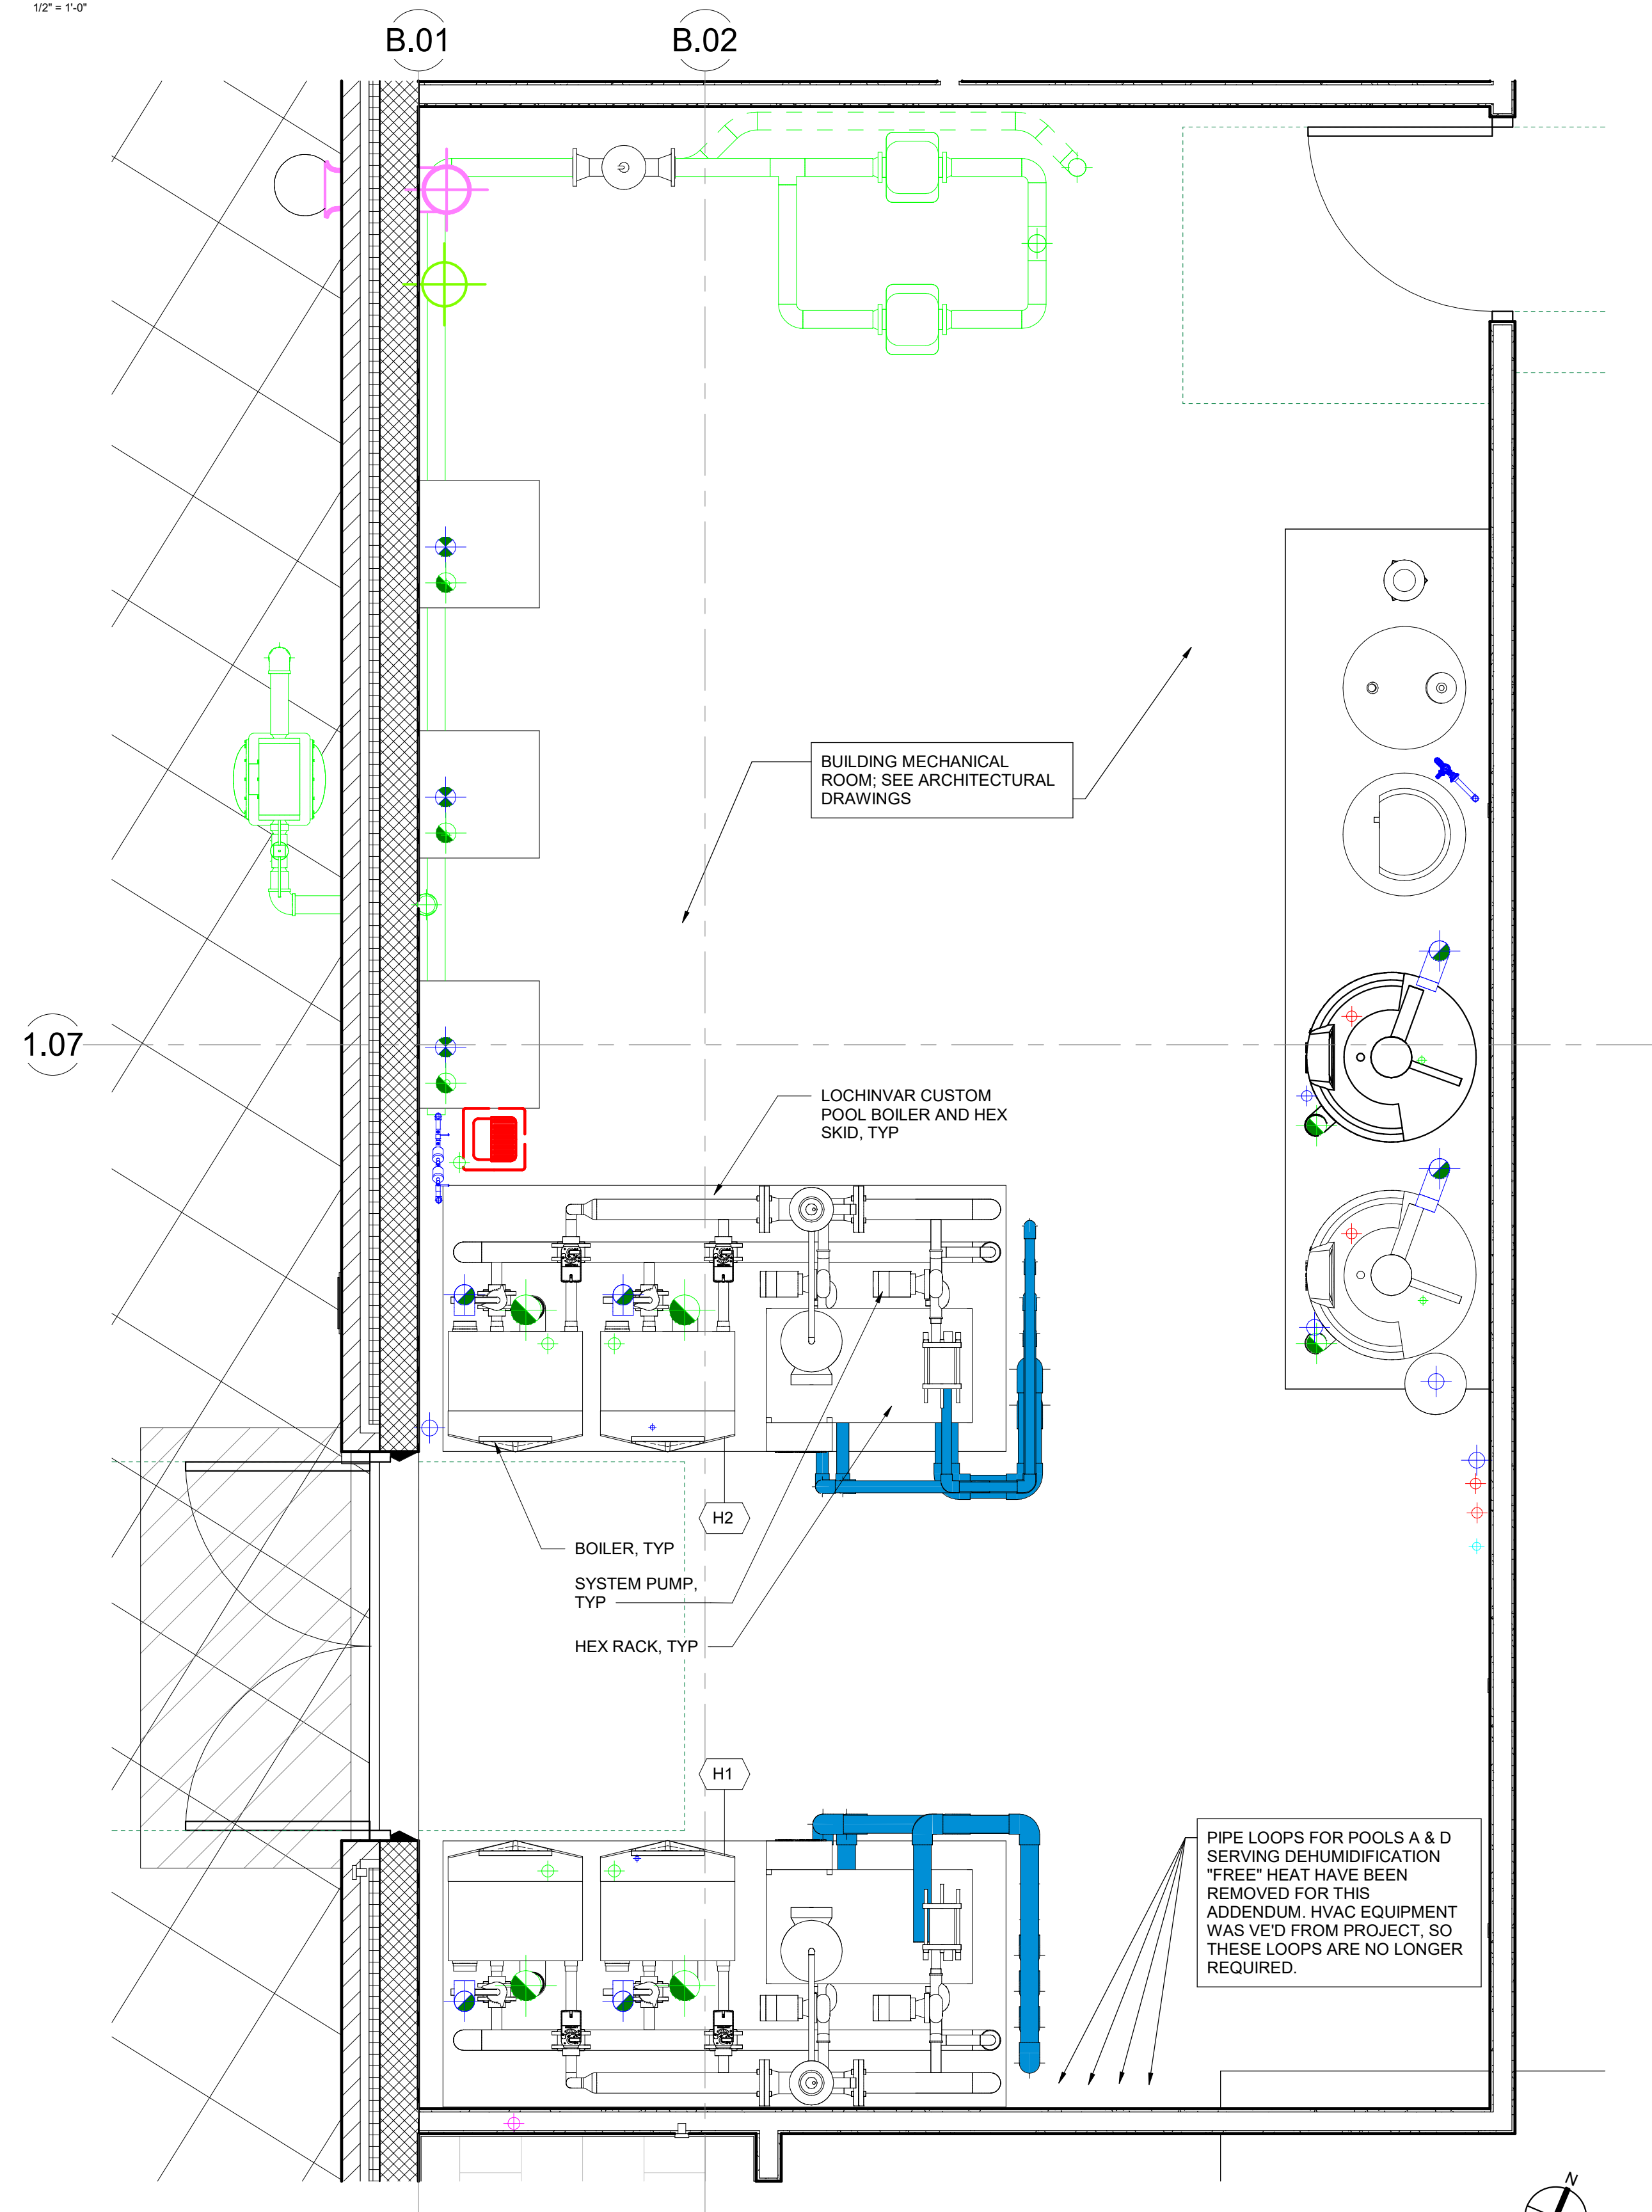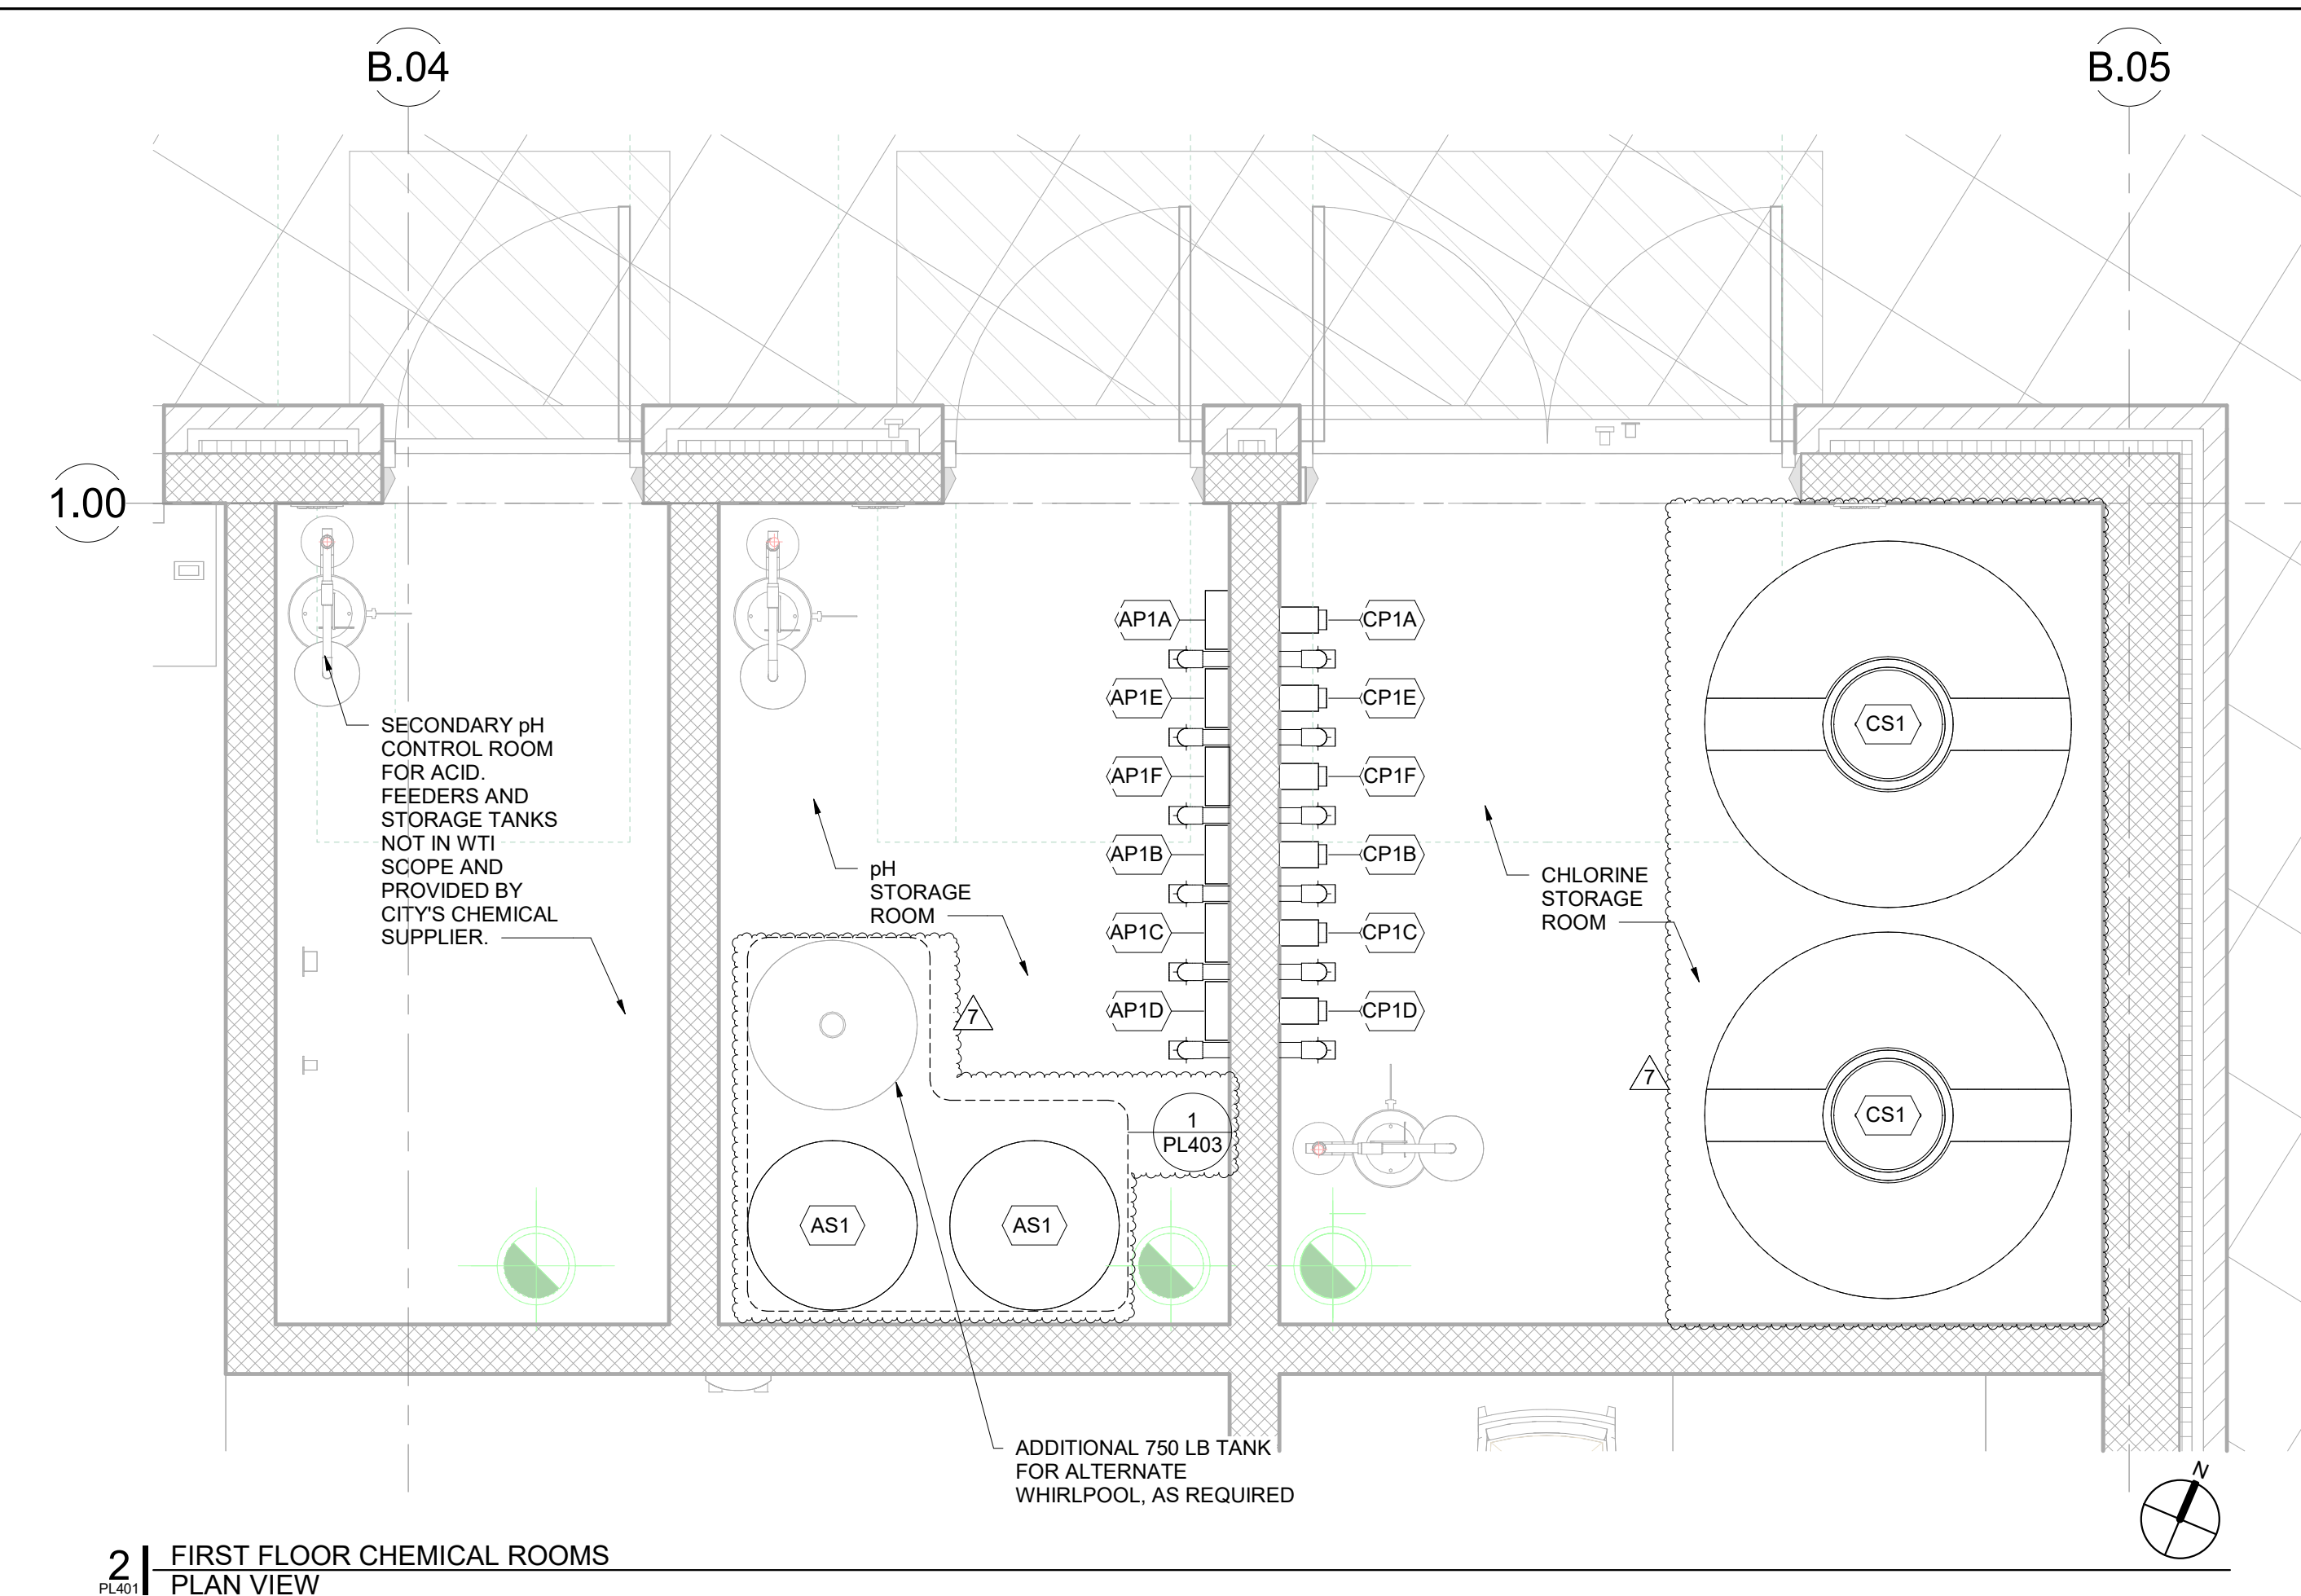

8/13/2025 8:34:35 AM Autodesk/Docs/Grand Junction Community Recreation Center/23357\_GJCRC\_Aquatics\_R24.rvt