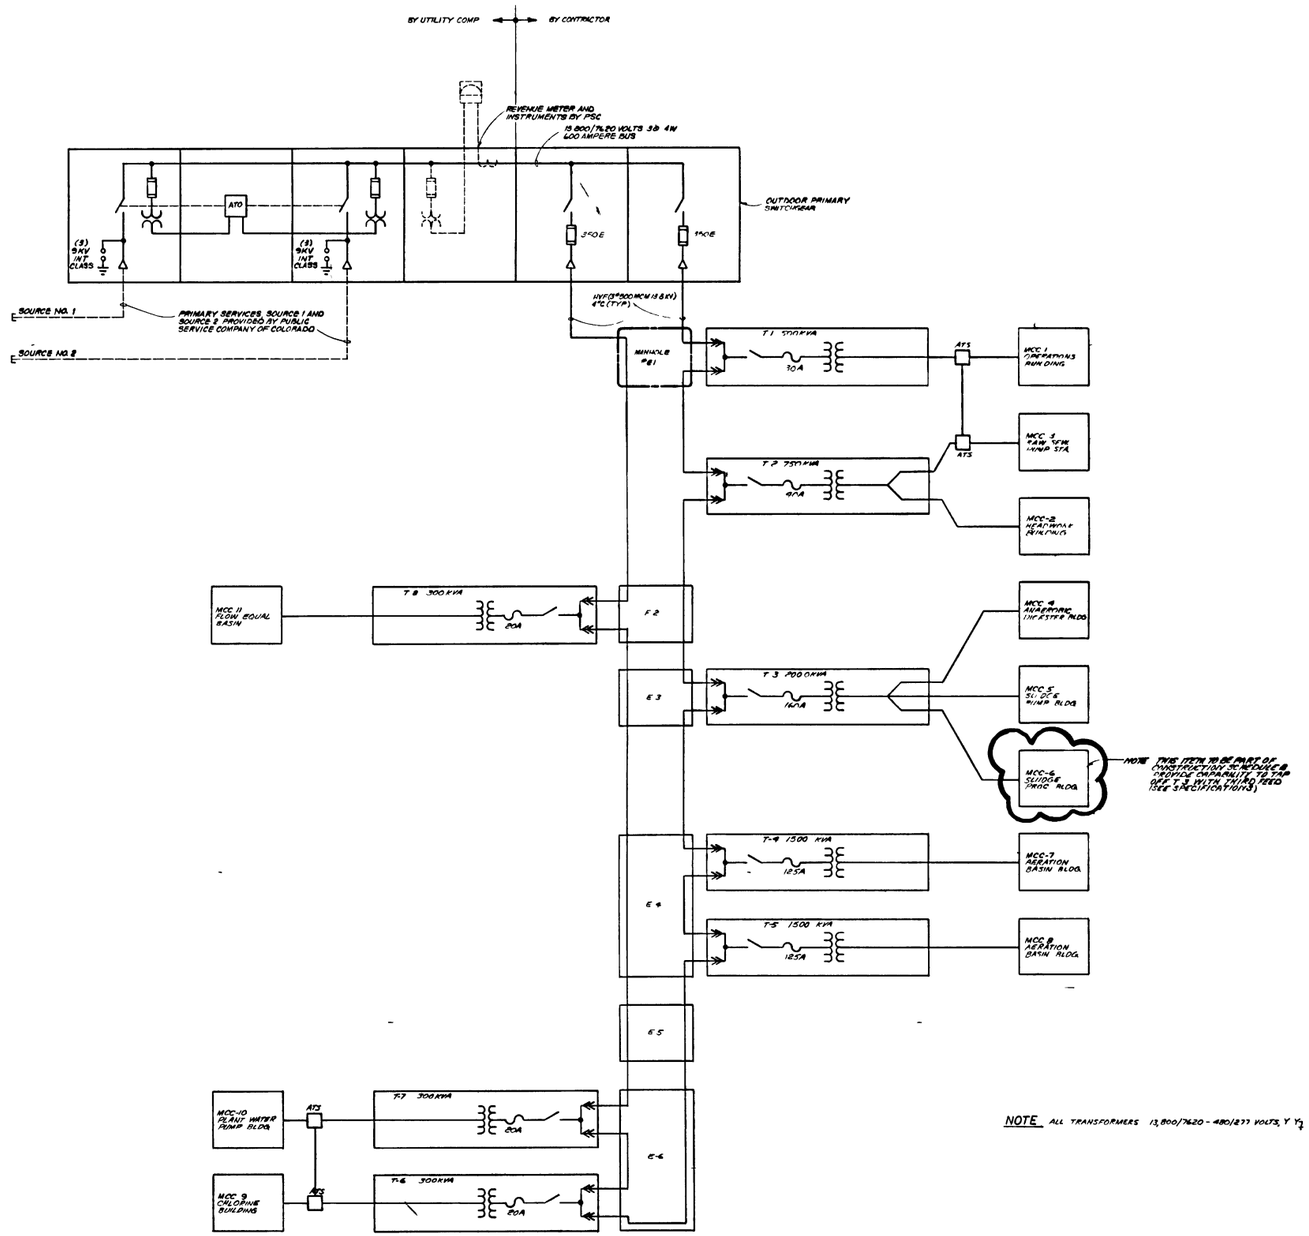

NOTE ALL TRANSFORMERS 13,800/7620 - 480/277 VOLTS, Y Y

PRIMARY DISTRIBUTION SYSTEM ONE-LINE DIAGRAM

07087977.tif

"AS RECORDED" FROM INFORMATION PROVIDED BY THE CONTRACTOR DATE 1984

NO.	DATE	DESCRIPTION REVISIONS	MADE	APPROV.
1	6/13/84	AS BUILT	DCL	
2		REVISED PER FINAL REVIEW	JLW	C.C.M.

SIMMSON RINK & ASSOCIATES CONSULTING ENGINEERS CURTIS C. MCMINOR REGISTERED PROFESSIONAL ENGINEER STATE OF COLORADO

GRAND JUNCTION / MESA COUNTY, COLORADO

PERSIGO WASH WASTEWATER TREATMENT PLANT

SECTION VII ELECTRICAL

ONE LINE DIAGRAM
13.8 KVA DISTRIBUTION

HENNINGSON, DURHAM & RICHARDSON, INC.
ENGINEERS PLANNERS CONSULTANTS
DENVER COLORADO GRAND JUNCTION COLORADO

JOB 73451O DESIGNED DLB CHECKED DLB APPROVED CCM DATE JAN-1982 DETAILED ROM

SHEET VII-26