

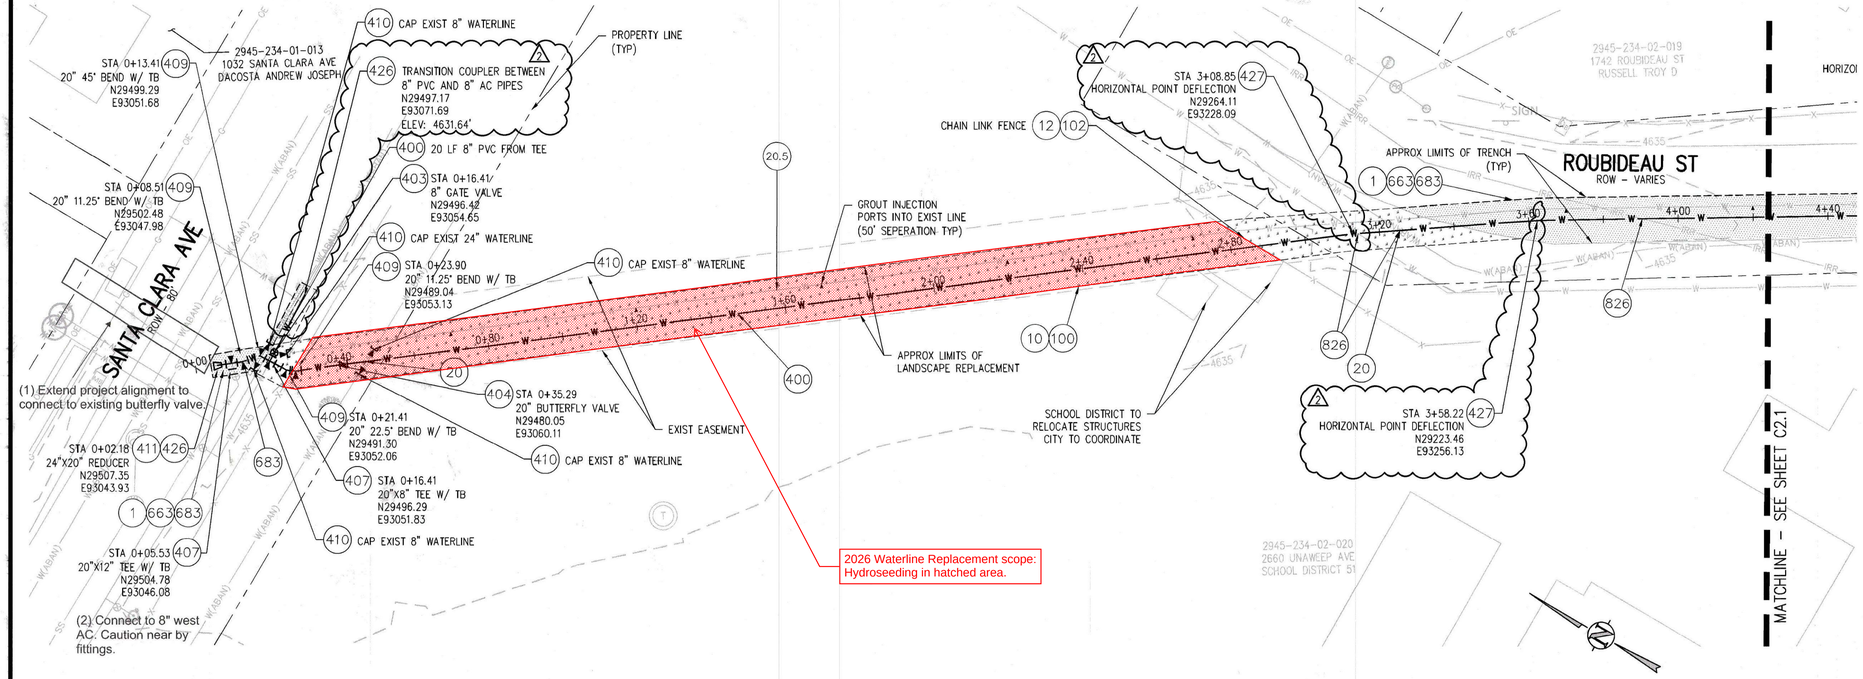


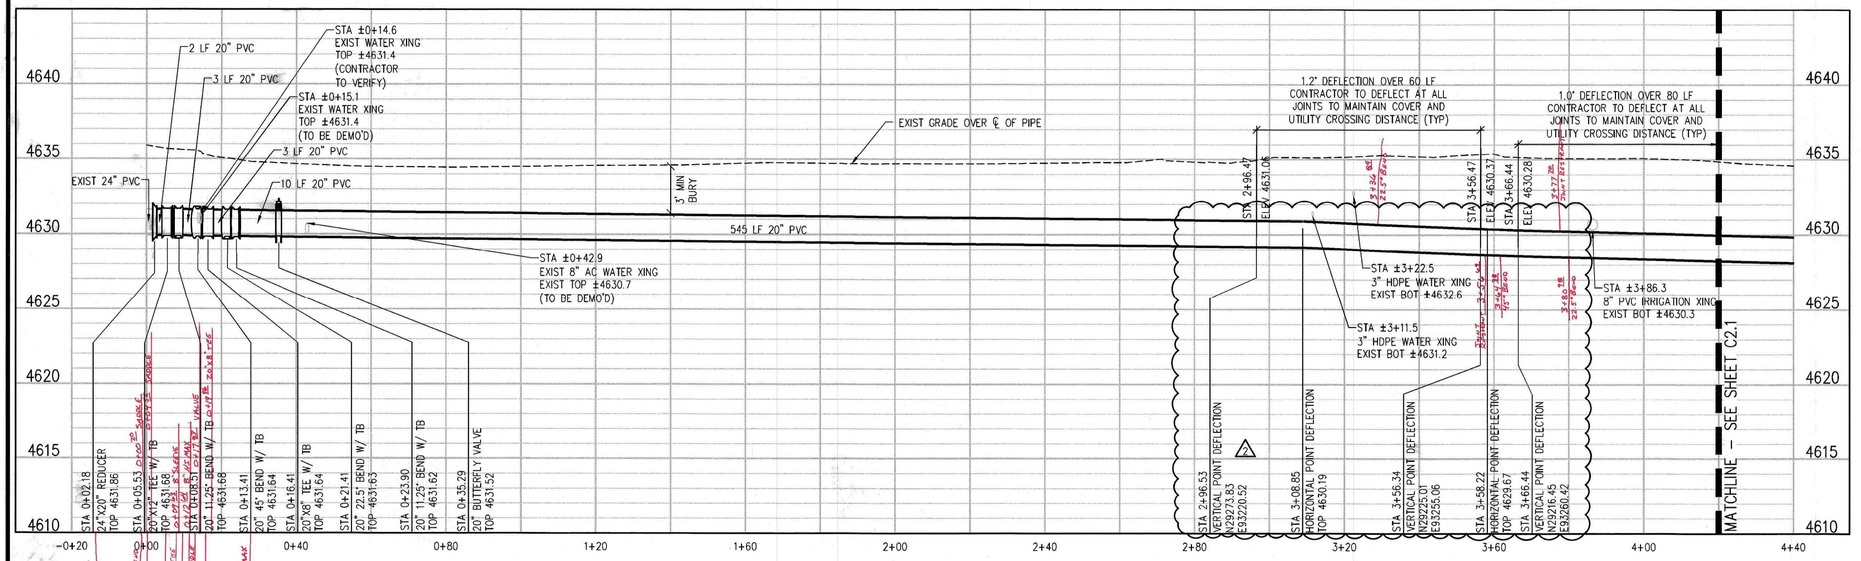

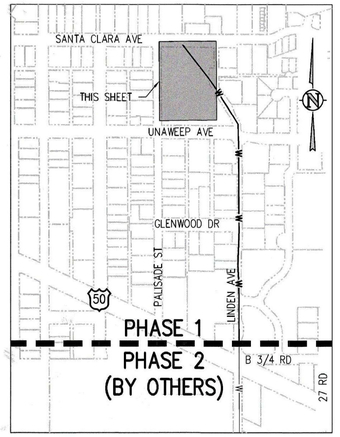

KEY MAP
NTS

CONSTRUCTION NOTES

1. 202 - REMOVAL OF ASPHALT MAT. CUT AND REMOVE ASPHALT AS SHOWN. (INDICATED BY DOT HATCH PATTERN)
10. 202 - REMOVAL OF LANDSCAPE GROUND COVER AND ANY UNDERLYING BARRIER. STOCKPILE PER PROPERTY OWNERS RECOMMENDATION.
12. 202 - REMOVAL OF FENCE AS SHOWN. (HEIGHT AND MATERIAL AS SHOW ON PLAN)
20. 202 - ABANDON PIPE. ABANDON BY PLUGGING REMAINING ENDS WITH CONCRETE.
20.5. 202 - ABANDON PIPE. ABANDON BY PLUGGING REMAINING ENDS WITH CONCRETE. GROUT INJECT EXIST PIPE AT 50' INTERVALS
100. 210 - RESET LANDSCAPE GROUND COVER. CONTRACTOR SHALL REMOVE GROUND COVER AND ANY UNDERLYING WEED BARRIER AS NEEDED AND STOCKPILE MATERIALS. CONTRACTOR SHALL RESET THESE MATERIALS AND PROVIDE ADDITIONAL MATERIALS AS NEEDED TO RESTORE LANDSCAPING.
102. 210 - RESET FENCE. (HEIGHT AND MATERIAL AS SHOW ON PLAN)
400. 102.7/108.2 - WATER MAIN PIPE (C-900 PVC) (SIZE AS SHOWN). INCLUDES TYPE A BEDDING AND HAUNCHING MATERIAL AND BACKFILL OF TRENCH WITH NATIVE MATERIALS MEETING 103.16 EARTH BACKFILL MATERIAL..
403. 102.8B/108.3 - GATE VALVE. (SIZE AS SHOWN)
404. 102.8E/108.3 - BUTTERFLY VALVE (SIZE AS SHOWN).
407. 102.8/108.3 - TEE (SIZE AS SHOWN).
409. 102.8/108.3 - ELBOW (SIZE AND ANGLE AS SHOWN)
410. 102.8/108.3 - END CAP / PLUG (SIZE AS SHOWN).
411. 102.8/108.3 - REDUCER (SIZE AS SHOWN).
426. CONNECT TO EXISTING WATER PIPE/VALVE/FITTING. THE CONTRACT UNIT PRICE FOR WATER PIPE SHALL INCLUDE THE COST OF CONNECTION TO EXISTING PIPELINE
427. DEFLECT PIPE AS SHOWN.
663. 304 - AGGREGATE BASE COURSE (CLASS 6) (6" THICK)
683. 401.08 - HOT BITUMINOUS PAVEMENT (PATCHING) (6" THICK) (GRADING SX, BINDER GRADE PG 64-22) (THREE 2" LIFTS)
826. PROTECT EXISTING UTILITY LINE IN PLACE.

GROUT INJECTION NOTES:

1. THE GROUT INJECTION PORT LOCATIONS ARE APPROXIMATE.
2. CONTRACTOR TO SUBMIT GROUT INJECTION PLAN TO CITY FOR REVIEW AND APPROVAL. AT A MINIMUM THE PLAN SHOULD INCLUDE
   - APPROXIMATE SPACING AND LOCATIONS
   - MATERIAL SPECIFICATIONS
   - SCHEDULE AND GROUTING PLAN
   - SUBCONTRACTOR INFORMATION

DESCRIPTION	DATE
REVISION 1	
REVISION 2 RFI #1 UPDATED DEFLECTION & CP INFO	02/05/25
REVISION 3	
REVISION 4	

DRAWN BY ZCF/NLM DATE
DESIGNED BY ZCF/AMF DATE
CHECKED BY JJM DATE
APPROVED BY DATE

SCALES: PLAN & PROFILE
HORIZONTAL 1" = 20' SCALE IN FEET
VERTICAL 1" = 5' SCALE IN FEET

CITY OF Grand Junction COLORADO

JVA, Inc.
817 Colorado Avenue, Suite 301
Glenwood Springs, CO 81601
970.404.3100
www.jvajva.com
CONSULTING ENGINEERS
Boulder • Fort Collins • Winter Park
Glenwood Springs • Denver

LINDEN AVE TRANSMISSION LINE REPLACEMENT – PHASE 1
LINDEN AVE WATERLINE PLAN AND PROFILE

C2.0