

M E M O R A N D U M

TO: Mark Achen  
FROM: Jim Shanks  
DATE: May 7, 1986  
RE: Redlands -- Sewer Customer Potential

RECEIVED MAY 8 1986

As a part of their Redlands Plan the County Planning Department prepared the attached priority map for new sewer service. This map showed 9 areas that were targeted for sewer service in the future.


The two largest areas were the Redlands Village area and the Scenic School area. The number of existing homes in these areas are approximately 270 and 420 respectively.

The yearly revenue from an additional 690 customers at the existing rates would be \$49,680 per year for the "backbone" system.

The other 7 identified areas have much lower potential for new sewer customers.

JSL:pb

Attachment

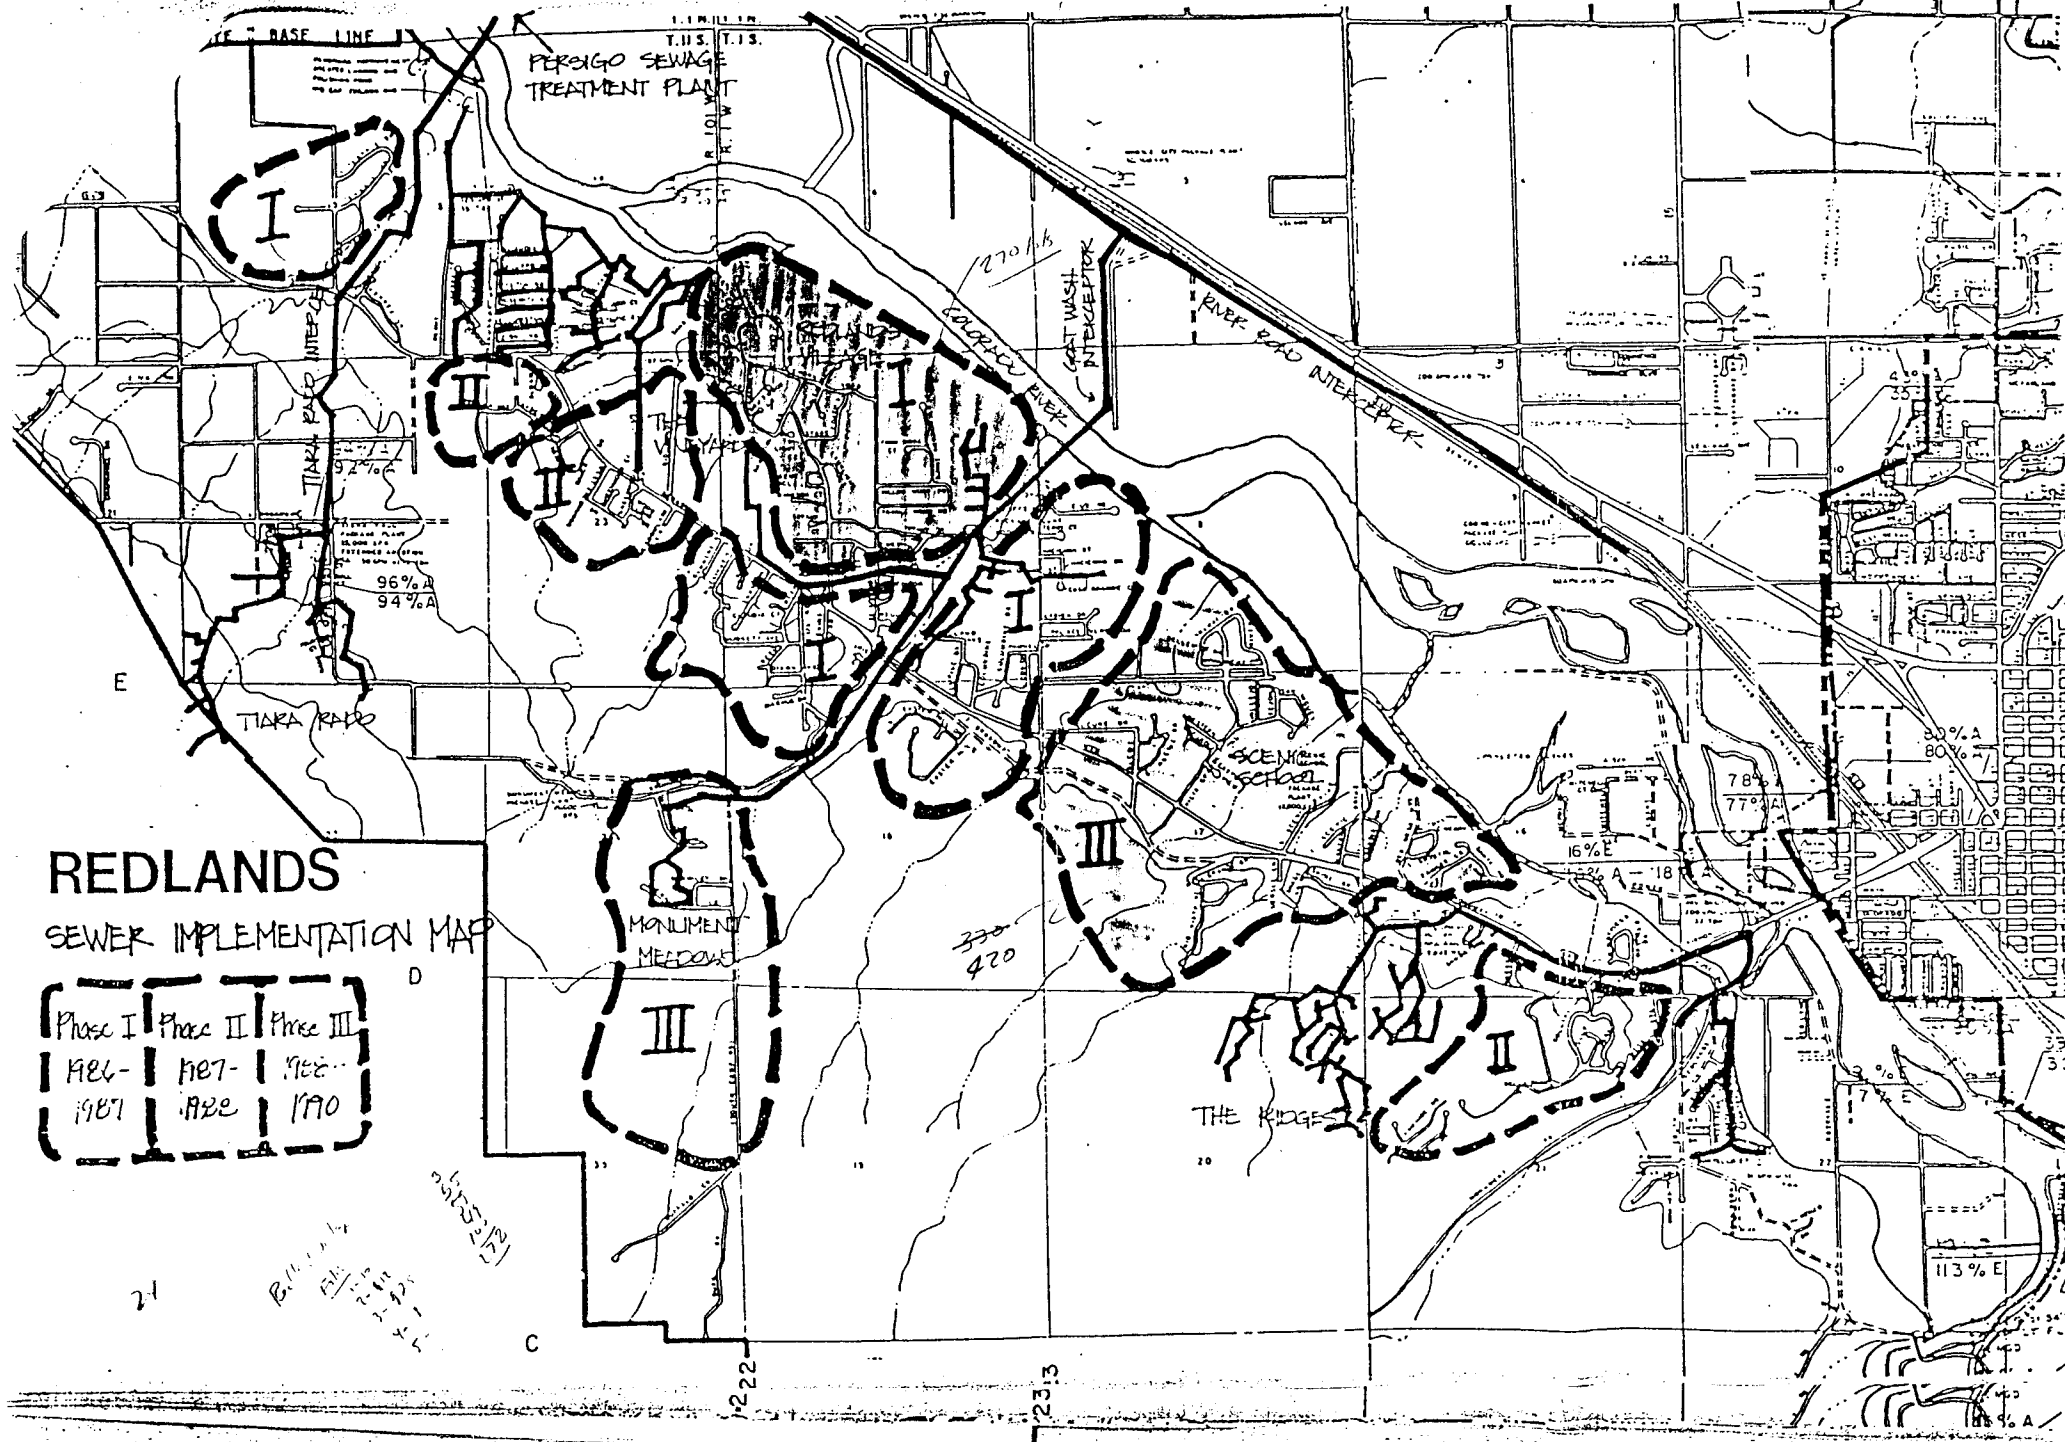

**REDLANDS**  
SEWER IMPLEMENTATION MAP

Phase I	Phase II	Phase III

21

65125213  
 BILLI  
 11/22/87  
 11/22/87

222

233

C

D

E

T.15.  
T.15.  
R.101A

PERSIGO SEWAGE  
TREATMENT PLANT

TIARA ROAD

MONUMENT  
MEADOWS

THE RIDGES

III

III

II

I

96% A  
94% A

78

77

16% E

18% A

113% E

100% A

330  
420

270

RIVER ROAD INTERCEPTOR

GOLF WASH INTERCEPTOR


TIARA ROAD INTERCEPTOR

BASE LINE