

DATE SUBMITTED: 6/1/88

PERMIT # _____

Hob Nob
Second Hand

FEE 5.00

FENCE PERMIT

GRAND JUNCTION PLANNING DEPARTMENT

BLDG ADDRESS: 124 N. 7th

TAX SCHEDULE #: 2945-144-17-003

PROPERTY OWNER: Amora Bley / Hob Nob

PHONE: _____


CONTRACTOR: Alice Higgins - Hob Nob

PHONE: 243-2447

MATERIAL: wood

HEIGHT: 6'

* PLOT PLAN

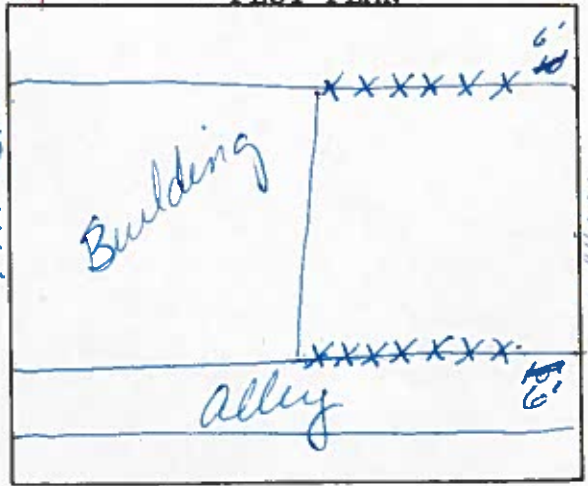

*Showing Property Line Dimensions, Easements, Streets, all Structures, and Setbacks from Property Lines.

FOR OFFICE USE ONLY

ZONE: B-3

SETBACKS: F _____ S _____ R _____

SPECIAL CONDITIONS: from the N/S alley back 6' the fence should be either chain link or graded down to 2.5'

FINAL PERMIT

WILL REQUIRE SEPARATE PERMIT FROM THE CITY/COUNTY BUILDING DEPARTMENT.

ANY MODIFICATION TO THIS APPROVED FENCE PERMIT MUST BE APPROVED, IN WRITING, BY THIS DEPARTMENT.

I HEREBY ACKNOWLEDGE THAT I HAVE READ THIS APPLICATION AND THE ABOVE IS CORRECT, AND I AGREE TO COMPLY WITH THE REQUIREMENTS ABOVE. FAILURE TO COMPLY SHALL RESULT IN LEGAL ACTION.

Alice Higgins
SIGNATURE

APPROVED BY: Kathy Poston

DATE APPROVED: 6/1/88