

DATE SUBMITTED: 6-15-92

PERMIT # _____

FEE 5⁰⁰

FENCE PERMIT

GRAND JUNCTION PLANNING DEPARTMENT

*PAID
Receipt
2823*

BLDG ADDRESS: 932 Colorado

TAX SCHEDULE #: 2945 144 22 013

PROPERTY OWNER: Joe Redwood POA Held by
Adrienne Barrett


PHONE: 245-0769

CONTRACTOR: Self

PHONE: 245-0769

MATERIAL: Cedar

HEIGHT: 6'

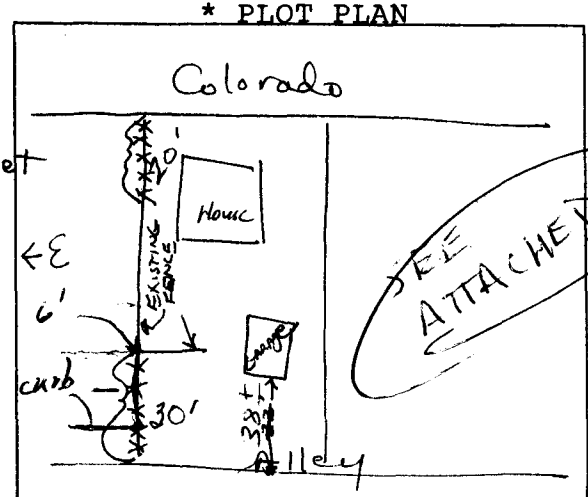

*Showing Property Line Dimensions, Easements, Streets, all Structures, and Setbacks from Property Lines.

FOR OFFICE USE ONLY

ZONE: B-1

SETBACKS: F _____ S _____ R _____

SPECIAL CONDITIONS: _____

FINAL PERMIT

WILL REQUIRE SEPARATE PERMIT FROM THE CITY/COUNTY BUILDING DEPARTMENT.

ANY MODIFICATION TO THIS APPROVED FENCE PERMIT MUST BE APPROVED, IN WRITING, BY THIS DEPARTMENT.

I HEREBY ACKNOWLEDGE THAT I HAVE READ THIS APPLICATION AND THE ABOVE IS CORRECT, AND I AGREE TO COMPLY WITH THE REQUIREMENTS ABOVE. FAILURE TO COMPLY SHALL RESULT IN LEGAL ACTION.

by Engineer J. Don Newton

J. Marie Shogren
SIGNATURE

APPROVED BY: [Signature]

DATE APPROVED: 6-17-92


CURB 2

Colorado Ave

sidewalk

3'

6' 5"

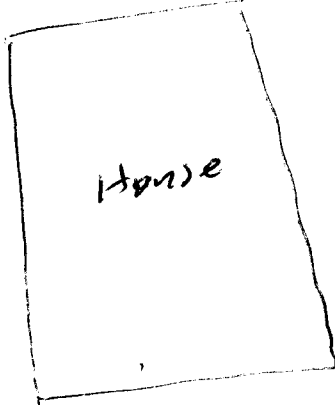

House



Garage

6' fence ok

transition fence from 6' to 30" height

existing fence and curb

South edge of Alley

10' +/-

