

DATE SUBMITTED: 5/5/93

PERMIT # _____

FEE 5.00

FENCE PERMIT

GRAND JUNCTION PLANNING DEPARTMENT

BLDG ADDRESS: 638 Annison ave

TAX SCHEDULE #: 2945-142-19-006

PROPERTY OWNER: Peter Robinson


PHONE: 242-3647 WK-241-9156

CONTRACTOR: J & Fence Co

PHONE: 243-2723

MATERIAL: Chain/wood

HEIGHT: 48" - 72"

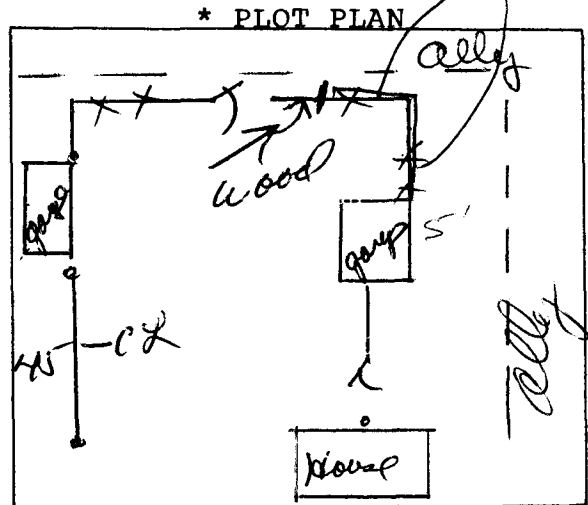

*Showing Property Line Dimensions, Easements, Streets, all Structures, and Setbacks from Property Lines.

All fencing in back yard also, inside property line

FOR OFFICE USE ONLY

ZONE: PR-8

SETBACKS: F _____ S _____ R _____

SPECIAL CONDITIONS: 15' triangle



FINAL PERMIT



WILL REQUIRE SEPARATE PERMIT FROM THE CITY/COUNTY BUILDING DEPARTMENT.

*For solid wood → from asphalt at alleyway
Required per traffic engineering.
Chain link OK - no triangle necessary*

ANY MODIFICATION TO THIS APPROVED FENCE PERMIT MUST BE APPROVED, IN WRITING, BY THIS DEPARTMENT.

I HEREBY ACKNOWLEDGE THAT I HAVE READ THIS APPLICATION AND THE ABOVE IS CORRECT, AND I AGREE TO COMPLY WITH THE REQUIREMENTS ABOVE. FAILURE TO COMPLY SHALL RESULT IN LEGAL ACTION.

[Signature]
SIGNATURE

APPROVED BY: [Signature]

DATE APPROVED: 5/7/93