


② HOSPITALITY LEVEL SIGNAGE PLAN
1/8" = 1'-0"

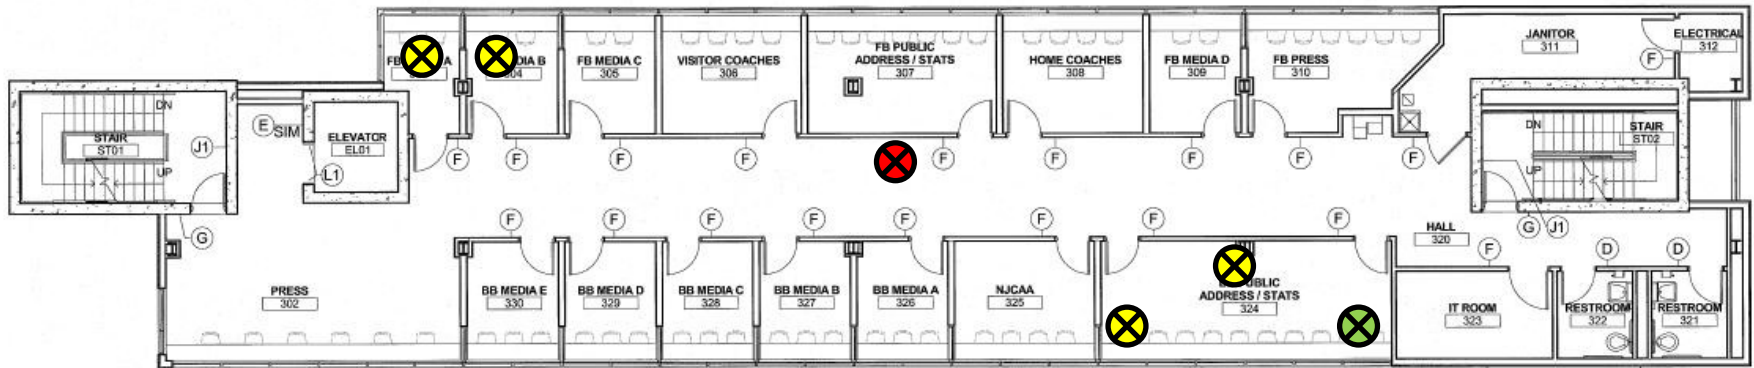

① PRESS BOX LEVEL SIGNAGE PLAN
1/8" = 1'-0"

- ⊗ Phone for dugouts and commissioner box communication
- ⊗ Cisco IP Phone 7942—A total of 4 phones
- ⊗ Cisco Aironet LWAPP Access Point—AIR-LAP1242G-A-K9

There are a total of 3 of these Cisco Access Points at the stadium. There is one more mounted in the concourse level of the stadium.