

FEE \$10.00


FENCE PERMIT

GRAND JUNCTION COMMUNITY DEVELOPMENT DEPARTMENT

THIS SECTION TO BE COMPLETED BY APPLICANT

PLOT PLAN

PROPERTY ADDRESS 1945 Chipeta Ct.
 TAX SCHEDULE NO 2945-131-19-030
 PROPERTY OWNER R.L. & Jean D. Slaven
 OWNER'S PHONE 243-0683
 OWNER'S ADDRESS 548 T. Ann Dr.
 CONTRACTOR -
 CONTRACTOR'S PHONE -
 FENCE MATERIAL Brac + 7 posts
 FENCE HEIGHT 4'

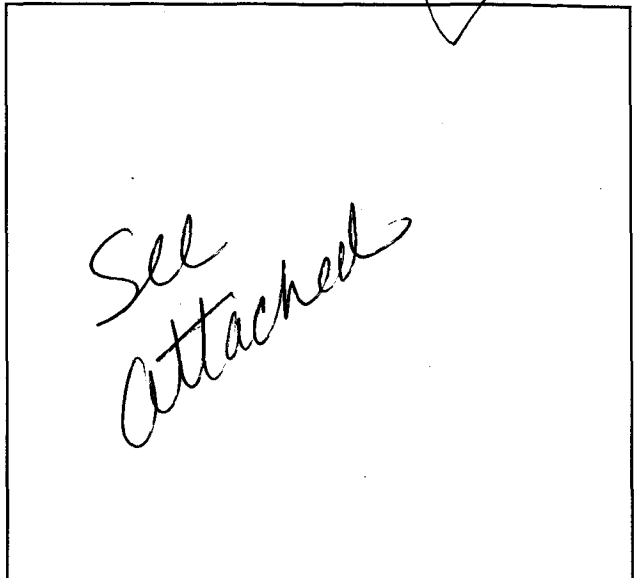

Plot plan must show property lines and property dimensions, all easements, all rights-of-way, all structures, all setbacks from property lines, & fence height(s).

THIS SECTION TO BE COMPLETED BY COMMUNITY DEVELOPMENT DEPARTMENT STAFF

ZONE RSF-8
 SPECIAL CONDITIONS /

SETBACKS: Front _____ from property line (PL) or
 _____ from center of ROW, whichever is greater.
 Side _____ from PL Rear _____ from PL

Fences exceeding six feet in height require a separate permit from the City/County Building Department. A fence constructed on a corner lot that extends past the rear of the house along the side yard or abuts an alley requires approval from the City Engineer (Section 5-5-5B of the Grand Junction Zoning and Development Code).

The owner/applicant must correctly identify all property lines, easements, and rights-of-way and ensure the fence is located within the property's boundaries. Covenants, conditions, restrictions, easements and/or rights-of-way may restrict or prohibit the placement of fence(s). The owner/applicant is responsible for compliance with covenants, conditions, and restrictions which may apply. Fences built in easements may be subject to removal at the property owner's sole and absolute expense. Any modification of design and/or material as approved in this fence permit must be approved, in writing, by the Community Development Department Director.

I hereby acknowledge that I have read this application and the information and plot plan are correct; I agree to comply with any and all codes, ordinances, laws, regulations, or restrictions which apply.

I understand that failure to comply shall result in legal action which may include but not necessarily be limited to removal of the fence(s) at the owner's cost.

Applicant's Signature R.L. Slaven

Date 5-12-97

Community Development's Approval Marcia Rabideaux

Date 5-13-97

City Engineer's Approval (if required) _____


Date _____

VALID FOR SIX MONTHS FROM DATE OF ISSUANCE (Section 9-3-2D Grand Junction Zoning & Development Code)

(White: Community Development)

(Yellow: Code Enforcement)

(Pink: Customer)

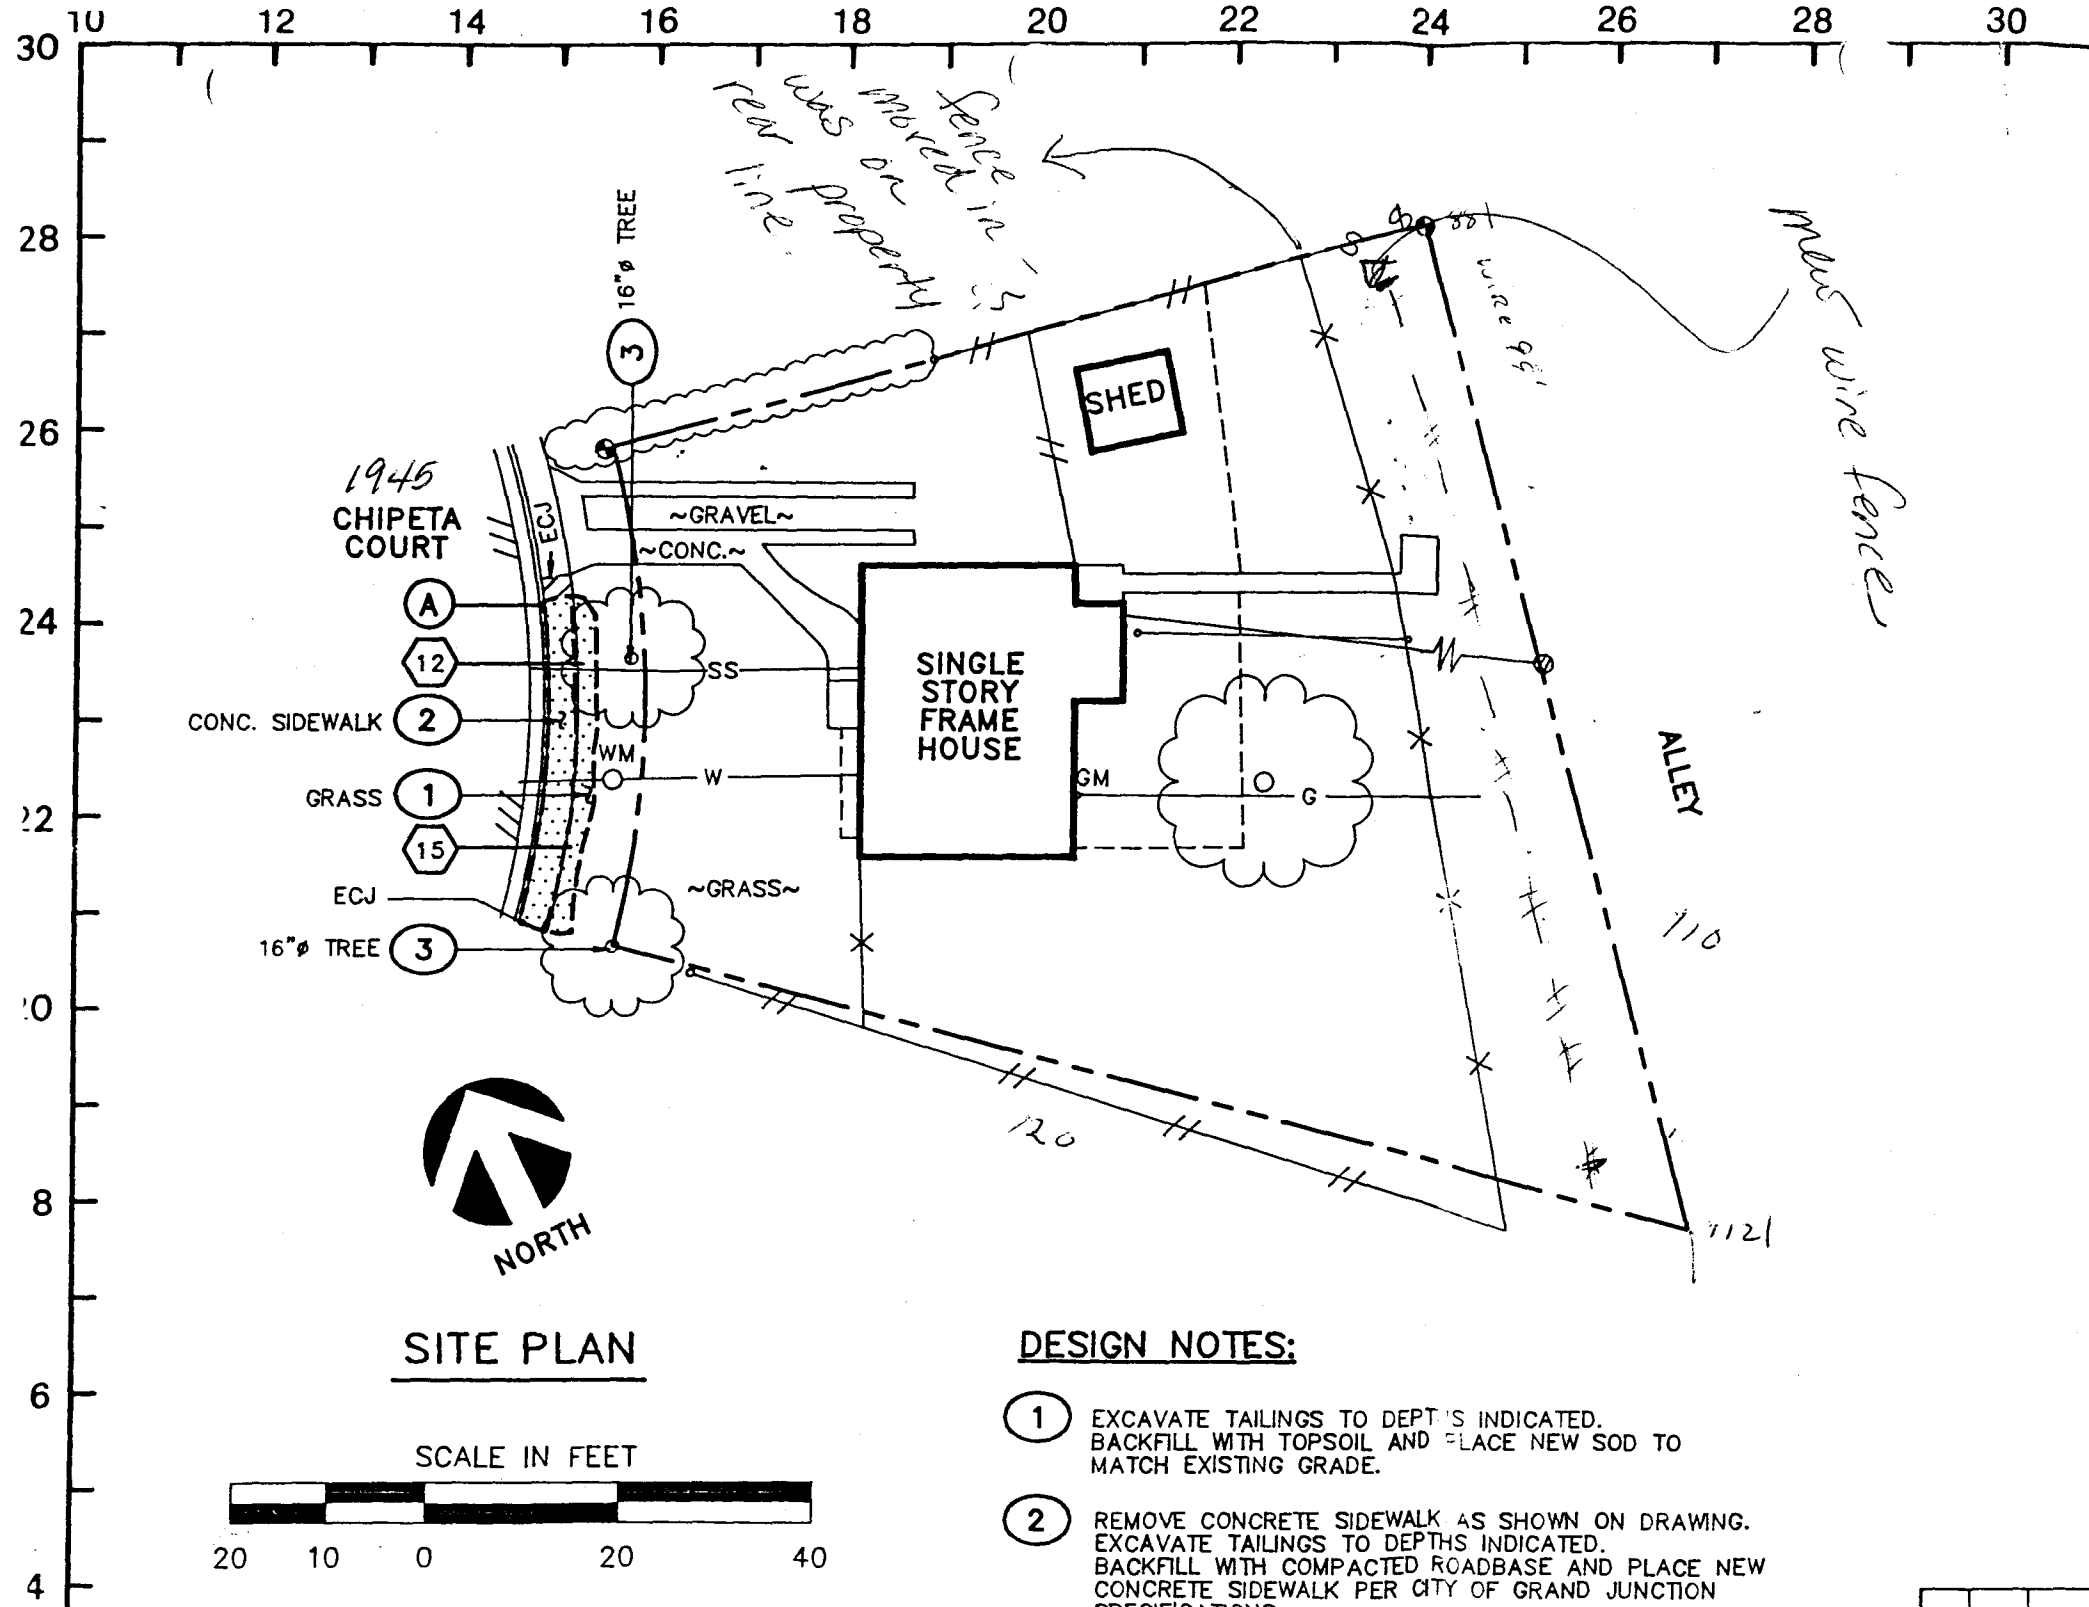

SITE PLAN

SCALE IN FEET



DESIGN NOTES:

- ① EXCAVATE TAILINGS TO DEPT'S INDICATED. BACKFILL WITH TOPSOIL AND PLACE NEW SOD TO MATCH EXISTING GRADE.
- ② REMOVE CONCRETE SIDEWALK AS SHOWN ON DRAWING. EXCAVATE TAILINGS TO DEPTHS INDICATED. BACKFILL WITH COMPACTED ROADBASE AND PLACE NEW CONCRETE SIDEWALK PER CITY OF GRAND JUNCTION SPECIFICATIONS.