

FEE \$10.00

PERMIT # 10063


### FENCE PERMIT

GRAND JUNCTION COMMUNITY DEVELOPMENT DEPARTMENT

THIS SECTION TO BE COMPLETED BY APPLICANT

PLOT PLAN

PROPERTY ADDRESS 2724 Hwy 50  
 TAX SCHEDULE NO 2945-252-15-003  
 PROPERTY OWNER Steve Anthony (Lesa)  
 OWNER'S PHONE 245-5085  
 OWNER'S ADDRESS 6000 Noland Ave. (H)  
 CONTRACTOR \_\_\_\_\_  
 CONTRACTOR'S PHONE \_\_\_\_\_  
 FENCE MATERIAL wire w/ shade cloth  
 FENCE HEIGHT 6 ft.

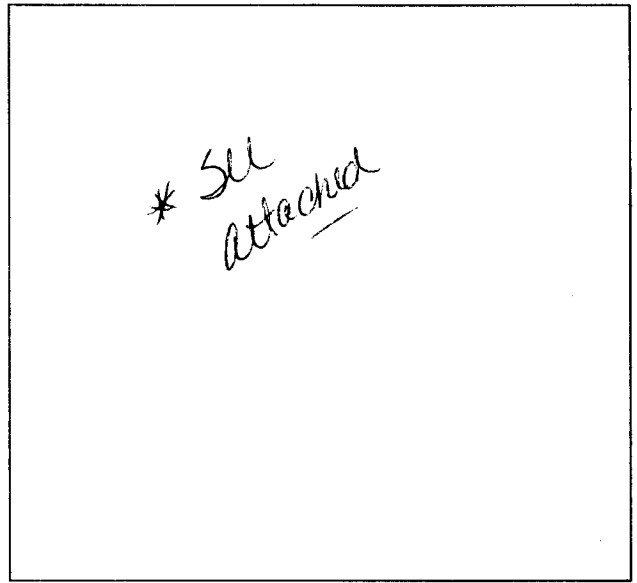

Plot plan must show property lines and property dimensions, all easements, all rights-of-way, all structures, all setbacks from property lines, & fence height(s).

THIS SECTION TO BE COMPLETED BY COMMUNITY DEVELOPMENT DEPARTMENT STAFF

ZONE H.O.  
 SPECIAL CONDITIONS \_\_\_\_\_  
 \_\_\_\_\_

SETBACKS: Front \_\_\_\_\_ from property line (PL) or  
 \_\_\_\_\_ from center of ROW, whichever is greater.  
 Side \_\_\_\_\_ from PL Rear \_\_\_\_\_ from PL

Fences exceeding six feet in height require a separate permit from the City/County Building Department. A fence constructed on a corner lot that extends past the rear of the house along the side yard or abuts an alley requires approval from the City Engineer (Section 5-5-5B of the Grand Junction Zoning and Development Code).

The owner/applicant must correctly identify all property lines, easements, and rights-of-way and ensure the fence is located within the property's boundaries. Covenants, conditions, restrictions, easements and/or rights-of-way may restrict or prohibit the placement of fence(s). The owner/applicant is responsible for compliance with covenants, conditions, and restrictions which may apply. Fences built in easements may be subject to removal at the property owner's sole and absolute expense. Any modification of design and/or material as approved in this fence permit must be approved, in writing, by the Community Development Department Director.

I hereby acknowledge that I have read this application and the information and plot plan are correct; I agree to comply with any and all codes, ordinances, laws, regulations, or restrictions which apply.


I understand that failure to comply shall result in legal action, which may include but not necessarily be limited to removal of the fence(s) at the owner's cost.

Applicant's Signature [Signature]  
 Community Development's Approval [Signature]  
 City Engineer's Approval (if required) \_\_\_\_\_

Date 7-8-97  
 Date 7-8-97  
 Date \_\_\_\_\_

VALID FOR SIX MONTHS FROM DATE OF ISSUANCE (Section 9-3-2D Grand Junction Zoning & Development Code)

(White: Community Development) (Yellow: Code Enforcement) (Pink: Customer)

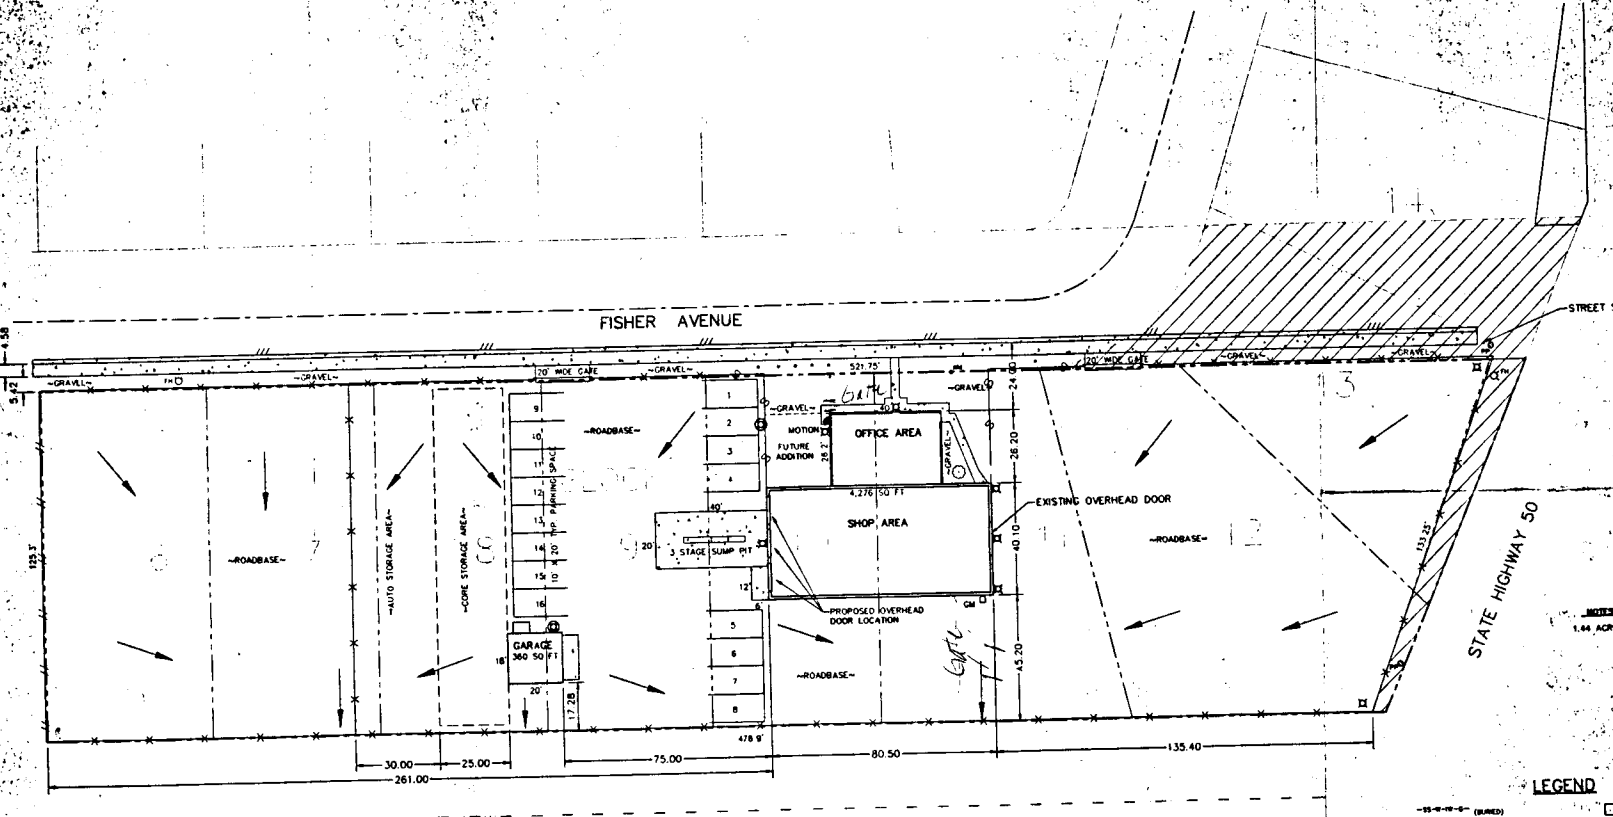

*EXISTING FENCES  
TO REPLACE  
"New" fencing*

**LEGEND**

- 15'-10'-0" (BURRED)
- E-1-10'-0" (ELEC./FEE/CABLE TV/UNBURRED)
- 10'-0" (OVERHEAD WIRING)
- (PROPERTY LINE)
- (SURFACE COVER BOUNDARY)
- (DITCH)
- (WOOD/PAVE/CHALKLINE FENCE)
- /// (EDGE OF ASPHALT)
- (DRAINAGE FLOW)
- (FUTURE ADDITION)
- (EXISTING CONCRETE IN PLACE)
- D (WATER VALVE)
- (FIRE HYDRANT (FWS))
- ⊕ (SPRINKLER HEAD)
- ⊖ (WATER METER)
- ⊗ (GAS METER)
- (UTILITY POLE (FWS))
- (TREE)
- ▨ (DEDICATED AREA)
- (4" DIA. HOLLOW (FWS))
- ⊕ (LIGHTS)
- ⊕ (FUTURE VARIOUS LIGHT)



**SITE PLAN**

<b>B &amp; B TRANSMISSION, -INC.</b>		<b>ARTESIA HEIGHTS</b>	
		SITE PLAN	
DATE	2-87	2724 HIGHWAY 50	
PROJECT NO.		GRAND JUNCTION, COLORADO	
DATE	97003	C1	
DATE	8897003-0		

1.64 ACRES