

FEE \$10.00

PERMIT # 11362




FENCE PERMIT
GRAND JUNCTION COMMUNITY DEVELOPMENT DEPARTMENT

THIS SECTION TO BE COMPLETED BY APPLICANT

PLOT PLAN

PROPERTY ADDRESS 456 N. 16th St
TAX SCHEDULE NO. 2945-132-18-001
PROPERTY OWNER Greg Howell
OWNER'S PHONE
OWNER'S ADDRESS 456 N. 16th St
CONTRACTOR Becky M. Francis & Son
CONTRACTOR'S PHONE 858-3816
CONTRACTOR'S ADDRESS 824 E. McQuarrie
Fence Material Cedar
FENCE MATERIAL Cedar
FENCE HEIGHT 6' Privacy

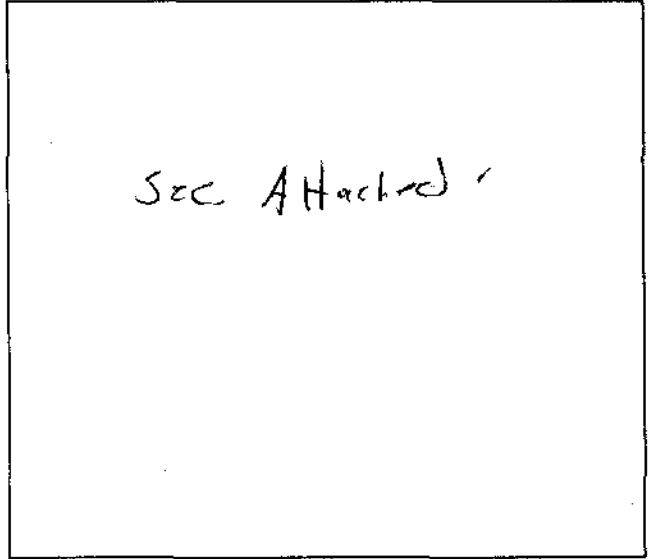

Plot plan must show property lines and property dimensions, all easements, all rights-of-way, all structures, all setbacks from property lines, & fence height(s).

THIS SECTION TO BE COMPLETED BY COMMUNITY DEVELOPMENT DEPARTMENT STAFF

ZONE RSF-8
SPECIAL CONDITIONS angled @ alley for sight triangle

SETBACKS: Front 20' from property line (PL) or from center of ROW, whichever is greater. Side 0' from PL Rear 0' from PL

Fences exceeding six feet in height require a separate permit from the City/County Building Department. A fence constructed on a corner lot that extends past the rear of the house along the side yard or abuts an alley requires approval from the City Engineer (Section 5-5-5B of the Grand Junction Zoning and Development Code).

The owner/applicant must correctly identify all property lines, easements, and rights-of-way and ensure the fence is located within the property's boundaries. Covenants, conditions, restrictions, easements and/or rights-of-way may restrict or prohibit the placement of fence(s). The owner/applicant is responsible for compliance with covenants, conditions, and restrictions which may apply. Fences built in easements may be subject to removal at the property owner's sole and absolute expense. Any modification of design and/or material as approved in this fence permit must be approved, in writing, by the Community Development Department Director.

I hereby acknowledge that I have read this application and the information and plot plan are correct; I agree to comply with any and all codes, ordinances, laws, regulations, or restrictions which apply.

I understand that failure to comply shall result in legal action, which may include but not necessarily be limited to removal of the fence(s) at the owner's cost.

Applicant's Signature [Signature]
Community Development's Approval Bonnie Edwards
City Engineer's Approval (if required) N/A

Date 9-1-99
Date 9-1-99
Date


VALID FOR SIX MONTHS FROM DATE OF ISSUANCE (Section 9-3-2D Grand Junction Zoning & Development Code)
(White: Planning) (Yellow: Customer) (Pink: Code Enforcement)

EXISTING FENCE.
SOUTH PROPERTY LINE

James
6/11/99

ALLEY
WAY

456 N. 16th St.

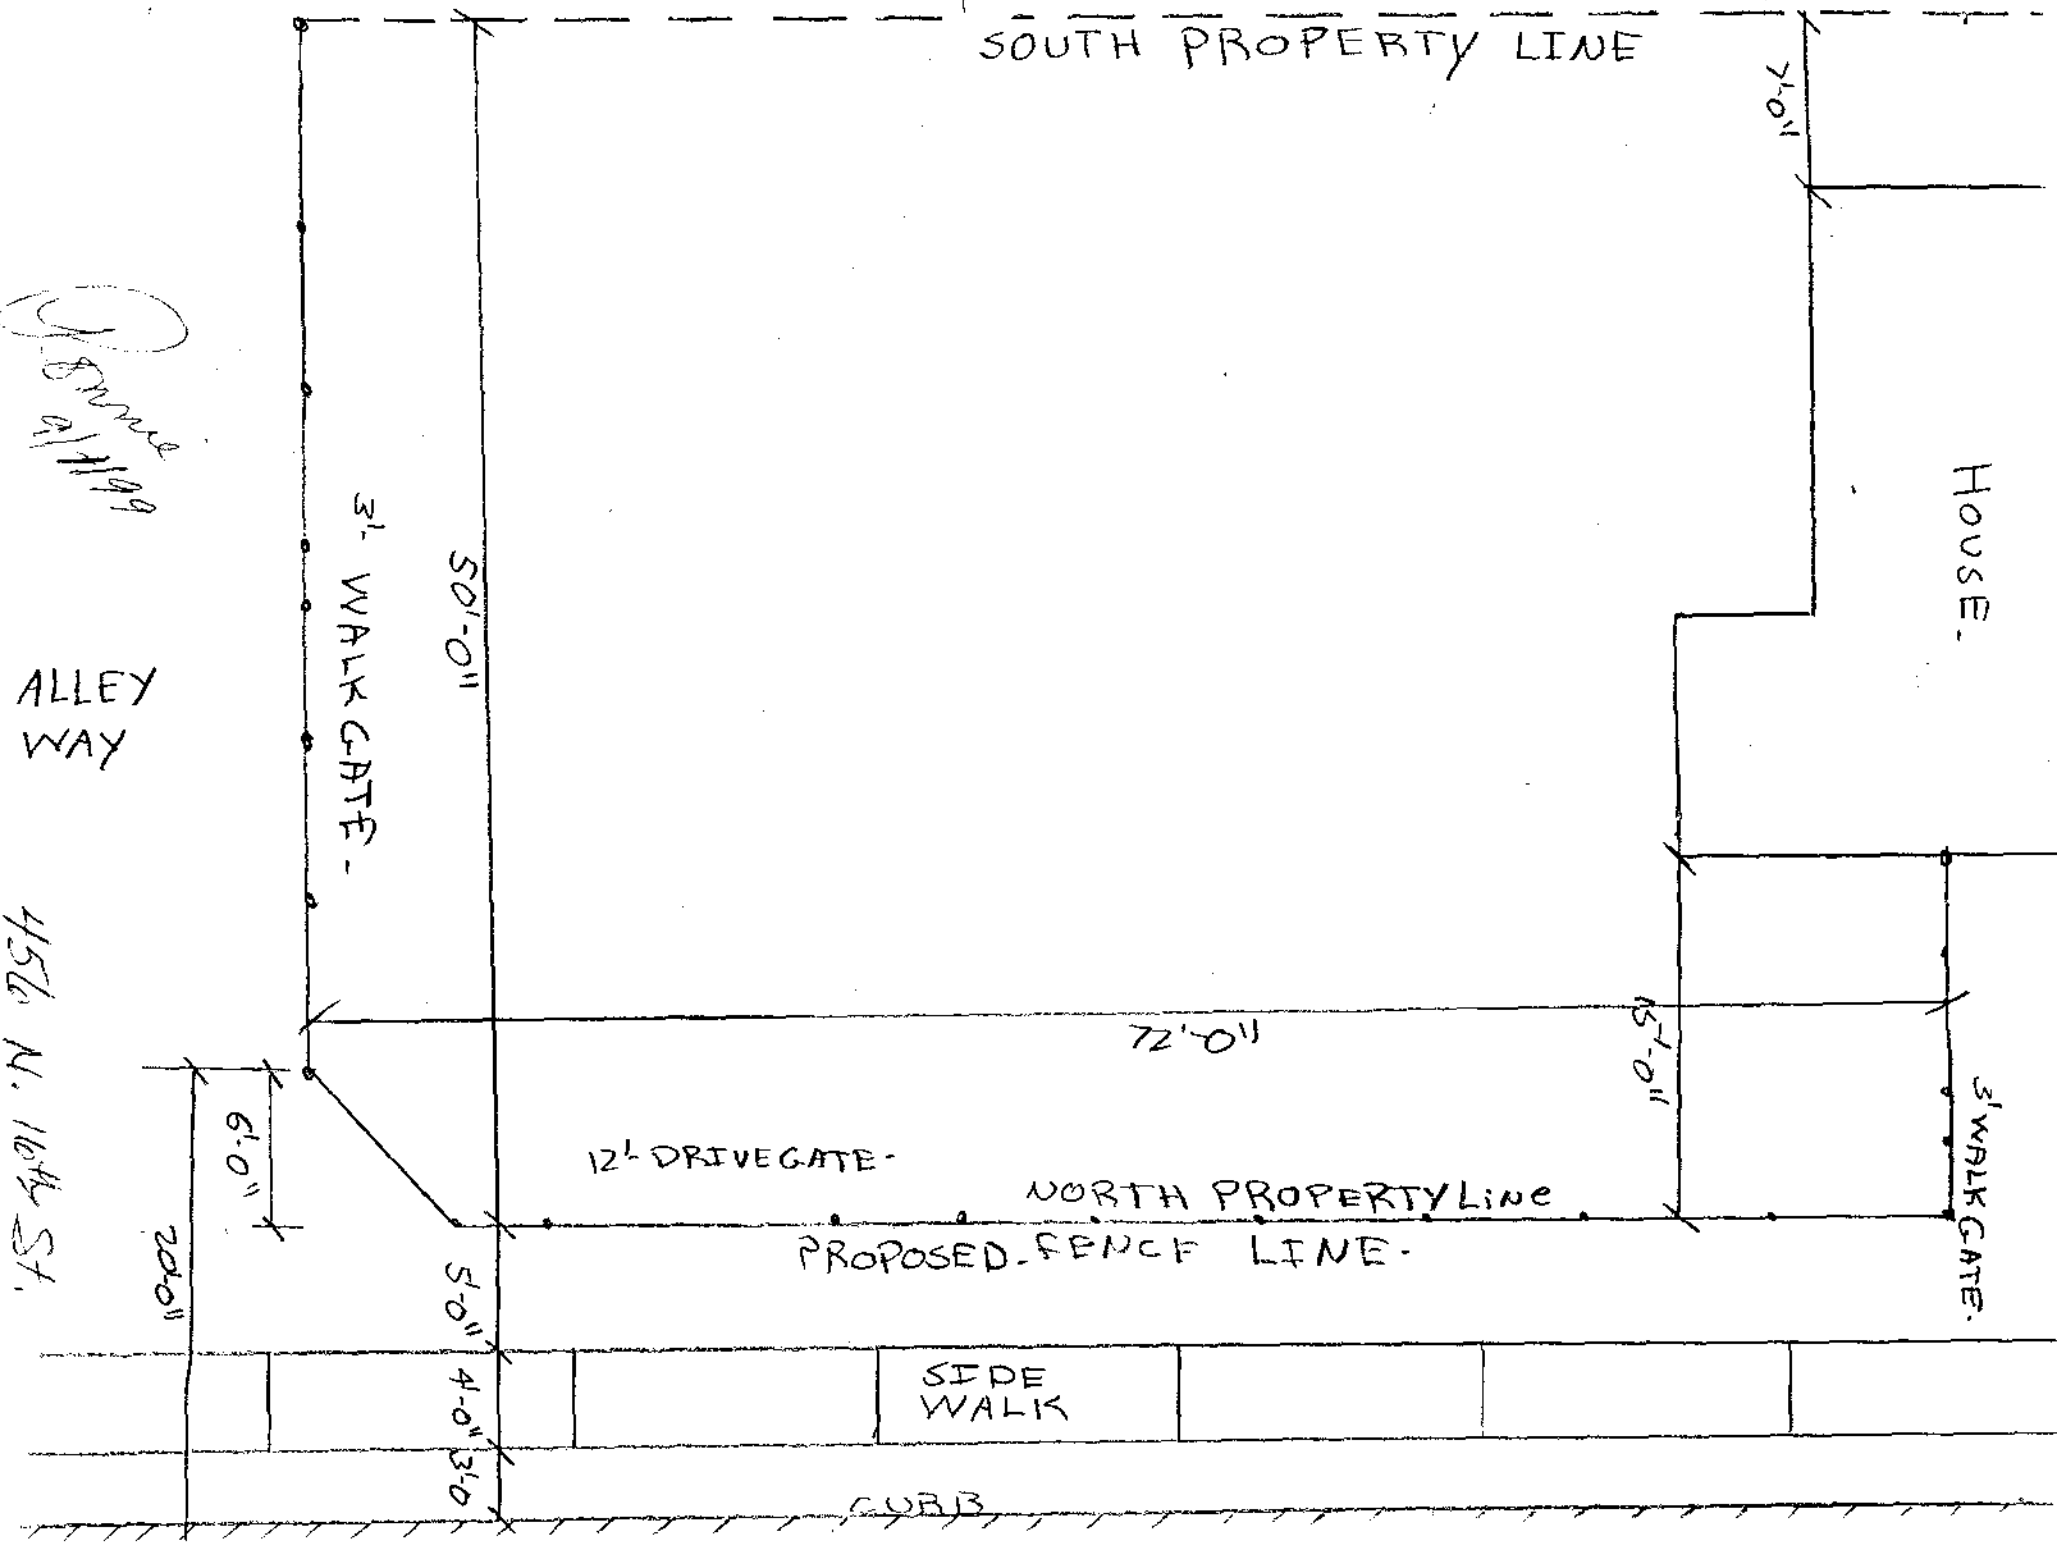

3' WALK GATE

50'-0"

12' DRIVE GATE

72'-0"

NORTH PROPERTY LINE

PROPOSED FENCE LINE

15'-0"

7'-0"

HOUSE

3' WALK GATE

SIDE WALK

CURB

20'-0"

5'-0"

4'-0"

3'-0"