

FEE \$10.00

PERMIT # 11352



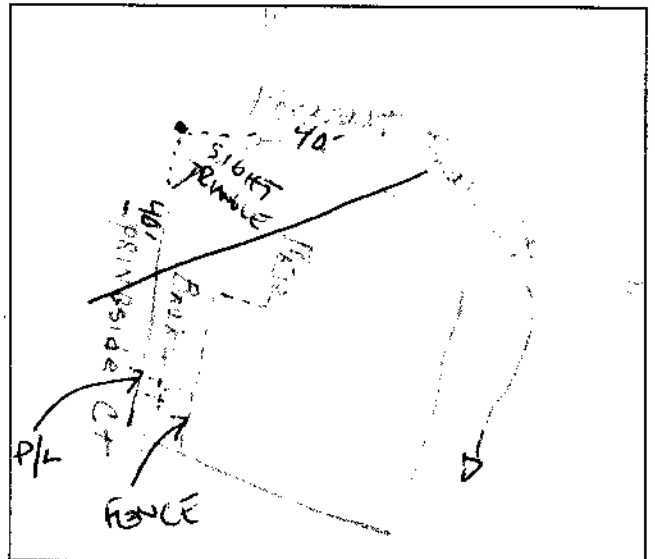
69

FENCE PERMIT

GRAND JUNCTION COMMUNITY DEVELOPMENT DEPARTMENT

THIS SECTION TO BE COMPLETED BY APPLICANT

PLOT PLAN

PROPERTY ADDRESS 2430 Pheasant Trail CourtTAX SCHEDULE NO 2945-014-90-005PROPERTY OWNER Eleanor R WyattOWNER'S PHONE 241-3621OWNER'S ADDRESS 2430 Pheasant Trail CtCONTRACTOR MARATHA FencingCONTRACTOR'S PHONE 241-4303CONTRACTOR'S ADDRESS 26028 Rd. Gr JctFENCE MATERIAL CedarFENCE HEIGHT 6'

Plot plan must show property lines and property dimensions, all easements, all rights-of-way, all structures, all setbacks from property lines, & fence height(s).

THIS SECTION TO BE COMPLETED BY COMMUNITY DEVELOPMENT DEPARTMENT STAFF

ZONE PR-8

SETBACKS: Front _____ from property line (PL) or
 _____ from center of RDW, whichever is greater.

SPECIAL CONDITIONS FENCE CANNOT BE

LOCATED IN 40' SIGHT TRIANGLE AT CORNER
 FOR FPA-1997-057

Side _____ from PL Rear _____ from PL

Fences exceeding six feet in height require a separate permit from the City/County Building Department. A fence constructed on a corner lot that extends past the rear of the house along the side yard or abuts an alley requires approval from the City Engineer (Section 5-5-5B of the Grand Junction Zoning and Development Code).

The owner/applicant must correctly identify all property lines, easements, and rights-of-way and ensure the fence is located within the property's boundaries. Covenants, conditions, restrictions, easements and/or rights-of-way may restrict or prohibit the placement of fence(s). The owner/applicant is responsible for compliance with covenants, conditions, and restrictions which may apply. Fences built in easements may be subject to removal at the property owner's sole and absolute expense. Any modification of design and/or material as approved in this fence permit must be approved, in writing, by the Community Development Department Director.

I hereby acknowledge that I have read this application and the information and plot plan are correct; I agree to comply with any and all codes, ordinances, laws, regulations, or restrictions which apply.

I understand that failure to comply shall result in legal action, which may include but not necessarily be limited to removal of the fence(s) at the owner's cost.

Applicant's Signature Eleanor R WyattDate 10-19-99Community Development's Approval Bill NellDate 10-18-99City Engineer's Approval (if required) [Signature]Date 10/18/99

VALID FOR SIX MONTHS FROM DATE OF ISSUANCE (Section 9-3-2D Grand Junction Zoning & Development Code)
 (White: Planning) (Yellow: Customer) (Pink: Code Enforcement)