

FEE \$10.00

PERMIT # 10742



28
+


FENCE PERMIT

GRAND JUNCTION COMMUNITY DEVELOPMENT DEPARTMENT

[Handwritten signature]

THIS SECTION TO BE COMPLETED BY APPLICANT

PROPERTY ADDRESS 2542 Shetland Ct. A+B
 TAX SCHEDULE NO 29415-(132.00)-138
 PROPERTY OWNER Richard Weber
 OWNER'S PHONE 245-6782
 OWNER'S ADDRESS 6800 Reeder Mesa Rd
 CONTRACTOR Rick Weber
 CONTRACTOR'S PHONE 260-3889
 CONTRACTOR'S ADDRESS 6800 Reeder Mesa Rd
 FENCE MATERIAL Cedar
 FENCE HEIGHT 6'

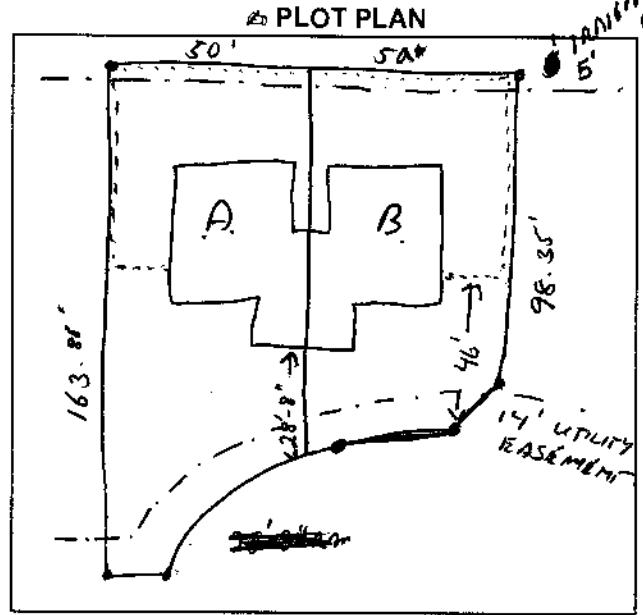

Plot plan must show property lines and property dimensions, all easements, all rights-of-way, all structures, all setbacks from property lines, & fence height(s).

THIS SECTION TO BE COMPLETED BY COMMUNITY DEVELOPMENT DEPARTMENT STAFF

ZONE RB-4.3
 SPECIAL CONDITIONS - easement violation in rear -

SETBACKS: Front 20' from property line (PL) or _____ from center of ROW, whichever is greater.
 Side 0' & 0' from PL Rear 0' from PL
on common wall

Fences exceeding six feet in height require a separate permit from the City/County Building Department. A fence constructed on a corner lot that extends past the rear of the house along the side yard or abuts an alley requires approval from the City Engineer (Section 5-5-5B of the Grand Junction Zoning and Development Code).

The owner/applicant must correctly identify all property lines, easements, and rights-of-way and ensure the fence is located within the property's boundaries. Covenants, conditions, restrictions, easements and/or rights-of-way may restrict or prohibit the placement of fence(s). The owner/applicant is responsible for compliance with covenants, conditions, and restrictions which may apply. Fences built in easements may be subject to removal at the property owner's sole and absolute expense. Any modification of design and/or material as approved in this fence permit must be approved, in writing, by the Community Development Department Director.

I hereby acknowledge that I have read this application and the information and plot plan are correct; I agree to comply with any and all codes, ordinances, laws, regulations, or restrictions which apply.

I understand that failure to comply shall result in legal action, which may include but not necessarily be limited to removal of the fence(s) at the owner's cost.

Applicant's Signature Aminda Weber
 Community Development's Approval Connie Edwards
 City Engineer's Approval (if required) N/A -

Date 5-17-99
 Date 5/17/99
 Date _____

VALID FOR SIX MONTHS FROM DATE OF ISSUANCE (Section 9-3-2D Grand Junction Zoning & Development Code)
(White: Planning) (Yellow: Customer) (Pink: Code Enforcement)