

FEE \$10.00

PERMIT # 11058

EX




FENCE PERMIT
GRAND JUNCTION COMMUNITY DEVELOPMENT DEPARTMENT

THIS SECTION TO BE COMPLETED BY APPLICANT

PLOT PLAN

PROPERTY ADDRESS 1150 Santa Clara - Units A-4
TAX SCHEDULE NO 2945-234-17-001
PROPERTY OWNER Contact Housing Casas Del Tierra
OWNER'S PHONE 241-4000
OWNER'S ADDRESS P.O. Box 2561 - Grand Jct, CO 81502
CONTRACTOR Maranetha Fencing
CONTRACTOR'S PHONE 241-9303
CONTRACTOR'S ADDRESS 260 28 Rd
FENCE MATERIAL Wood / chain Link
FENCE HEIGHT 6'

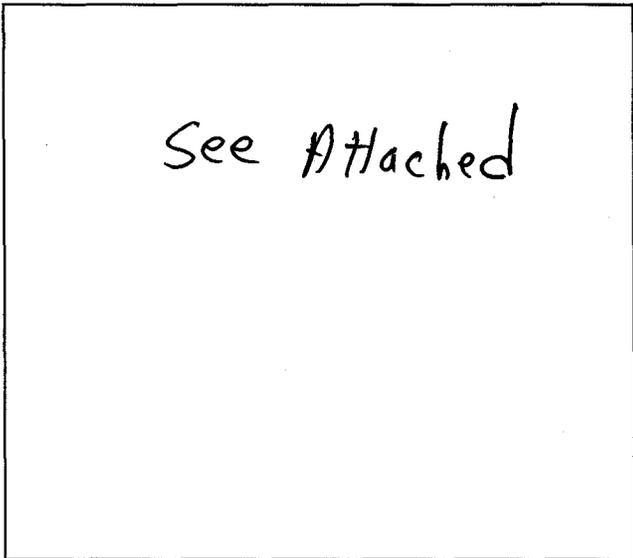

Plot plan must show property lines and property dimensions, all easements, all rights-of-way, all structures, all setbacks from property lines, & fence height(s).

THIS SECTION TO BE COMPLETED BY COMMUNITY DEVELOPMENT DEPARTMENT STAFF

ZONE RMF-100
SPECIAL CONDITIONS

SETBACKS: Front 20' from property line (PL) or
Side 5' from PL Rear 10' from PL

Fences exceeding six feet in height require a separate permit from the City/County Building Department. A fence constructed on a corner lot that extends past the rear of the house along the side yard or abuts an alley requires approval from the City Engineer (Section 5-5-5B of the Grand Junction Zoning and Development Code).

The owner/applicant must correctly identify all property lines, easements, and rights-of-way and ensure the fence is located within the property's boundaries. Covenants, conditions, restrictions, easements and/or rights-of-way may restrict or prohibit the placement of fence(s). The owner/applicant is responsible for compliance with covenants, conditions, and restrictions which may apply. Fences built in easements may be subject to removal at the property owner's sole and absolute expense. Any modification of design and/or material as approved in this fence permit must be approved, in writing, by the Community Development Department Director.


I hereby acknowledge that I have read this application and the information and plot plan are correct; I agree to comply with any and all codes, ordinances, laws, regulations, or restrictions which apply.

I understand that failure to comply shall result in legal action, which may include but not necessarily be limited to removal of the fence(s) at the owner's cost.

Applicant's Signature Kenneth Smith
Community Development's Approval Y/Ishe Magors
City Engineer's Approval (if required) N/A

Date 6-27-00
Date 6/27/00
Date

VALID FOR SIX MONTHS FROM DATE OF ISSUANCE (Section 9-3-2D Grand Junction Zoning & Development Code)
(White: Planning) (Yellow: Customer) (Pink: Code Enforcement)

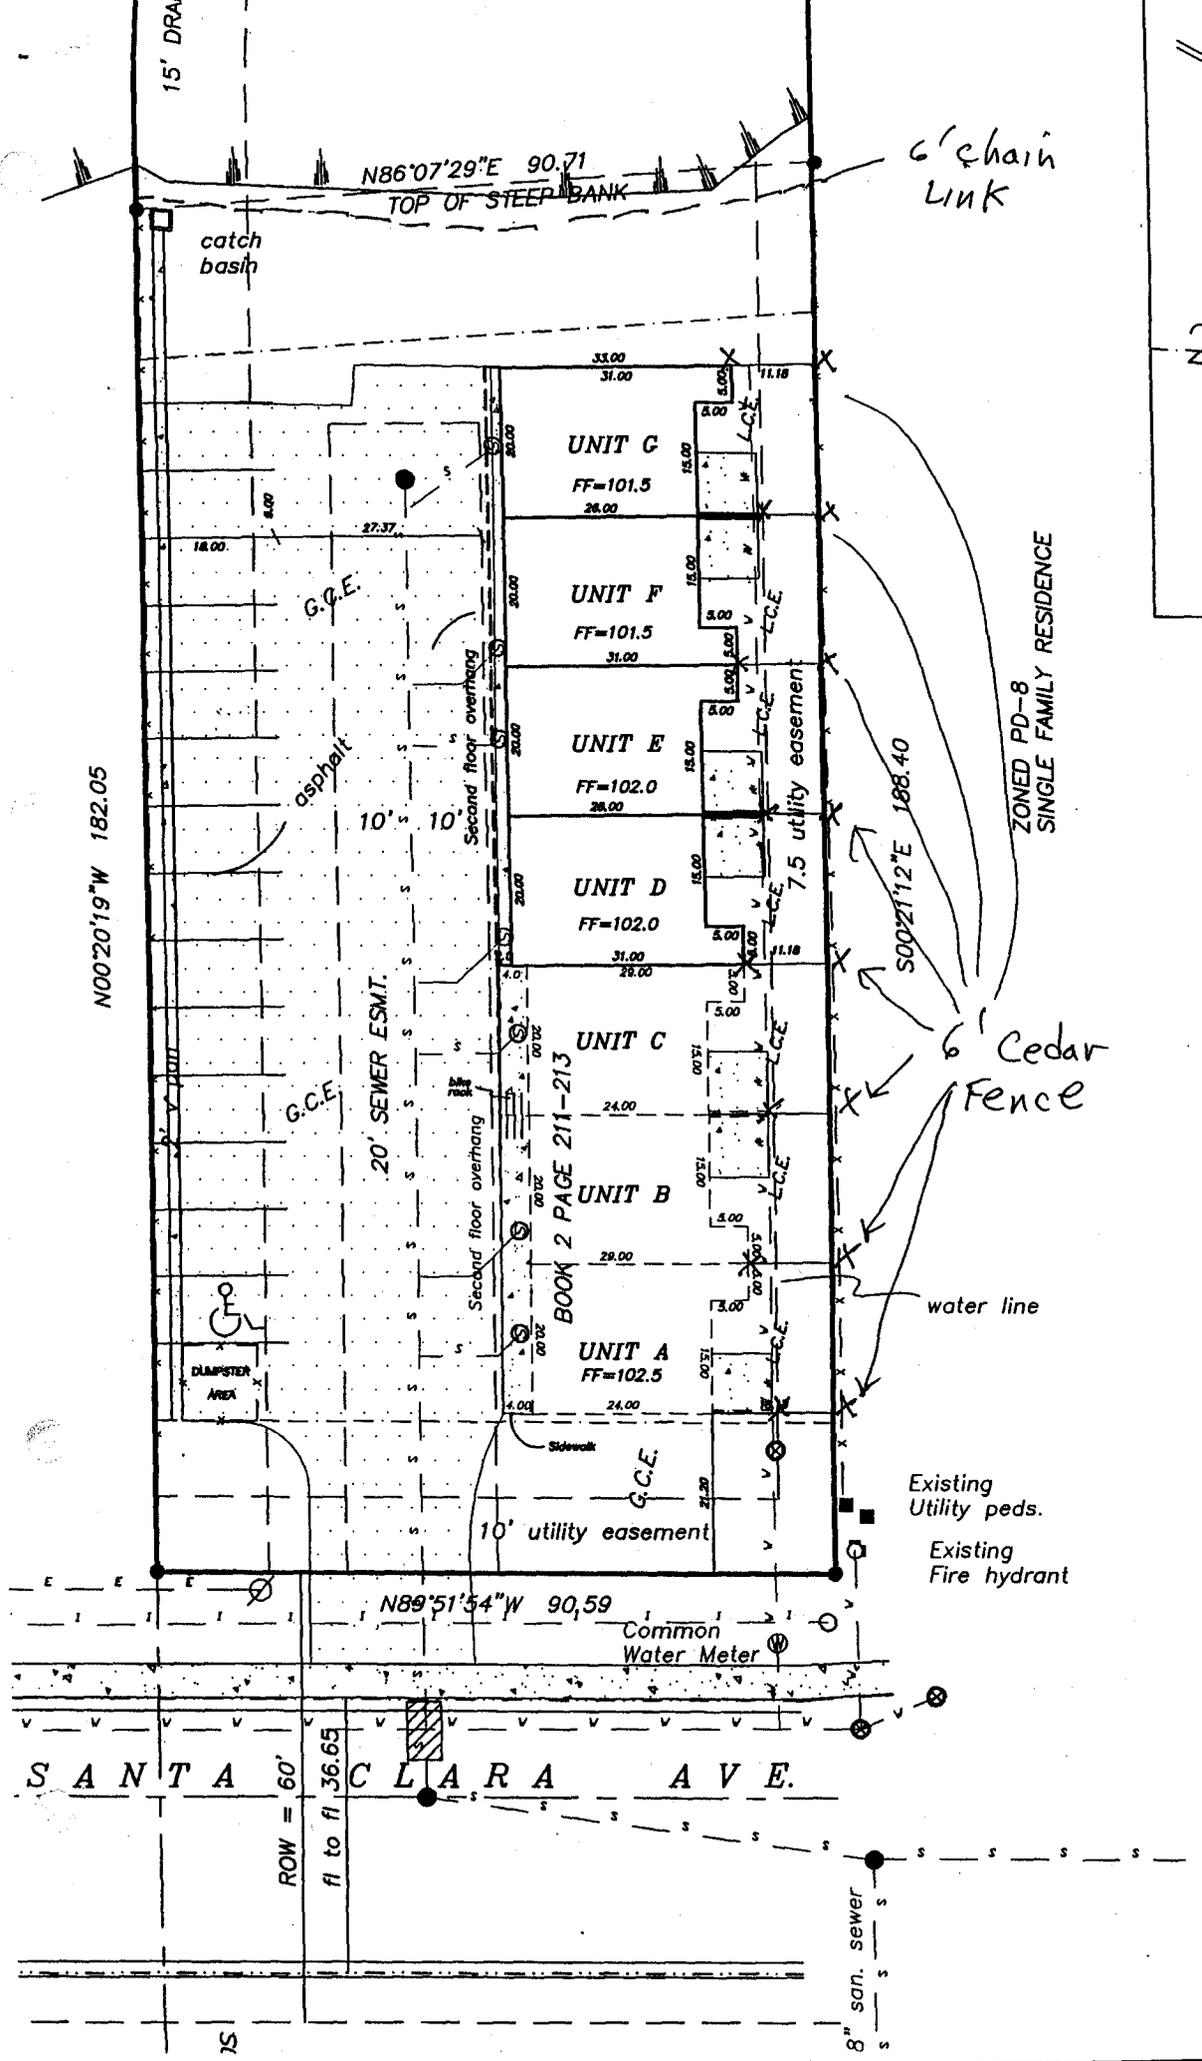

N00°20'19"W 182.05

N89°51'54"W 90.59

G.C.E.
asphalt

G.C.E.

G.C.E.

10'

Second floor overhang

Second floor overhang

Sidewalk

S002°12'E 188.40

Existing Utility peds.

Existing Fire hydrant

Common Water Meter

SANTA CLARA AVE.

8" san. sewer

ZONED PD-8
SINGLE FAMILY RESIDENCE

2