

FEE \$10.00

PERMIT # 11134



FENCE PERMIT


GRAND JUNCTION COMMUNITY DEVELOPMENT DEPARTMENT

ex

THIS SECTION TO BE COMPLETED BY APPLICANT

PLOT PLAN

PROPERTY ADDRESS 2062 Pannier Ct
 TAX SCHEDULE NO 2947-151-36-020
 PROPERTY OWNER William R & Donnie F. Childs
 OWNER'S PHONE 257-1853
 OWNER'S ADDRESS 2062 Pannier Ct
 CONTRACTOR Self
 CONTRACTOR'S PHONE _____
 CONTRACTOR'S ADDRESS _____
 FENCE MATERIAL Cedar
 FENCE HEIGHT 6'

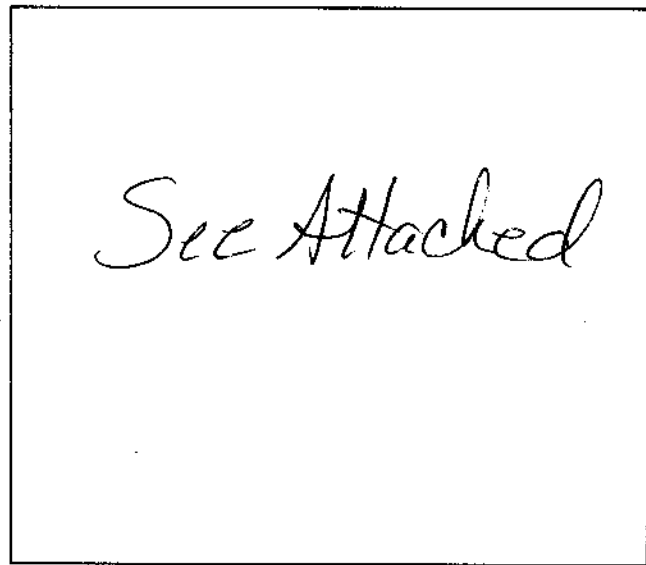

Plot plan must show property lines and property dimensions, all easements, all rights-of-way, all structures, all setbacks from property lines, & fence height(s).

THIS SECTION TO BE COMPLETED BY COMMUNITY DEVELOPMENT DEPARTMENT STAFF

ZONE PD
 SPECIAL CONDITIONS _____

SETBACKS: Front 25 from property line (PL) or _____ from center of ROW, whichever is greater.
 Side _____ from PL Rear _____ from PL

Fences exceeding six feet in height require a separate permit from the City/County Building Department. A fence constructed on a corner lot that extends past the rear of the house along the side yard or abuts an alley requires approval from the City Engineer (Section 5-5-5B of the Grand Junction Zoning and Development Code).

The owner/applicant must correctly identify all property lines, easements, and rights-of-way and ensure the fence is located within the property's boundaries. Covenants, conditions, restrictions, easements and/or rights-of-way may restrict or prohibit the placement of fence(s). The owner/applicant is responsible for compliance with covenants, conditions, and restrictions which may apply. Fences built in easements may be subject to removal at the property owner's sole and absolute expense. Any modification of design and/or material as approved in this fence permit must be approved, in writing, by the Community Development Department Director.

I hereby acknowledge that I have read this application and the information and plot plan are correct; I agree to comply with any and all codes, ordinances, laws, regulations, or restrictions which apply.

I understand that failure to comply shall result in legal action, which may include but not necessarily be limited to removal of the fence(s) at the owner's cost.

Applicant's Signature Donnie Childs
 Community Development's Approval Autie Costello
 City Engineer's Approval (if required) _____

Date 9-8-00
 Date 9-8-00
 Date _____

VALID FOR SIX MONTHS FROM DATE OF ISSUANCE (Section 9-3-2D Grand Junction Zoning & Development Code)
(White: Planning) (Yellow: Customer) (Pink: Code Enforcement)

Site / Drainage Plan

2062 Penna Ct


6/11/99
DRIVE O.K.
V.M.

6/29/98
Penna

/// = Driveway
→ = Drainage



Driveway

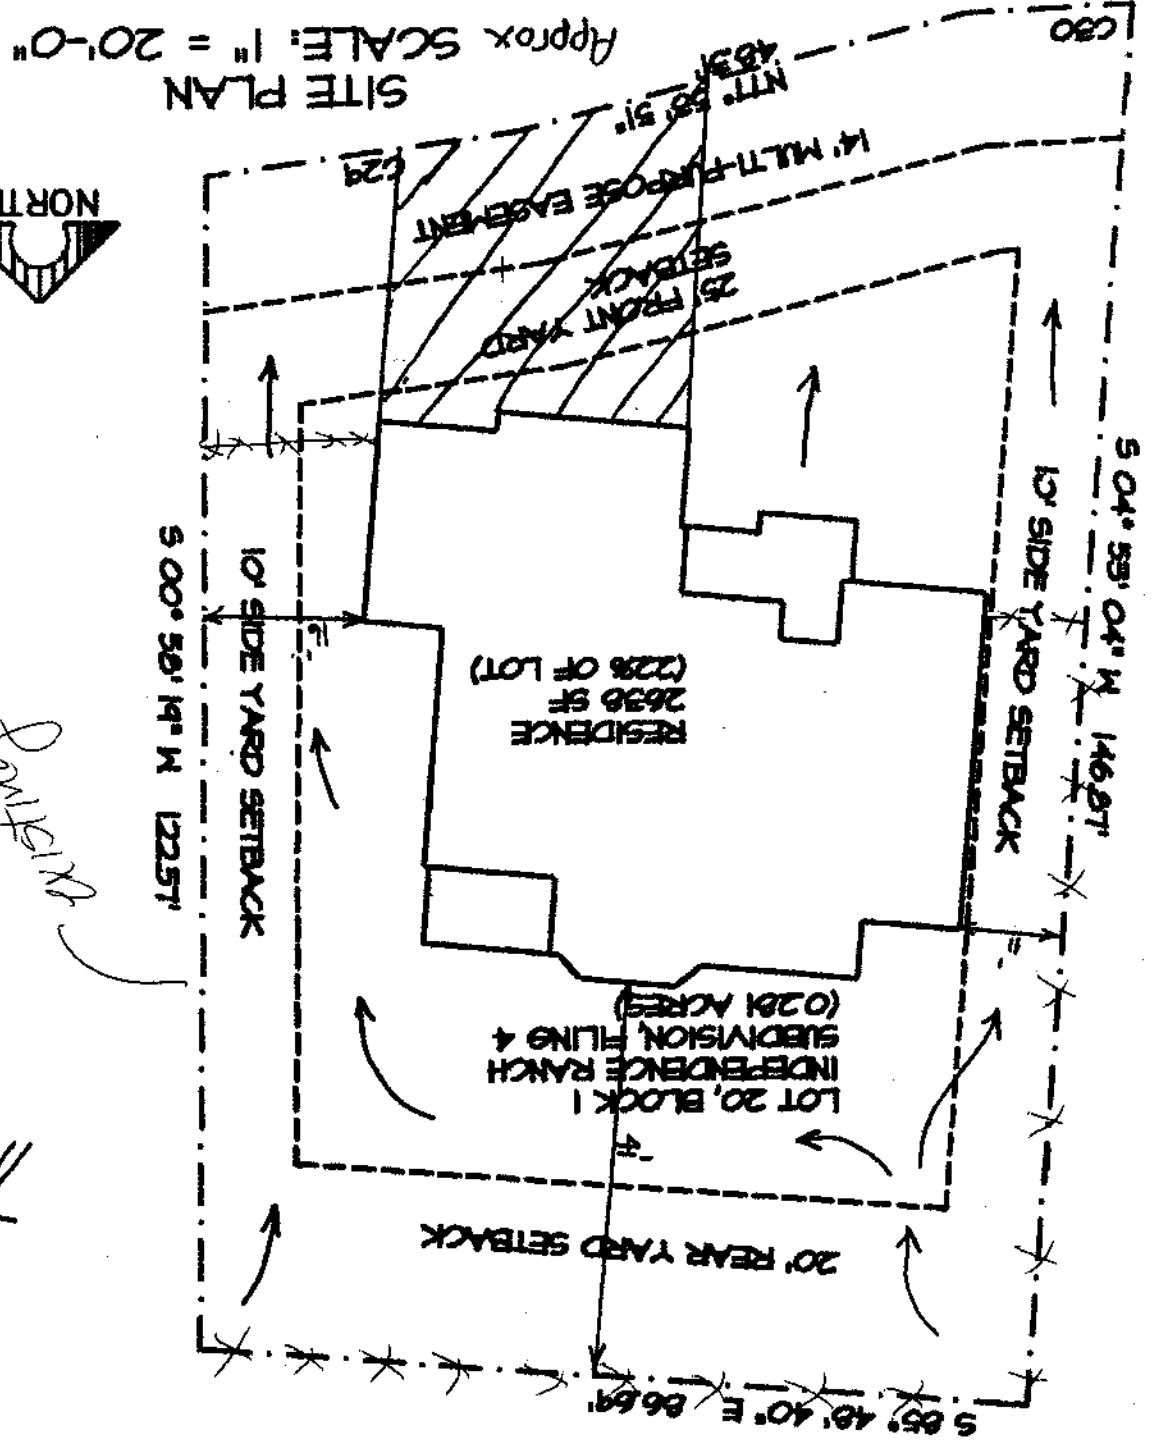

SITE PLAN

Approx SCALE: 1" = 20'-0"

4' MULT-PURPOSE EASEMENT

25' FRONT YARD SETBACK

10' SIDE YARD SETBACK

RESIDENCE
2638 SF
(228 OF LOT)

LOT 20, BLOCK 1
INDEPENDENCE RANCH 4
SUBDIVISION, FILING 4
(0.281 ACRES)

20' REAR YARD SETBACK

10' SIDE YARD SETBACK

500' 50' 19" W 122.57'

505' 49' 40" E 86.69'

504' 59' 04" W 146.87'