

FEE \$10.00

PERMIT # 11000




FENCE PERMIT
GRAND JUNCTION COMMUNITY DEVELOPMENT DEPARTMENT

THIS SECTION TO BE COMPLETED BY APPLICANT

PLOT PLAN

PROPERTY ADDRESS 2198 STANDING ROCK DR
TAX SCHEDULE NO 2947-351-24-001
PROPERTY OWNER ROBERT J SANDRA/K MUELER
OWNER'S PHONE 243 8596
OWNER'S ADDRESS SAME
CONTRACTOR (JASON) ROCKY MTN VINYL
CONTRACTOR'S PHONE 285-1966
CONTRACTOR'S ADDRESS 0854 WEST BATTEMENT PKWY.
FENCE MATERIAL VINYL & SPLIT RAIL
FENCE HEIGHT 4 FT

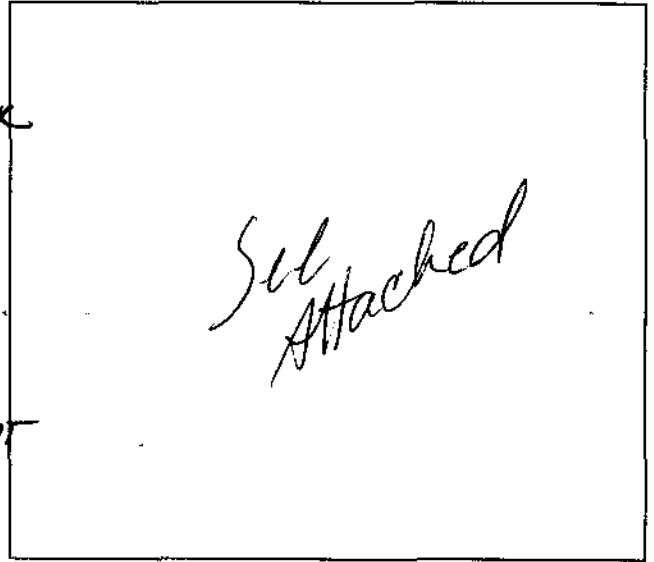

Plot plan must show property lines and property dimensions, all easements, all rights-of-way, all structures, all setbacks from property lines, & fence height(s).

THIS SECTION TO BE COMPLETED BY COMMUNITY DEVELOPMENT DEPARTMENT STAFF

ZONE PR-2
SPECIAL CONDITIONS 4' only along South Camp

SETBACKS: Front 30' for any solid portion over 30" from property line (PL) or from center of ROW, whichever is greater.
Side _____ from PL Rear _____ from PL

Fences exceeding six feet in height require a separate permit from the City/County Building Department. A fence constructed on a corner lot that extends past the rear of the house along the side yard or abuts an alley requires approval from the City Engineer (Section 5-5-5B of the Grand Junction Zoning and Development Code).

The owner/applicant must correctly identify all property lines, easements, and rights-of-way and ensure the fence is located within the property's boundaries. Covenants, conditions, restrictions, easements and/or rights-of-way may restrict or prohibit the placement of fence(s). The owner/applicant is responsible for compliance with covenants, conditions, and restrictions which may apply. Fences built in easements may be subject to removal at the property owner's sole and absolute expense. Any modification of design and/or material as approved in this fence permit must be approved, in writing, by the Community Development Department Director.

I hereby acknowledge that I have read this application and the information and plot plan are correct; I agree to comply with any and all codes, ordinances, laws, regulations, or restrictions which apply.

I understand that failure to comply shall result in legal action, which may include but not necessarily be limited to removal of the fence(s) at the owner's cost.

Applicant's Signature Sandra Mueller

Date 4-14-00

Community Development's Approval Santa Castello

Date 4-14-00

City Engineer's Approval (if required) _____

Date _____

VALID FOR SIX MONTHS FROM DATE OF ISSUANCE (Section 9-3-2D Grand Junction Zoning & Development Code)
(White: Planning) (Yellow: Customer) (Pink: Code Enforcement)


KV 9-24-99

ALL DIMENSIONS OF SETBACKS MUST BE APPROVED BY THE CITY PLANNING DEPARTMENT. THE APPLICANTS ARE RESPONSIBLE TO PROPERLY LOCATE AND IDENTIFY EASEMENTS AND PROPERTY LINES.

2198 Standing Rock Dr.

Canyon View Filing 7

Lot 1 Blk 1

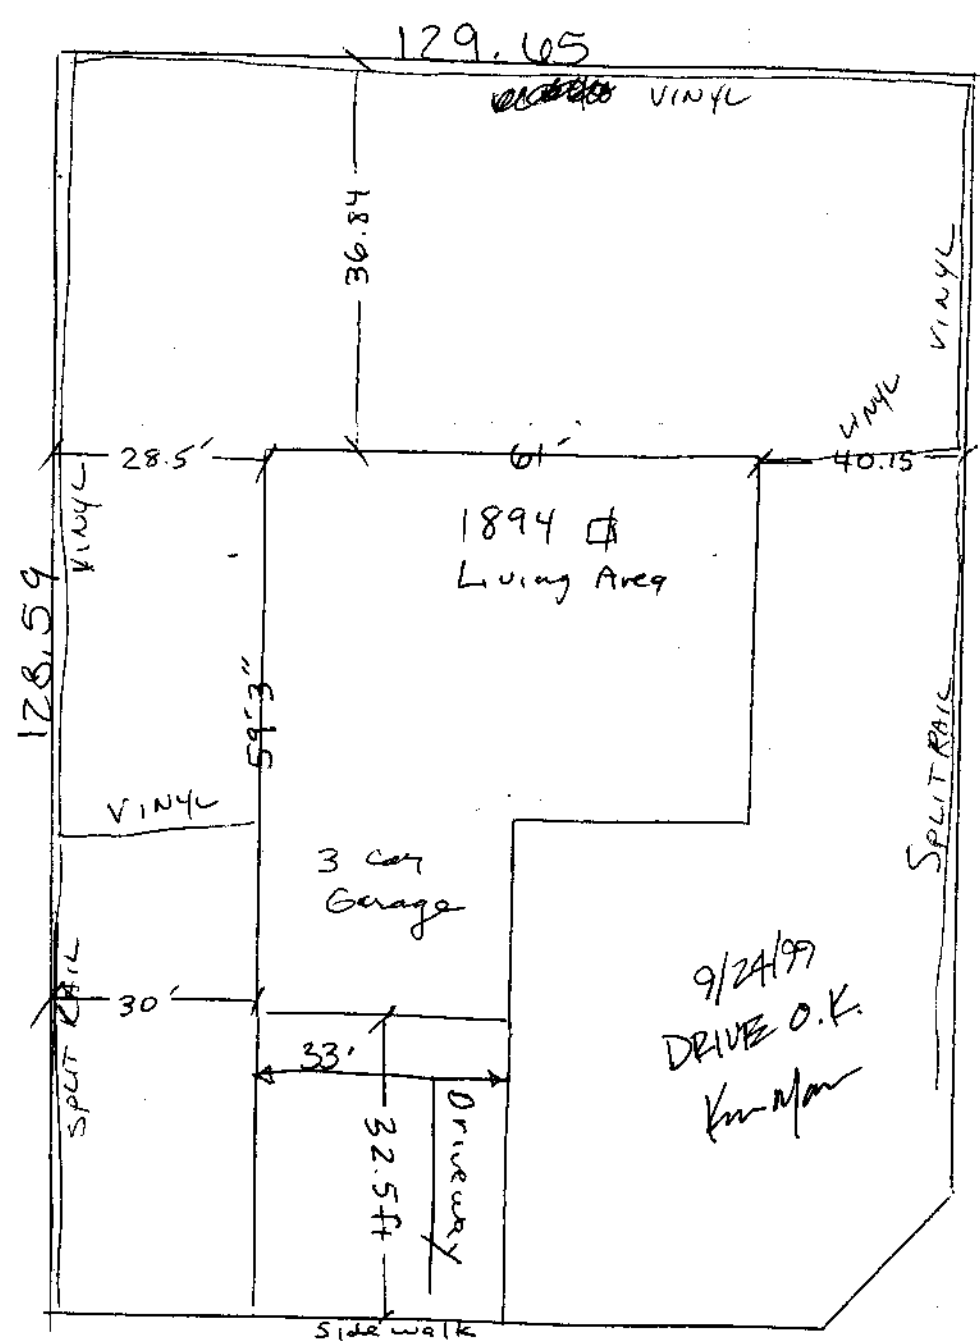

2198 Standing Rock Dr

not to scale

South Camp Rd.