

FEE \$10.00

PERMIT # 10814

AC

FENCE PERMIT


GRAND JUNCTION COMMUNITY DEVELOPMENT DEPARTMENT



THIS SECTION TO BE COMPLETED BY APPLICANT

PROPERTY ADDRESS 2461 F 1/4 Rd
 TAX SCHEDULE NO 2945-044-10-009
 PROPERTY OWNER Horizon Builders
 OWNER'S PHONE 256-0748
 OWNER'S ADDRESS 2461 F 1/4 Rd
 CONTRACTOR Taylor Fence of GJ
 CONTRACTOR'S PHONE 241-1473
 CONTRACTOR'S ADDRESS 832 2 1/2 Rd
 FENCE MATERIAL 6' white pvc fence
 FENCE HEIGHT 6' Tall

PLOT PLAN

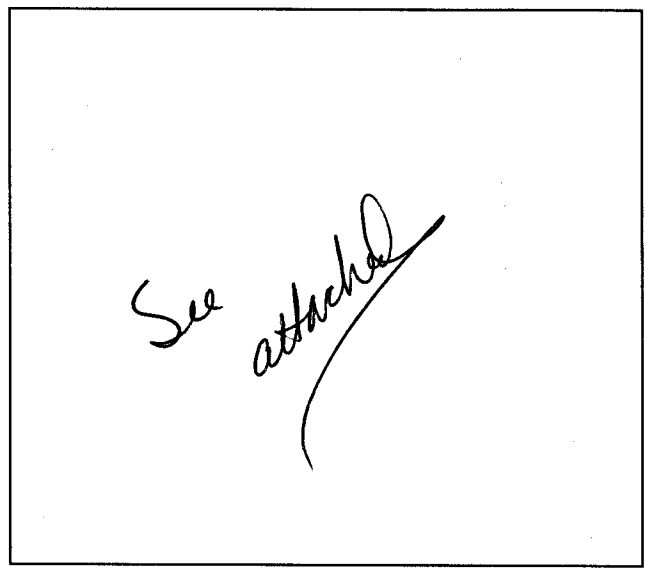

Plot plan must show property lines and property dimensions, all easements, all rights-of-way, all structures, all setbacks from property lines, & fence height(s).

THIS SECTION TO BE COMPLETED BY COMMUNITY DEVELOPMENT DEPARTMENT STAFF

ZONE PR-17 & PB SETBACKS: Front — from property line (PL) or
 SPECIAL CONDITIONS Swimming pool — from center of ROW, whichever is greater.
fence - Side 0' from PL Rear 0' from PL

Fences exceeding six feet in height require a separate permit from the City/County Building Department. A fence constructed on a corner lot that extends past the rear of the house along the side yard or abuts an alley requires approval from the City Engineer (Section 5-5-5B of the Grand Junction Zoning and Development Code).


The owner/applicant must correctly identify all property lines, easements, and rights-of-way and ensure the fence is located within the property's boundaries. Covenants, conditions, restrictions, easements and/or rights-of-way may restrict or prohibit the placement of fence(s). The owner/applicant is responsible for compliance with covenants, conditions, and restrictions which may apply. Fences built in easements may be subject to removal at the property owner's sole and absolute expense. Any modification of design and/or material as approved in this fence permit must be approved, in writing, by the Community Development Department Director.

I hereby acknowledge that I have read this application and the information and plot plan are correct; I agree to comply with any and all codes, ordinances, laws, regulations, or restrictions which apply.

I understand that failure to comply shall result in legal action, which may include but not necessarily be limited to removal of the fence(s) at the owner's cost.

Applicant's Signature Jerrell Luman Date 11-28-00
 Community Development's Approval Donnie Edwards Date 11-29-00
 City Engineer's Approval (if required) N/A Date _____

VALID FOR SIX MONTHS FROM DATE OF ISSUANCE (Section 9-3-2D Grand Junction Zoning & Development Code) (White: Planning) (Yellow: Customer) (Pink: Code Enforcement)

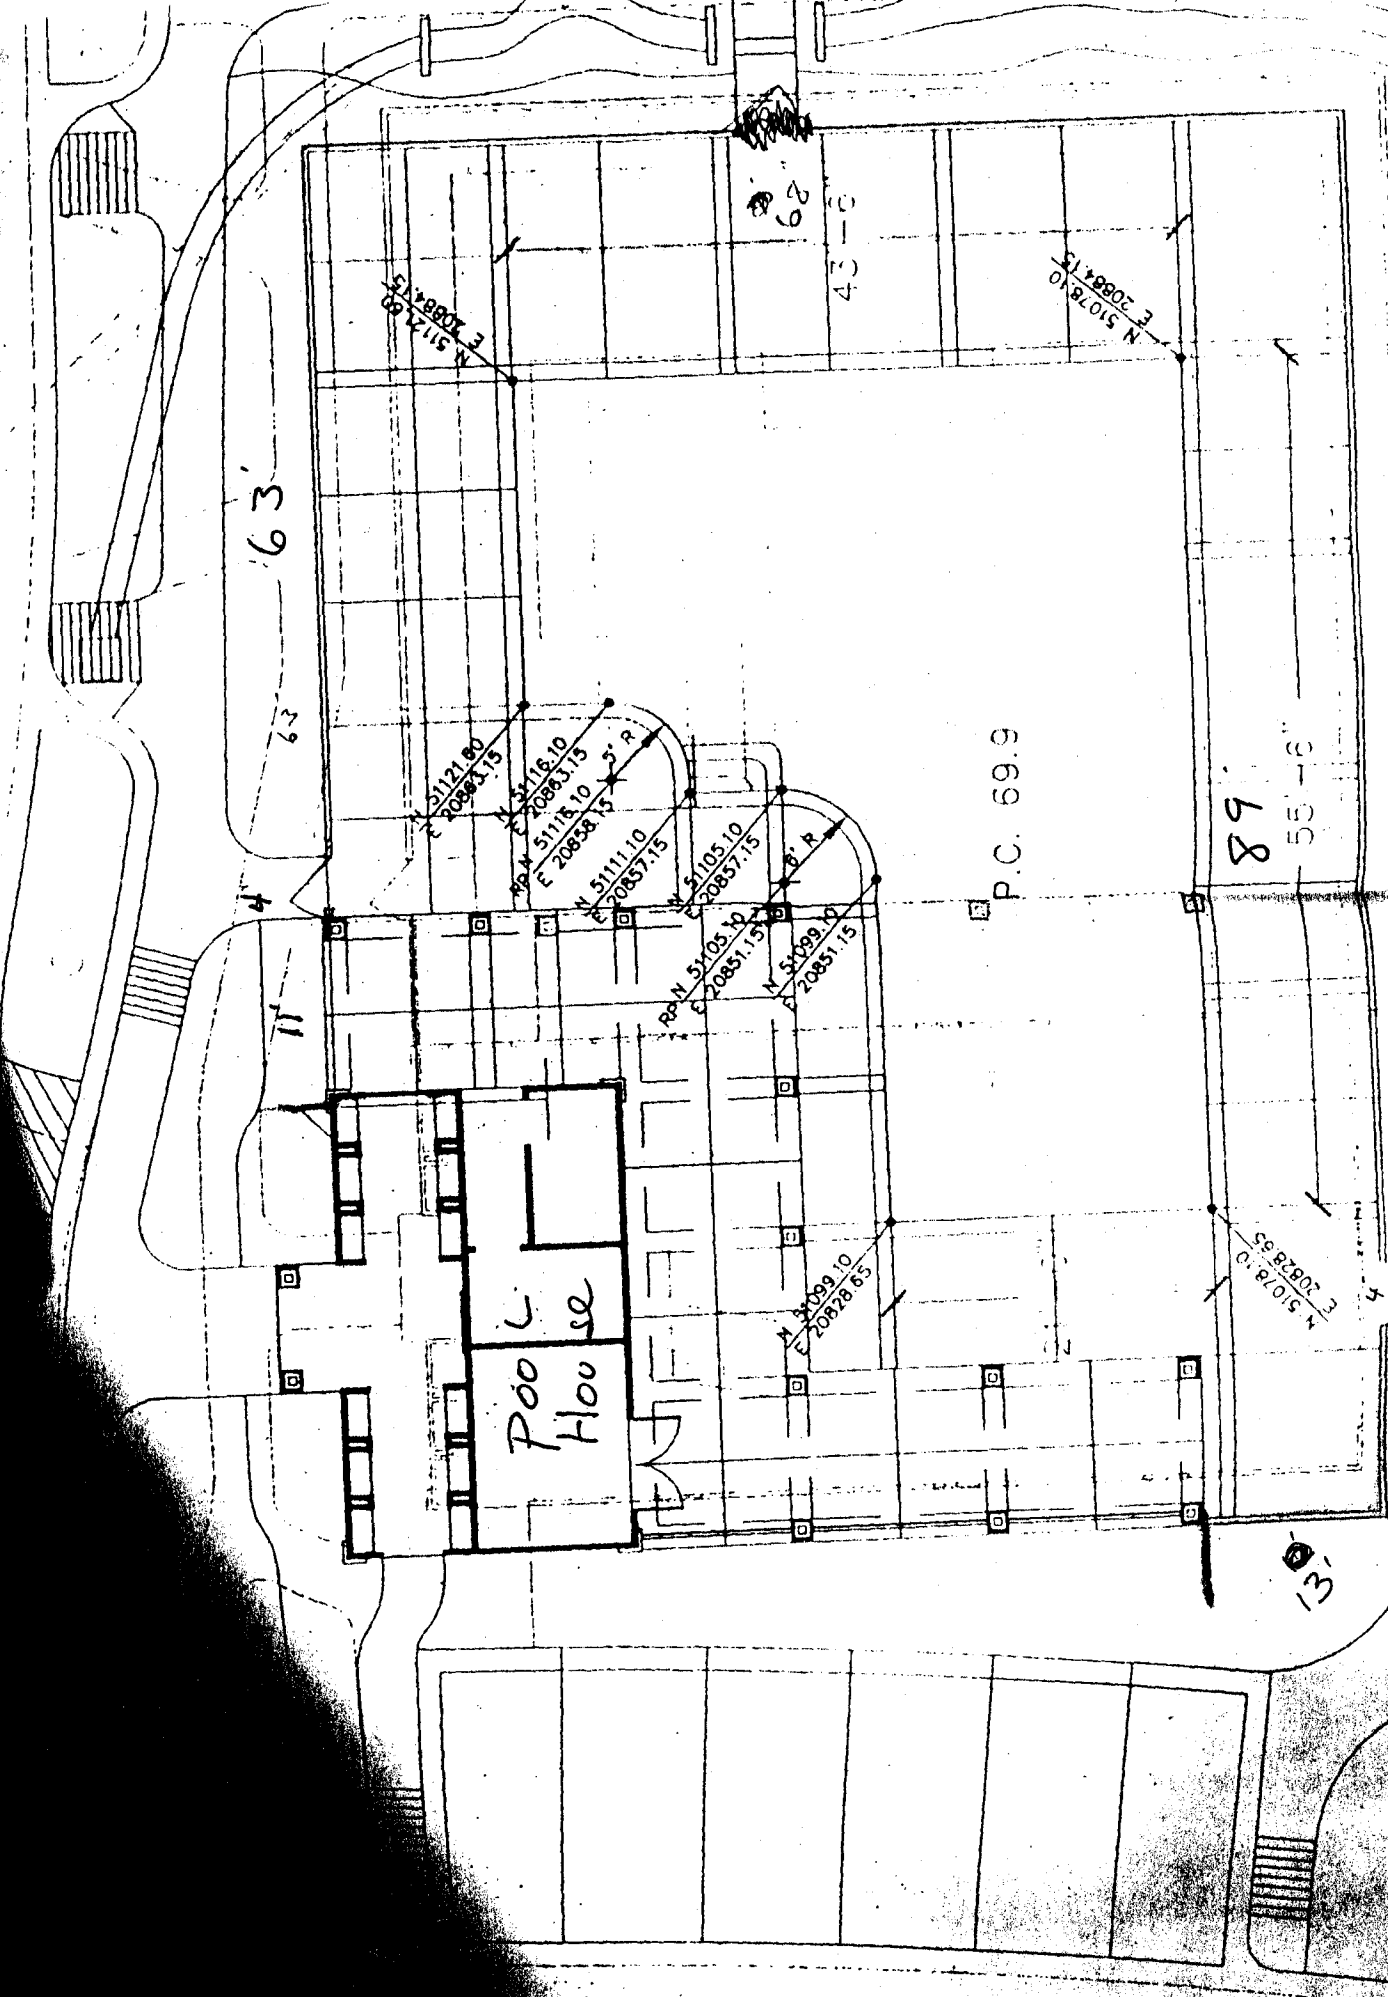

Pool House

P.C. 69.9

63'

63'

89'

55'-6"

43'-6"

53'