

FEE \$10.00

PERMIT # 11104

EX



FENCE PERMIT
GRAND JUNCTION COMMUNITY DEVELOPMENT DEPARTMENT

THIS SECTION TO BE COMPLETED BY APPLICANT

PLOT PLAN

PROPERTY ADDRESS 922 North First St., GJT, CO

TAX SCHEDULE NO 2945-142-12-018

PROPERTY OWNER Darlene M. Stoner per phone call
Stoner Enterprises, LTD 8/8/01 LVB.

OWNER'S PHONE 245-4128

OWNER'S ADDRESS 554 Eastwood, G.J., CO 81504


CONTRACTOR Maranatha Fencing

CONTRACTOR'S PHONE 241-9303

CONTRACTOR'S ADDRESS Grand Junction, CO

FENCE MATERIAL Chain Link

FENCE HEIGHT 6'

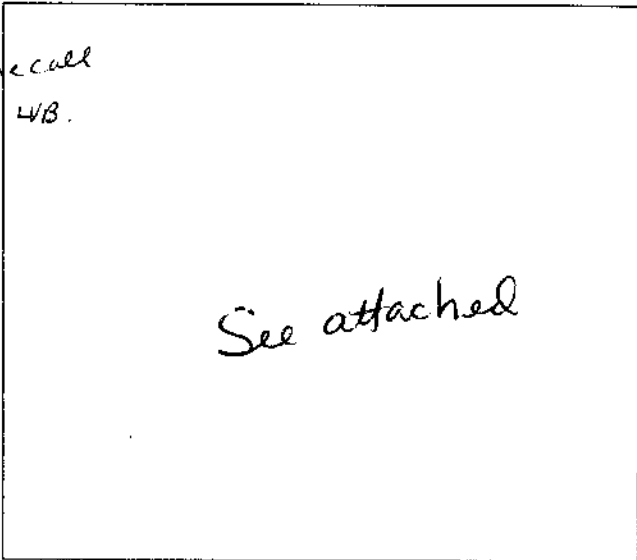

Plot plan must show property lines and property dimensions, all easements, all rights-of-way, all structures, all setbacks from property lines, & fence height(s).

THIS SECTION TO BE COMPLETED BY COMMUNITY DEVELOPMENT DEPARTMENT STAFF

ZONE C-1

SETBACKS: Front 15' from property line (PL) or

SPECIAL CONDITIONS

from center of ROW, whichever is greater.

Side 0' from PL Rear 10' from PL

Fences exceeding six feet in height require a separate permit from the City/County Building Department. A fence constructed on a corner lot that extends past the rear of the house along the side yard or abuts an alley requires approval from the City Engineer (Section 5-5-5B of the Grand Junction Zoning and Development Code).

The owner/applicant must correctly identify all property lines, easements, and rights-of-way and ensure the fence is located within the property's boundaries. Covenants, conditions, restrictions, easements and/or rights-of-way may restrict or prohibit the placement of fence(s). The owner/applicant is responsible for compliance with covenants, conditions, and restrictions which may apply. Fences built in easements may be subject to removal at the property owner's sole and absolute expense. Any modification of design and/or material as approved in this fence permit must be approved, in writing, by the Community Development Department Director.

I hereby acknowledge that I have read this application and the information and plot plan are correct; I agree to comply with any and all codes, ordinances, laws, regulations, or restrictions which apply.

I understand that failure to comply shall result in legal action, which may include but not necessarily be limited to removal of the fence(s) at the owner's cost.

Applicant's Signature Darlene M. Stoner

Date 8-8-00

Community Development's Approval Livi U. Brown

Date 8-8-00

City Engineer's Approval (if required) N/A

Date


VALID FOR SIX MONTHS FROM DATE OF ISSUANCE (Section 9-3-2D Grand Junction Zoning & Development Code)
(White: Planning) (Yellow: Customer) (Pink: Code Enforcement)

Existing Asphalt	-	14,750 ft <sup>2</sup>
<b>TOTAL</b>	-	<b>23,438 ft<sup>2</sup> (0.538 acres)</b>

PROPERTY



Standard Tire  
Zone C-2

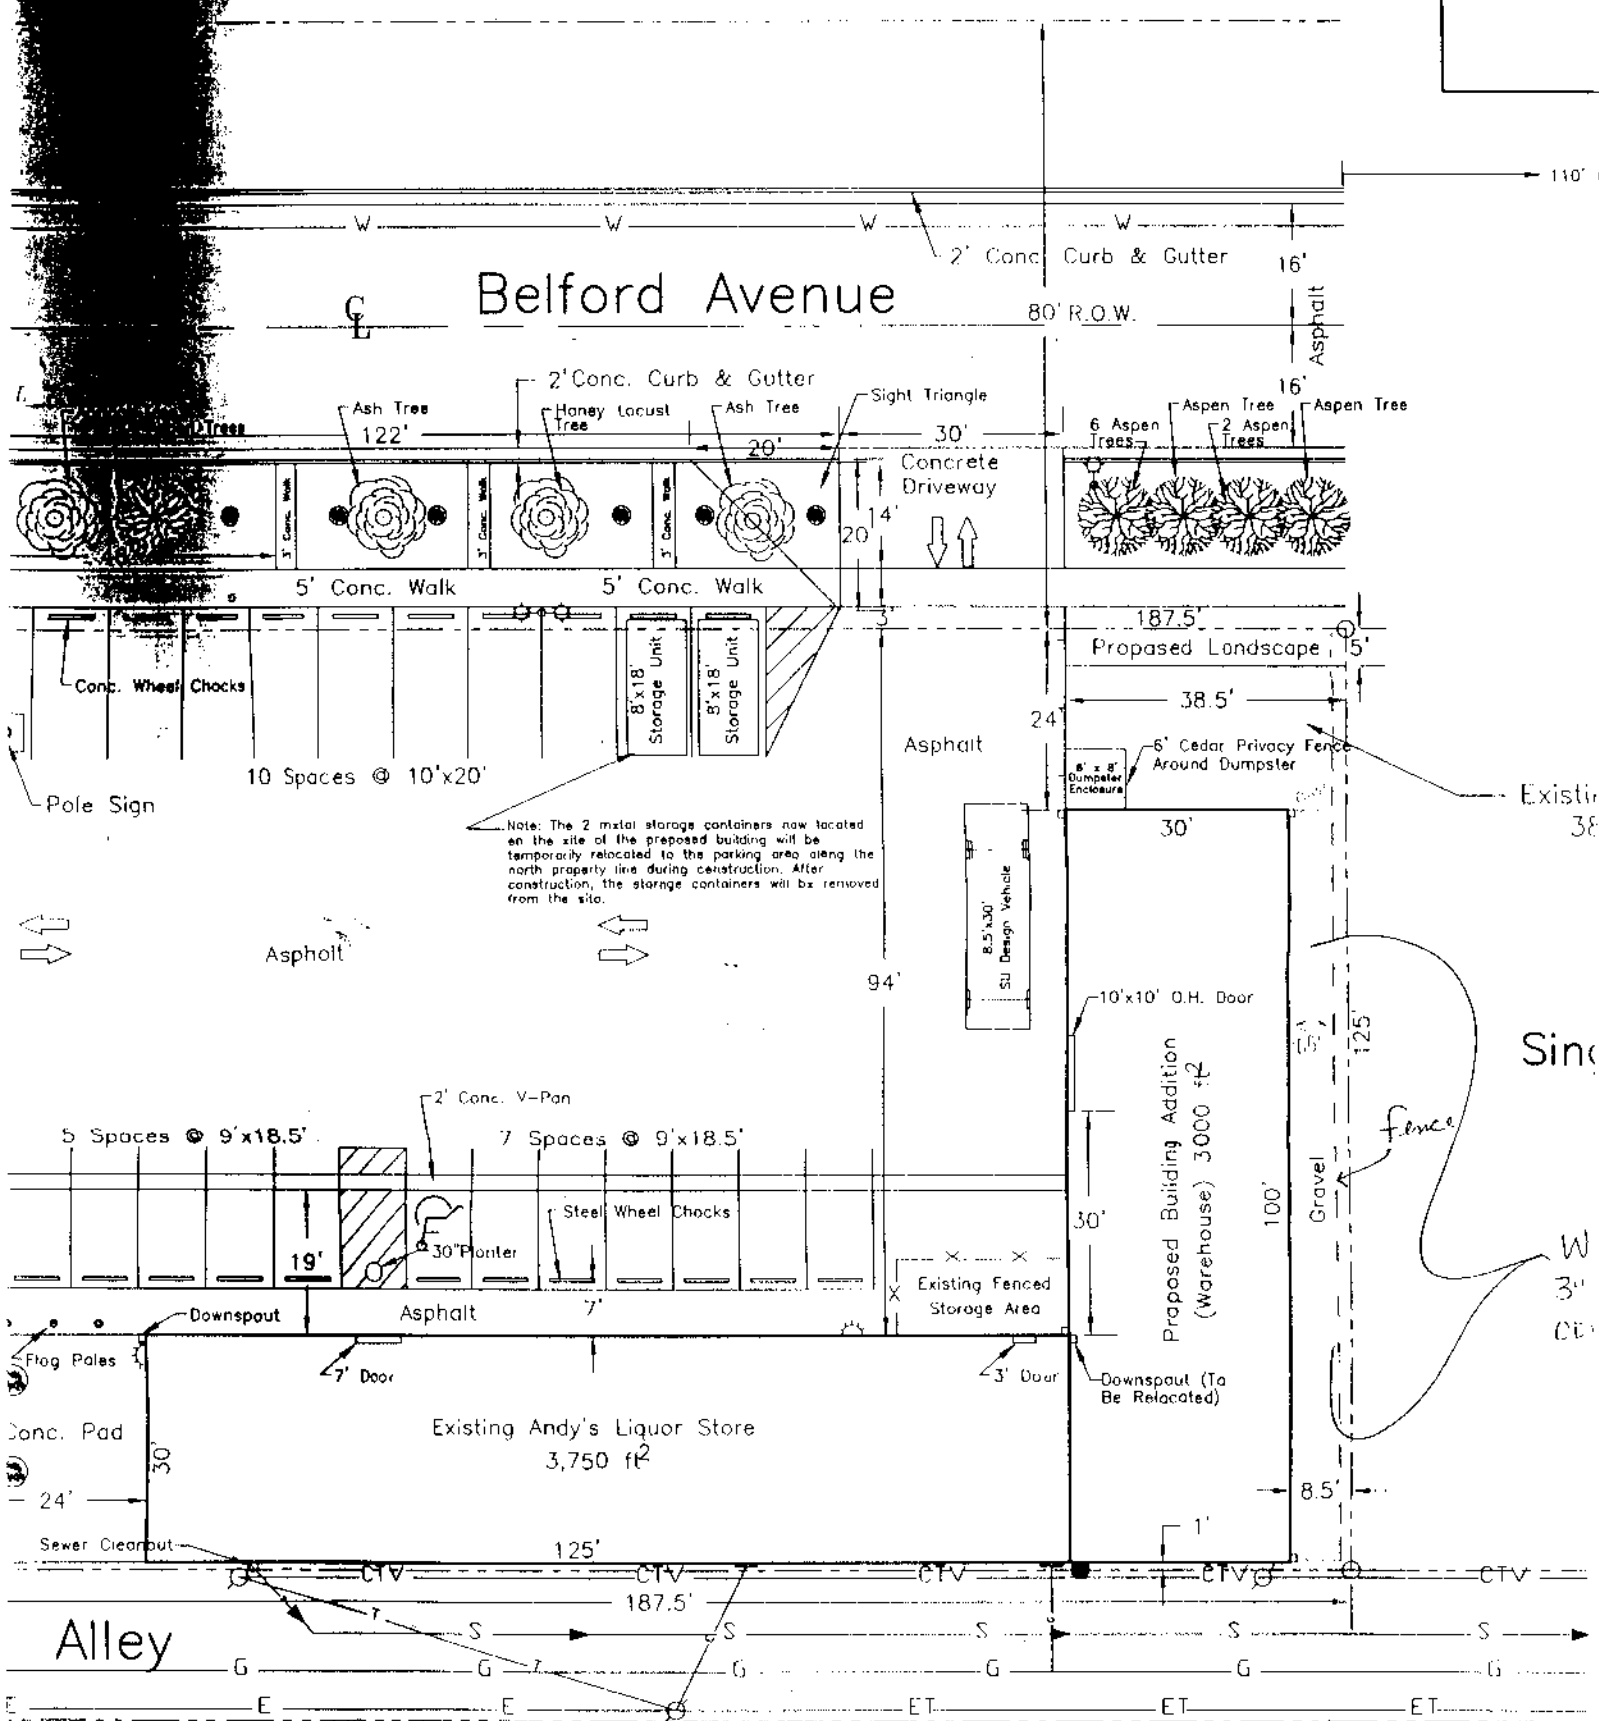

Dirt Suckers  
Vacuum Center  
Zone C-2

Single Family Residence  
Zone C-2

Sin