FEE ² \$10.00	PERMIT # 11468
FENCE PERMI GRAND JUNCTION COMMUNITY DEVELOP	T PMENT DEPARTMENT
PROPERTY ADDRESS 630 Monarch (+	ℤ PLOT PLAN
TAX SCHEDULE NO <u>2943-043-64-006</u> PROPERTY OWNER <u>Joe Carmosing Thie Hill</u> OWNER'S PHONE <u>970-434-8279</u> OWNER'S ADDRESS <u>630 Monarch C+</u> CONTRACTOR <u>Lee + Homes</u> CONTRACTOR'S PHONE CONTRACTOR'S ADDRESS FENCE MATERIAL <u>Cedar</u>	SEE ATTACHED

A Plot plan must show property lines and property dimensions, all easements, all rights-of-way, all structures, all setbacks from property lines, & fence height(s).

IN THIS SECTION TO BE COMPLETED BY COMMUNITY DEVELOPMENT DEPARTMENT STAFF IN

SETBACKS: Front 30 from property line (PL) or ZONE_RSF-4 SPECIAL CONDITIONS

Fences exceeding six feet in height require a separate permit from the City/County Building Department. A fence constructed on a corner lot that extends past the rear of the house along the side yard or abuts an alley requires approval from the City Engineer (Section 5-5-5B of the Grand Junction Zoning and Development Code).

Side

The owner/applicant must correctly identify all property lines, easements, and rights-of-way and ensure the fence is located within the property's boundaries. Covenants, conditions, restrictions, easements and/or rights-of-way may restrict or prohibit the placement of fence(s). The owner/applicant is responsible for compliance with covenants, conditions, and restrictions which may apply. Fences built in easements may be subject to removal at the property owner's sole and absolute expense. Any modification of design and/or material as approved in this fence permit must be approved, in writing, by the Community Development Department Director.

I hereby acknowledge that I have read this application and the information and plot plan are correct; I agree to comply with any and all codes, ordinances, laws, regulations, or restrictions which apply.

I understand that failure to comply shall result in legal action, which may include but not necessarily be limited to removal of the fence(s) at the owner's cost. \cap

Applicant's Signature	0)
Community Developments Approval fat Bushman	5
City Engineer's Approval (if required)	


Date 10-18.01

from center of ROW, whichever is greater.

from PL Rear 25' from PL

Date <u>10 - 22 - 01</u> Date 10/18/01

VALID FOR SIX MONTHS FROM DATE OF ISSUANCE (Section 9-3-2D Grand Junction Zoning & Development Code) (White: Planning) (Yellow: Customer) (Pink: Code Enforcement)

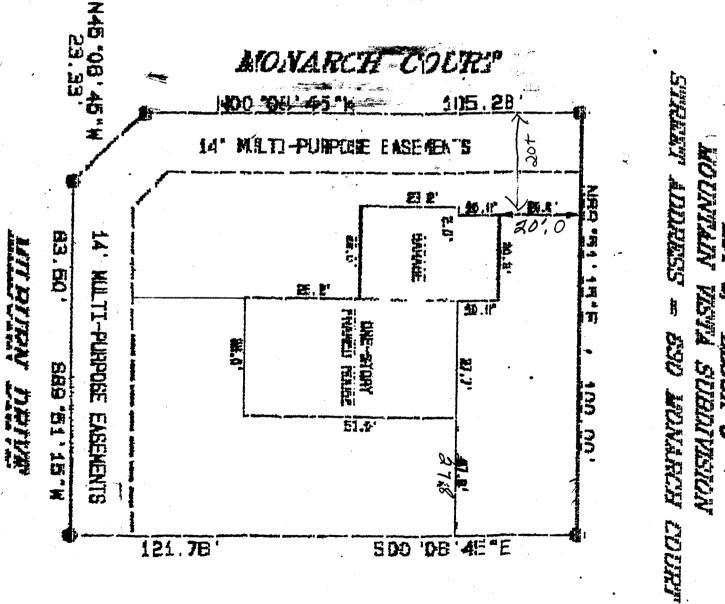

LOT & BLOCK &

PROPERTY DESCRIPTION