

FENCE PERMIT

GRAND JUNCTION COMMUNITY DEVELOPMENT DEPARTMENT



Ac

THIS SECTION TO BE COMPLETED BY APPLICANT

PLOT PLAN

PROPERTY ADDRESS 1188 OLSON AVE.

TAX SCHEDULE NO 2945-234-08-044

PROPERTY OWNER JAMES MORRIS

OWNER'S PHONE 255-1955

OWNER'S ADDRESS 1188 OLSON AVE.


CONTRACTOR SELF / OWNER

CONTRACTOR'S PHONE SAME AS ABOVE

CONTRACTOR'S ADDRESS _____

FENCE MATERIAL REDWOOD / CEDAR (BACK YARD)
CHAIN LINK (SIDE YARD)

FENCE HEIGHT 6 ft. (back yard) 3-4 ft (side yard)

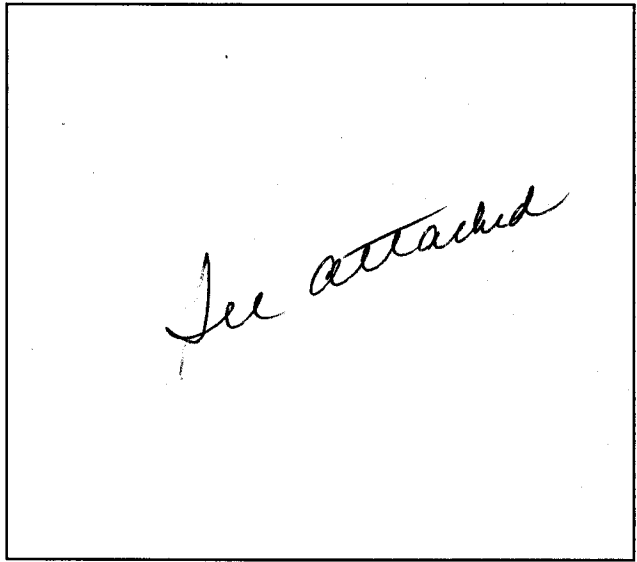

Plot plan must show property lines and property dimensions, all easements, all rights-of-way, all structures, all setbacks from property lines, & fence height(s). NOTE: PROPERTY LINE IS LIKELY ONE FOOT OR MORE BEHIND THE SIDEWALK.

THIS SECTION TO BE COMPLETED BY COMMUNITY DEVELOPMENT DEPARTMENT STAFF

ZONE PD

SETBACKS: Front 15' from property line (PL) or
_____ from center of ROW, whichever is greater.

SPECIAL CONDITIONS _____

Side 0' from PL Rear 5' from PL

Fences exceeding six feet in height require a separate permit from the City/County Building Department. A fence constructed on a corner lot that extends past the rear of the house along the side yard or abuts an alley requires approval from the City Engineer (Section 4.1.J of the Grand Junction Zoning and Development Code).

The owner/applicant must correctly identify all property lines, easements, and rights-of-way and ensure the fence is located within the property's boundaries. Covenants, conditions, restrictions, easements and/or rights-of-way may restrict or prohibit the placement of fence(s). The owner/applicant is responsible for compliance with covenants, conditions, and restrictions which may apply. Fences built in easements may be subject to removal at the property owner's sole and absolute expense. Any modification of design and/or material as approved in this fence permit must be approved, in writing, by the Community Development Department Director.

I hereby acknowledge that I have read this application and the information and plot plan are correct; I agree to comply with any and all codes, ordinances, laws, regulations, or restrictions which apply. I understand that failure to comply shall result in legal action, which may include but not necessarily be limited to removal of the fence(s) at the owner's cost.

Applicant's Signature James Morris

Date 5-3-02

Community Development's Approval Pat Bushman


Date 5-3-02

City Engineer's Approval (if required) Rob Davis

Date 5-3-02

VALID FOR SIX MONTHS FROM DATE OF ISSUANCE (Section 2.2.E.1.d Grand Junction Zoning & Development Code)
(White: Planning) (Yellow: Customer) (Pink: Code Enforcement)

SANTA CLARA

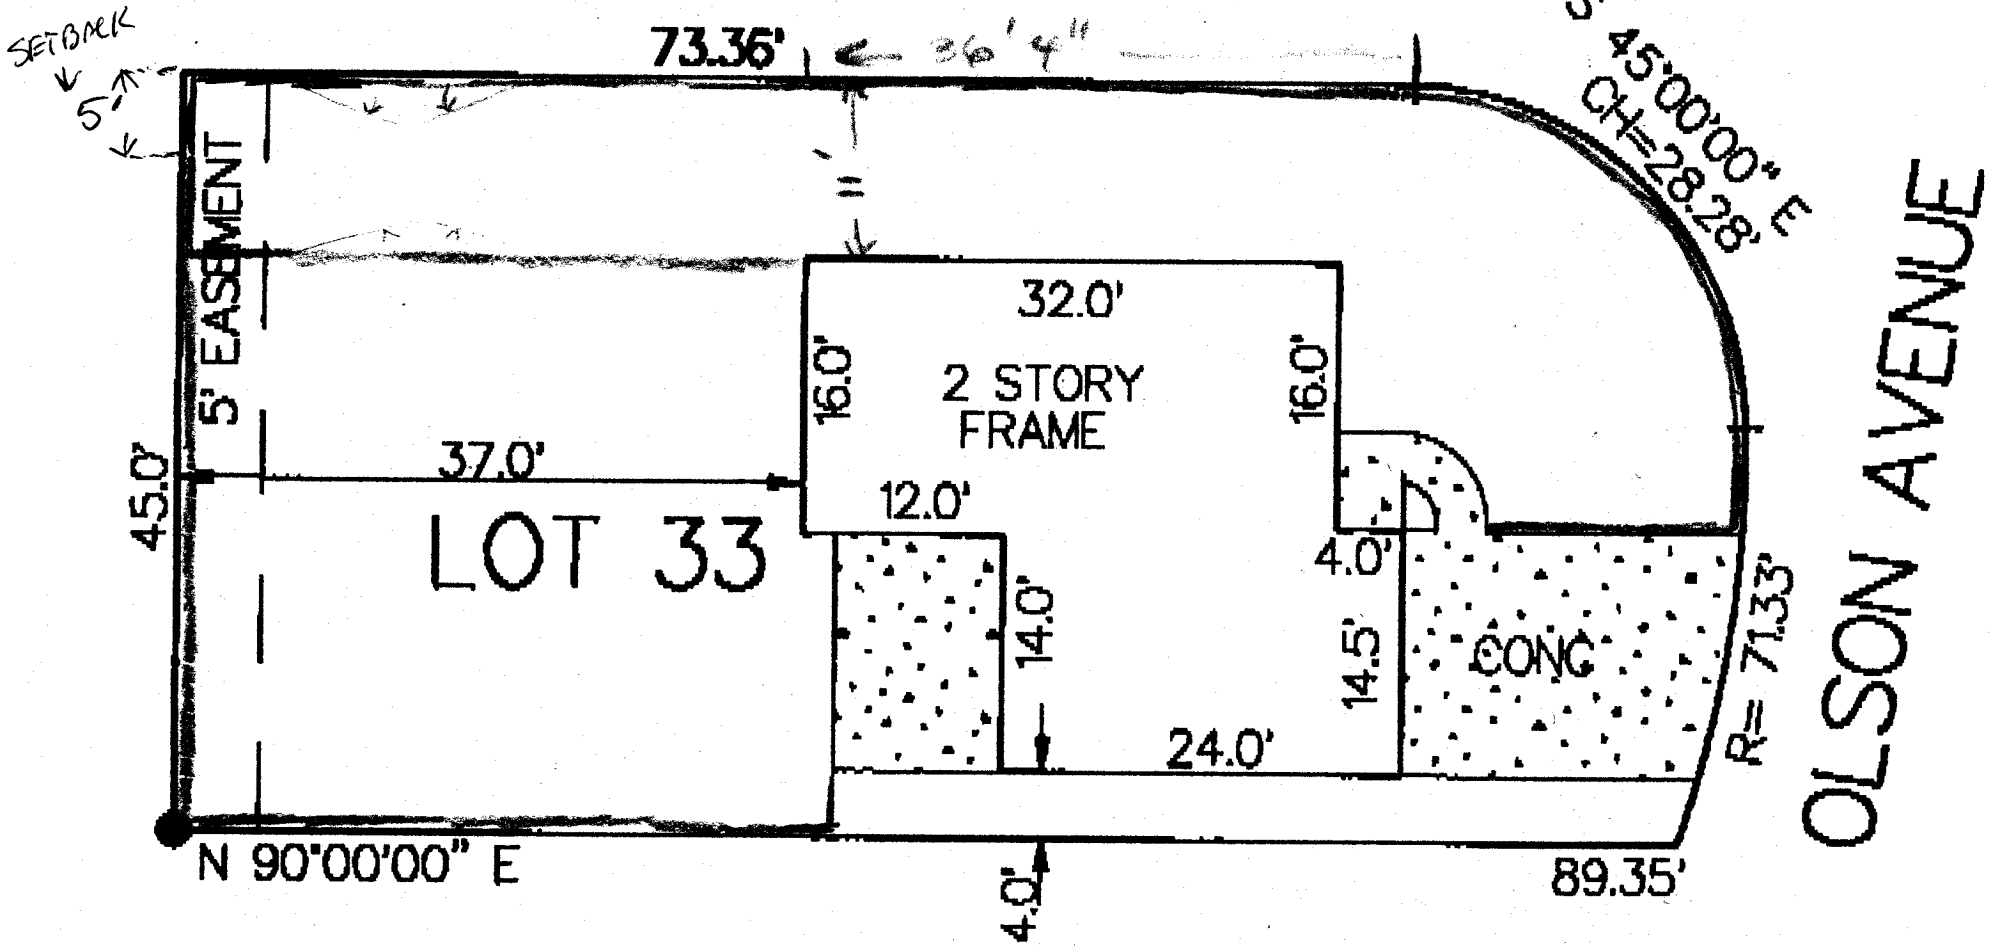

- = 4' CHAIN LINK FENCE
- = 6' WOOD FENCE

FENCE DESIGN FOR FENCE PERMIT

JAMES MORRIS
 1188 OLSON AVE.
 G.S. CO. 81503

OK *Pat Downy*
 5-3-02