

FEE \$10.00

PERMIT # 11746



FENCE PERMIT
GRAND JUNCTION COMMUNITY DEVELOPMENT DEPARTMENT

AC

THIS SECTION TO BE COMPLETED BY APPLICANT

PLOT PLAN

PROPERTY ADDRESS 2840 Maverick Dr.

TAX SCHEDULE NO 2943-303-64-010

PROPERTY OWNER John Tynes

OWNER'S PHONE 245-7314

OWNER'S ADDRESS 2840 Maverick Dr.

CONTRACTOR Pinnacle Homes Inc.

CONTRACTOR'S PHONE 241-6646

CONTRACTOR'S ADDRESS 518 28 Rd. Ste. 4107 G.J.

FENCE MATERIAL Vinyl

FENCE HEIGHT 6'



Plot plan must show property lines and property dimensions, all easements, all rights-of-way, all structures, all setbacks from property lines, & fence height(s).

THIS SECTION TO BE COMPLETED BY COMMUNITY DEVELOPMENT DEPARTMENT STAFF

ZONE RMF-5

SETBACKS: Front 20 from property line (PL) or from center of ROW, whichever is greater.

SPECIAL CONDITIONS FENCE ALONG MAVERICK MUST BE SETBACK 5' FROM SIDEWALK

Side from PL Rear from PL

Fences exceeding six feet in height require a separate permit from the City/County Building Department. A fence constructed on a corner lot that extends past the rear of the house along the side yard or abuts an alley requires approval from the City Engineer (Section 5-5-5B of the Grand Junction Zoning and Development Code).

The owner/applicant must correctly identify all property lines, easements, and rights-of-way and ensure the fence is located within the property's boundaries. Covenants, conditions, restrictions, easements and/or rights-of-way may restrict or prohibit the placement of fence(s). The owner/applicant is responsible for compliance with covenants, conditions, and restrictions which may apply. Fences built in easements may be subject to removal at the property owner's sole and absolute expense. Any modification of design and/or material as approved in this fence permit must be approved, in writing, by the Community Development Department Director.

I hereby acknowledge that I have read this application and the information and plot plan are correct; I agree to comply with any and all codes, ordinances, laws, regulations, or restrictions which apply.

I understand that failure to comply shall result in legal action, which may include but not necessarily be limited to removal of the fence(s) at the owner's cost.

Applicant's Signature Paul Labig

Date 5/8/02

Community Development's Approval Bill Nih

Date 5-14-02

City Engineer's Approval (if required) X [Signature]

Date 5-14-02

VALID FOR SIX MONTHS FROM DATE OF ISSUANCE (Section 9-3-2D Grand Junction Zoning & Development Code) (White: Planning) (Yellow: Customer) (Pink: Code Enforcement)


5' Irrigation Easement


32.56'

ACCEPTED *Pat Bushman*
ANY CHANGE OF SETBACKS MUST BE APPROVED BY THE CITY PLANNING DEPT. IT IS THE APPLICANT'S RESPONSIBILITY TO PROPERLY LOCATE AND IDENTIFY EASEMENTS AND PROPERTY LINES 12-11-01

APPROVED FOR CONSTRUCTION

Bill N...

5-14-02


Community Development Department

Date

60' Fence

60' Fence

NOTE:
THIS FENCE MUST BE 5' FROM SIDEWALK

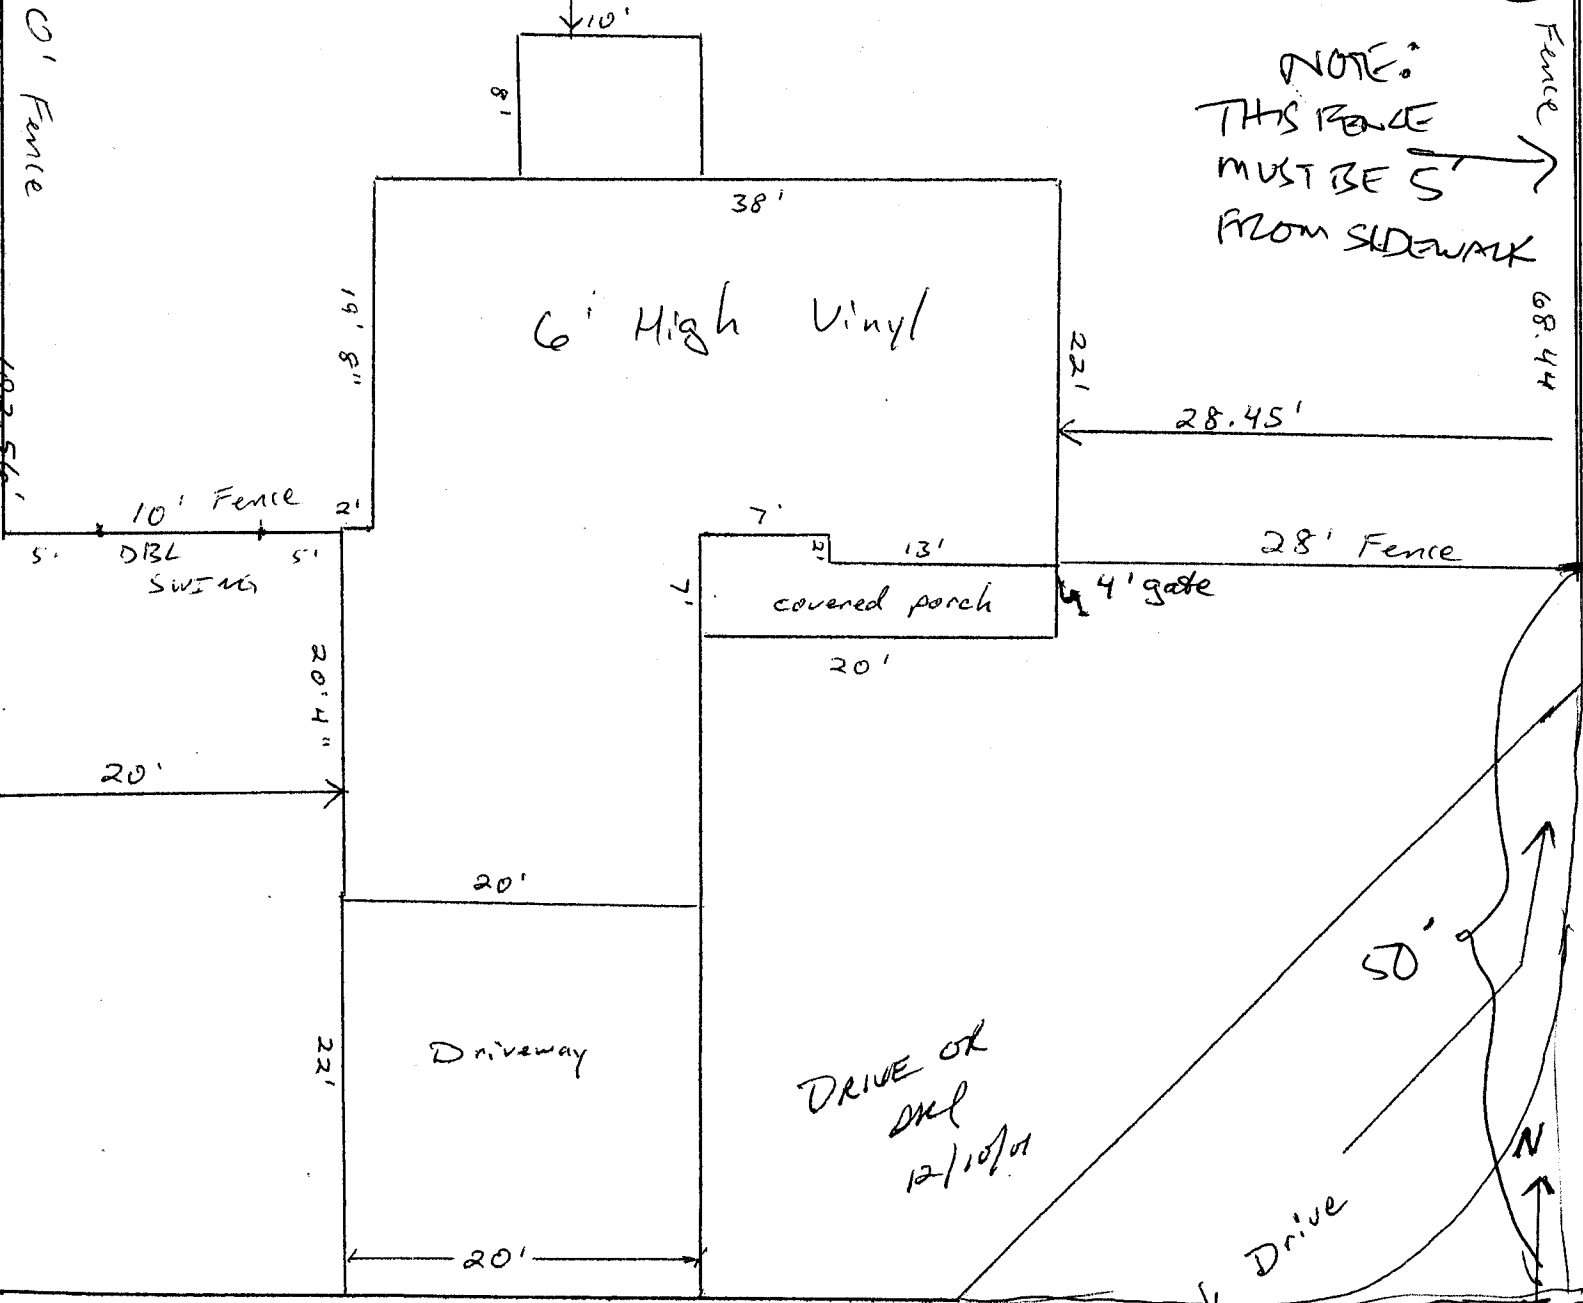

2840 Maverick Drive
Lot 9 Block 3 Filing 2
Arrowhead Acres II

#2943-303-64-010

Maverick Drive

