



FENCE PERMIT

GRAND JUNCTION COMMUNITY DEVELOPMENT DEPARTMENT

THIS SECTION TO BE COMPLETED BY APPLICANT

PLOT PLAN

PROPERTY ADDRESS 2387 W. Plateau Court

TAX SCHEDULE NO 2945-201-10-020

PROPERTY OWNER ELAINE PILZ

OWNER'S PHONE DAY 248-6131 EVE 257-7064

OWNER'S ADDRESS 2387 W Plateau Ct


CONTRACTOR self

CONTRACTOR'S PHONE -

CONTRACTOR'S ADDRESS -

FENCE MATERIAL cedar & split rail cedar

FENCE HEIGHT 4 foot split rail; 6' good neighbor & sided

 

Plot plan must show property lines and property dimensions, all easements, all rights-of-way, all structures, all setbacks from property lines, & fence height(s). NOTE: PROPERTY LINE IS LIKELY ONE FOOT OR MORE BEHIND THE SIDEWALK. See ATTACHED DRAWING

THIS SECTION TO BE COMPLETED BY COMMUNITY DEVELOPMENT DEPARTMENT STAFF

ZONE PD

SETBACKS: Front from property line (PL) or

SPECIAL CONDITIONS

from center of ROW, whichever is greater.

Side from PL Rear from PL

Fences exceeding six feet in height require a separate permit from the City/County Building Department. A fence constructed on a corner lot that extends past the rear of the house along the side yard or abuts an alley requires approval from the City Engineer (Section 4.1.J of the Grand Junction Zoning and Development Code).

The owner/applicant must correctly identify all property lines, easements, and rights-of-way and ensure the fence is located within the property's boundaries. Covenants, conditions, restrictions, easements and/or rights-of-way may restrict or prohibit the placement of fence(s). The owner/applicant is responsible for compliance with covenants, conditions, and restrictions which may apply. Fences built in easements may be subject to removal at the property owner's sole and absolute expense. Any modification of design and/or material as approved in this fence permit must be approved, in writing, by the Community Development Department Director.

I hereby acknowledge that I have read this application and the information and plot plan are correct; I agree to comply with any and all codes, ordinances, laws, regulations, or restrictions which apply. I understand that failure to comply shall result in legal action, which may include but not necessarily be limited to removal of the fence(s) at the owner's cost.

Applicant's Signature Elaine M. Pilz

Date 1-22-03

Community Development's Approval Gayle Henderson


Date 1-22-03

City Engineer's Approval (if required)


Date

VALID FOR SIX MONTHS FROM DATE OF ISSUANCE (Section 2.2.E.1.d Grand Junction Zoning & Development Code) (White: Planning) (Yellow: Customer) (Pink: Code Enforcement)



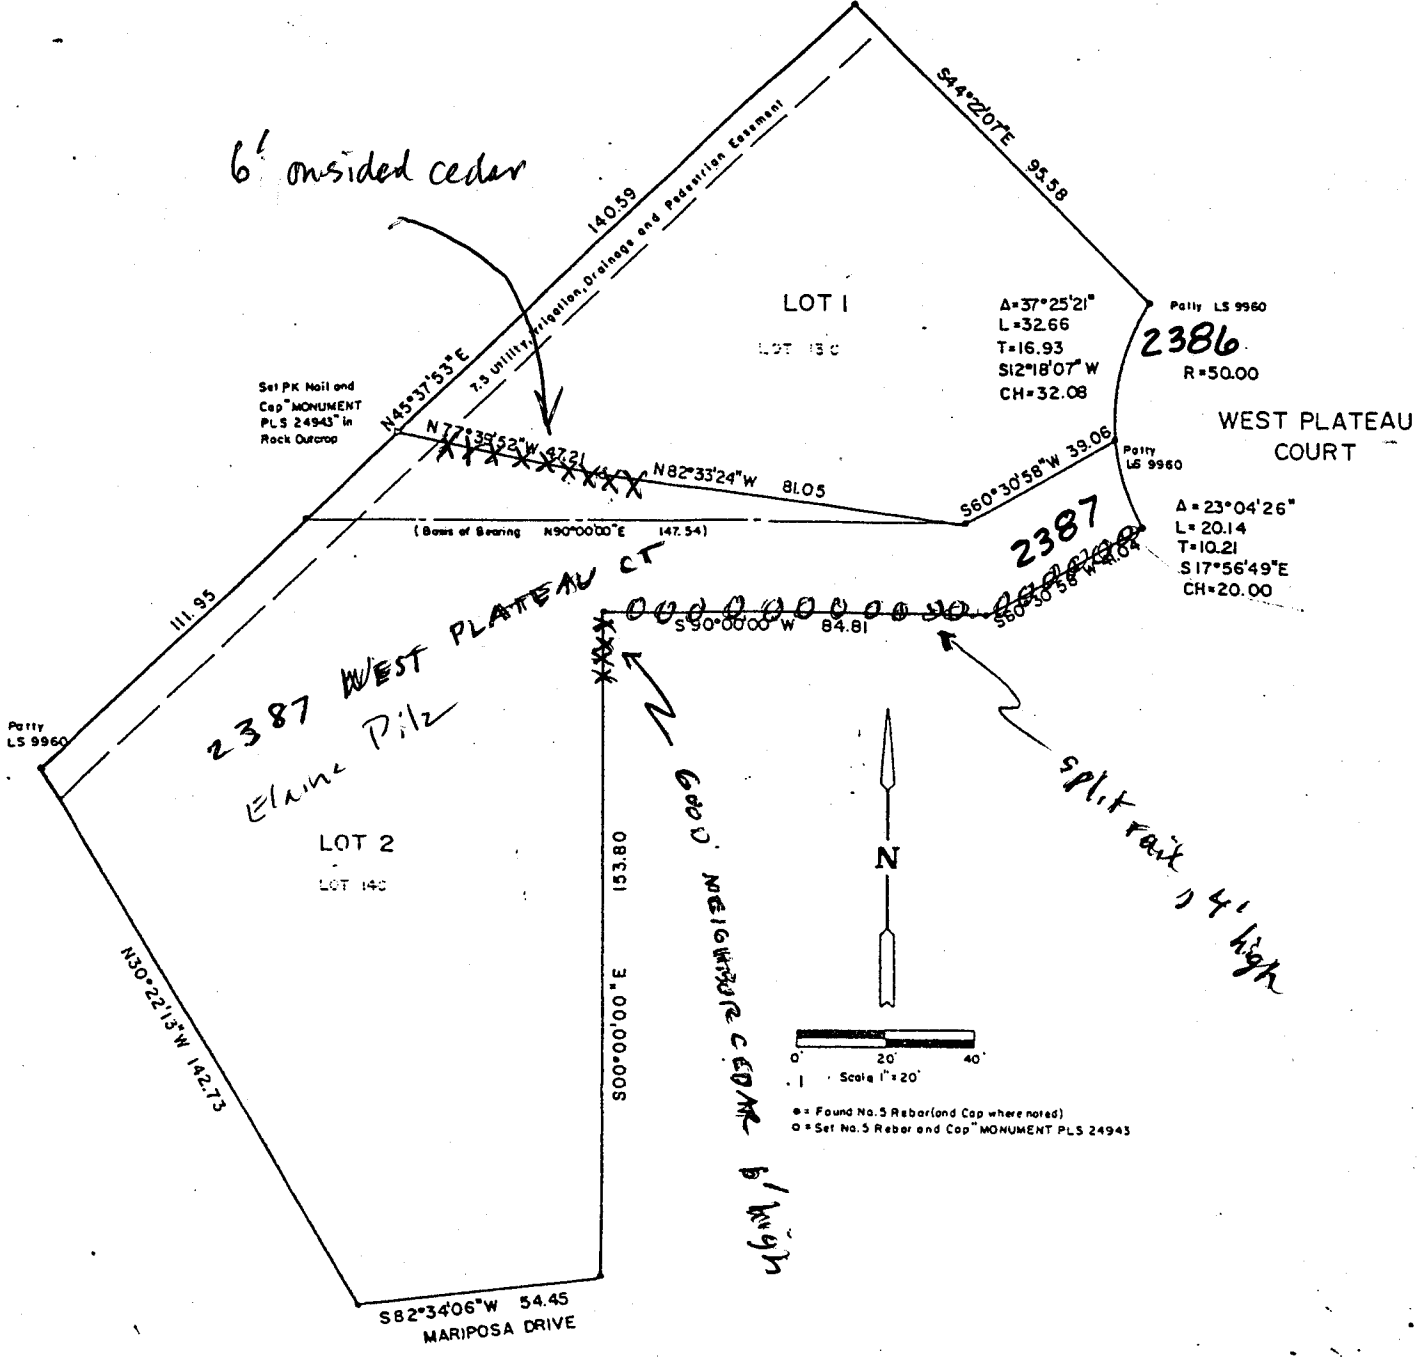



6' insided cedar

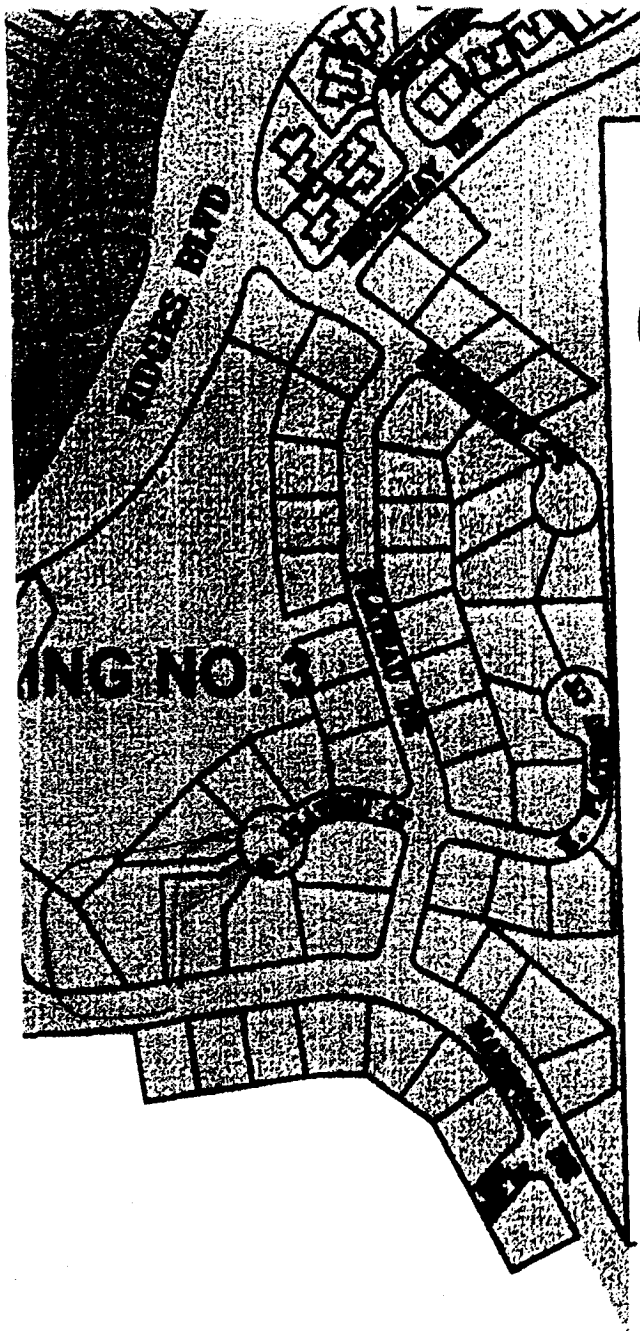

Note: A 5 foot irrigation and/or water easement has been granted to the Ridges Metropolitan District on all lot lines and may be in whole or in part of any portion thereof released by the Ridges Metropolitan District at some future date at their discretion as shown on the plat of THE RIDGES FILING NO. THREE.



RIDGES FILINGS (including all replats) No. 1-6

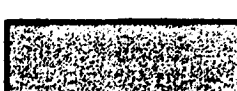-  FILING 1
-  FILING 2
-  FILING 3
-  FILING 4
-  FILING 5
-  FILING 6