



FENCE PERMIT
GRAND JUNCTION COMMUNITY DEVELOPMENT DEPARTMENT

THIS SECTION TO BE COMPLETED BY APPLICANT

PLOT PLAN

PROPERTY ADDRESS 2840 Acacia Ct. GJ 81503

TAX SCHEDULE NO 2943-303-62-009

PROPERTY OWNER Ray S. Anick II

OWNER'S PHONE 660-838-6204

OWNER'S ADDRESS same


CONTRACTOR Bookcliff Fence & Vinyl

CONTRACTOR'S PHONE 216-7828

CONTRACTOR'S ADDRESS 469 Penn St. Clifton CO 81520

FENCE MATERIAL Vinyl w/ Lattice & Solid

FENCE HEIGHT 6'

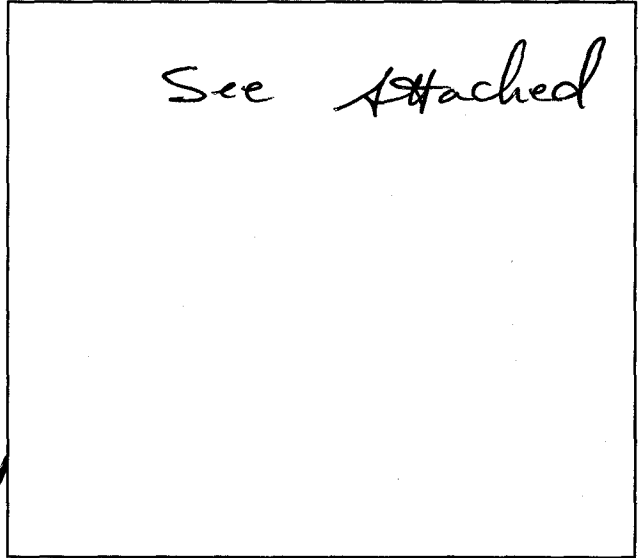

Plot plan must show property lines and property dimensions, all easements, all rights-of-way, all structures, all setbacks from property lines, & fence height(s). NOTE: PROPERTY LINE IS LIKELY ONE FOOT OR MORE BEHIND THE SIDEWALK.

THIS SECTION TO BE COMPLETED BY COMMUNITY DEVELOPMENT DEPARTMENT STAFF

ZONE RMF-5

SETBACKS: Front 20' from property line (PL) or from center of ROW, whichever is greater.

SPECIAL CONDITIONS is staying out of the 10' irrigation/drainage easement on North property line as noted on plot.

Side 0' from PL Rear 0' from PL

Fences exceeding six feet in height require a separate permit from the City/County Building Department. A fence constructed on a corner lot that extends past the rear of the house along the side yard or abuts an alley requires approval from the City Engineer (Section 4.1.J of the Grand Junction Zoning and Development Code).

The owner/applicant must correctly identify all property lines, easements, and rights-of-way and ensure the fence is located within the property's boundaries. Covenants, conditions, restrictions, easements and/or rights-of-way may restrict or prohibit the placement of fence(s). The owner/applicant is responsible for compliance with covenants, conditions, and restrictions which may apply. Fences built in easements may be subject to removal at the property owner's sole and absolute expense. Any modification of design and/or material as approved in this fence permit must be approved, in writing, by the Community Development Department Director.

I hereby acknowledge that I have read this application and the information and plot plan are correct; I agree to comply with any and all codes, ordinances, laws, regulations, or restrictions which apply. I understand that failure to comply shall result in legal action, which may include but not necessarily be limited to removal of the fence(s) at the owner's cost.

Applicant's Signature Paul Labby

Date 3/28/03

Community Development's Approval C. Jay Gibson

Date 4/2/03

City Engineer's Approval (if required)

Date

VALID FOR SIX MONTHS FROM DATE OF ISSUANCE (Section 2.2.E.1.d Grand Junction Zoning & Development Code) (White: Planning) (Yellow: Customer) (Pink: Code Enforcement)

S00°04'15"W

121.39'

10' IRRIGATION EASEMENT

32.71'

Solid Vinyl

122.51'

J.O.M. I.D. IRRIG/DRAINAGE EASEMENT

9

9545 SQ. FT.

S32°01'18"W  
125.11'  
72'

N82°58'23"E

77.28'

Vinyl w/lattice

Vinyl w/lattice

2842

289

↖

2890

2840 Acra Ct.  
Lot 8 Block 1  
Filing 3  
Arrowhead Acres II

48.00

Parcel # 2943-303-605-009

89°58'45"E

50.22'

110.07'

2'

5'

25'

8'6"

10'

4'5"

30'

6'7"

25'

3'6"

41'

5'

114'

5'x6"

5'

60'

114'