

FEE \$10.00

PERMIT # 13042



# FENCE PERMIT

GRAND JUNCTION COMMUNITY DEVELOPMENT DEPARTMENT

**THIS SECTION TO BE COMPLETED BY APPLICANT**

PROPERTY ADDRESS: 3056 DURAY AVE.

PROPERTY TAX NO: 294316113001

SUBDIVISION: CIMMERSON EAST

PROPERTY OWNER: DAN MULLOY

OWNER'S PHONE: 434-8315

OWNER'S ADDRESS: 3056 DURAY AVE

CONTRACTOR NAME: SELF

CONTRACTOR'S PHONE: SELF

CONTRACTOR'S ADDRESS: SELF

FENCE MATERIAL & HEIGHT: CEDAR / 6'

**PLOT PLAN**

See Attached

Plot plan must show property lines and property dimensions, all easements, all rights-of-way, all structures, all setbacks from property lines, & fence height(s). NOTE: PROPERTY LINE IS LIKELY ONE FOOT OR MORE BEHIND THE SIDEWALK.

**THIS SECTION TO BE COMPLETED BY COMMUNITY DEVELOPMENT DEPARTMENT STAFF**

ZONE PD SETBACKS: Front \_\_\_\_\_ from property line (PL) or \_\_\_\_\_ from center of ROW, whichever is greater.

SPECIAL CONDITIONS needs to be 1' from pedestrian easement Side \_\_\_\_\_ from PL Rear \_\_\_\_\_ from PL

Fences exceeding six feet in height require a separate permit from the City/County Building Department. A fence constructed on a corner lot that extends past the rear of the house along the side yard or abuts an alley requires approval from the City Engineer (Section 4.1.J of the Grand Junction Zoning and Development Code).

The owner/applicant must correctly identify all property lines, easements, and rights-of-way and ensure the fence is located within the property's boundaries. Covenants, conditions, restrictions, easements and/or rights-of-way may restrict or prohibit the placement of fence(s). The owner/applicant is responsible for compliance with covenants, conditions, and restrictions which may apply. Fences built in easements may be subject to removal at the property owner's sole and absolute expense. Any modification of design and/or material as approved in this fence permit must be approved, in writing, by the Community Development Department Director.

I hereby acknowledge that I have read this application and the information and plot plan are correct; I agree to comply with any and all codes, ordinances, laws, regulations, or restrictions which apply. I understand that failure to comply shall result in legal action, which may include but not necessarily be limited to removal of the fence(s) at the owner's cost.

Applicant's Signature [Signature]

Community Development's Approval [Signature]


City Engineer's Approval (if required) \_\_\_\_\_

Date 6-26-03


Date 6/26/03

Date \_\_\_\_\_

VALID FOR SIX MONTHS FROM DATE OF ISSUANCE (Section 2.2.E.1.d Grand Junction Zoning & Development Code)  
(White: Planning) (Yellow: Customer) (Pink: Code Enforcement)

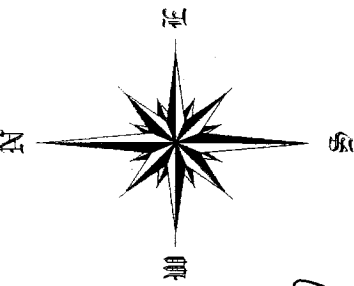

BLOCK 3  
LOT 1  
0.3 Acres.  
14513.3 Sq. ft.  
CIMARRON EAST

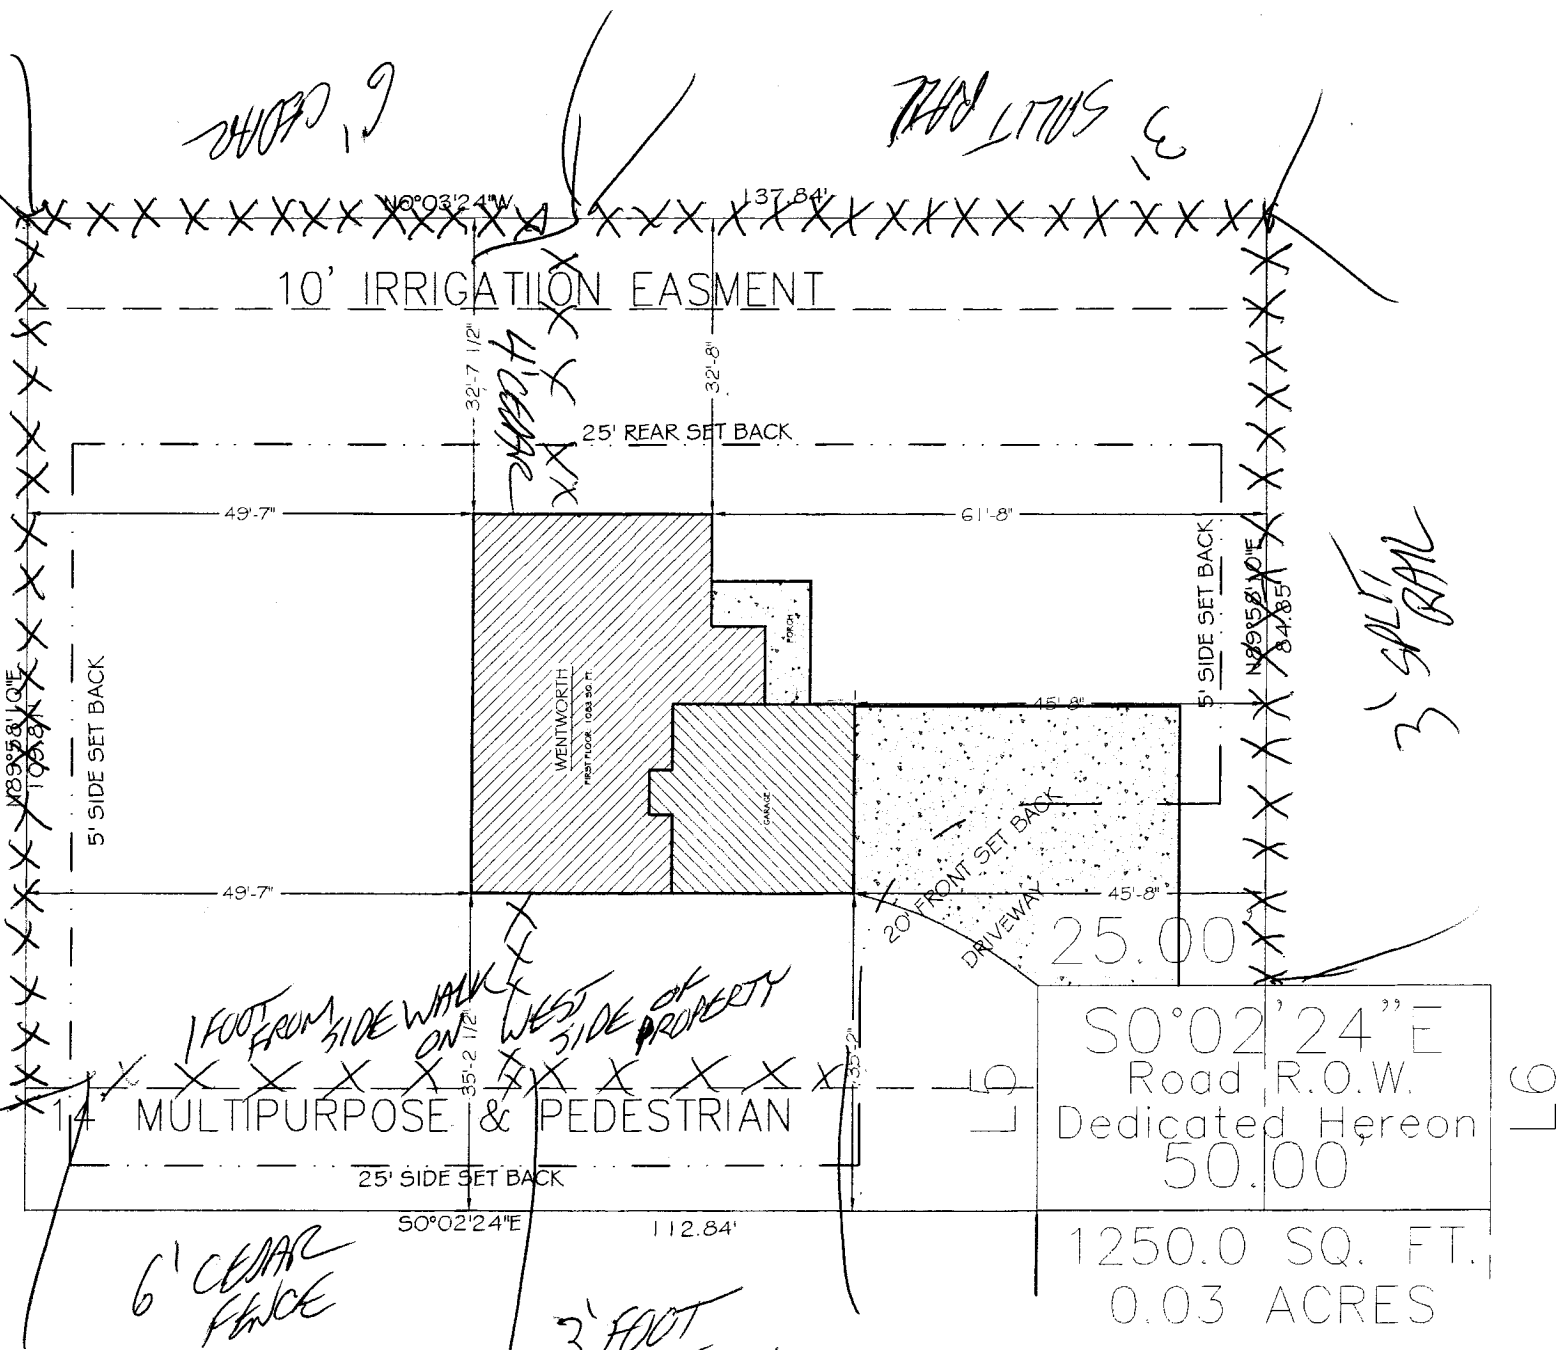

6' CEDAR FENCE

3' FOOT SPLIT RAIL

50°02'24" E  
Road R.O.W.  
Dedicated Hereon  
50.00  
1250.0 SQ. FT.  
0.03 ACRES