


(White: Planning)

## **FENCE PERMIT** GRAND JUNCTION COMMUNITY DEVELOPMENT DEPARTMENT

#THIS SECTION TO BE GO	OMPLETED BY APPLICANT : A TOTAL AND A STATE OF THE STATE	
PROPERTY ADDRESS: 471 Larry's Meadow Dr	₾ PLOT PLAN	
PROPERTY TAX NO: 2943-152-94-014		
SUBDIVISION: Summit Meadows West		
PROPERTY OWNER: Randy Cooper		
OWNER'S PHONE: 523-9128	see attached	
OWNER'S ADDRESS: 471 Larry's Meadow Dr.		
CONTRACTOR NAME: ZIKKING BILF		
CONTRACTOR'S PHONE: . S ******		
CONTRACTOR'S ADDRESS: Same		
FENCE MATERIAL & HEIGHT: Cedar 6 & Split rail		
Plot plan must show property lines and property dimensions, all easements, all rights-of-way, all structures, all setbacks from property lines, & fence height(s). NOTE: PROPERTY LINE IS LIKELY ONE FOOT OR MORE BEHIND THE SIDEWALK.		
THIS SECTION TO BE COMPLETED BY COMMUNITY DEVELOPMENT DEPARTMENT STAFF		
ZONE RMF-5	SETBACKS: Front from property line (PL) or	
SPECIAL CONDITIONS	from center of ROW, whichever is greater.	
	Sidefrom PL Rearfrom PL	
Fences exceeding six feet in height require a separate permit from the Clty/County Building Department. A fence constructed on a corner lot that extends past the rear of the house along the side yard or abuts an alley requires approval from the City Engineer (Section 4.1.J of the Grand Junction Zoning and Development Code).		
The owner/applicant must correctly identify all property lines, easements, and rights-of-way and ensure the fence is located within the property's boundaries. Covenants, conditions, restrictions, easements and/or rights-of-way may restrict or prohibit the placement of fence(s). The owner/applicant is responsible for compliance with covenants, conditions, and restrictions which may apply. Fences built in easements may be subject to removal at the property owner's sole and absolute expense. Any modification of design and/or material as approved in this fence permit must be approved, in writing, by the Community Development Department Director.		
! hereby acknowledge that I have read this application and the information and plot plan are correct; I agree to comply with any and all codes, ordinances, laws, regulations, or restrictions which apply. I understand that failure to comply shall result in legal action, which may include but not necessarily be limited to removal of the fence(s) at the owner's cost.		
Applicant's Signature Tanky L-Curch	Date 11 /8/04	
Community Development's Approval	Woon Date 11/8/04	
City Engineer's Approval (if required)	Date	

VALID FOR SIX MONTHS FROM DATE OF ISSUANCE (Section 2.2.E.1.d Grand Junction Zoning & Development Code) (White: Planning) (Yellow: Customer) (Pink: Code Enforcement)

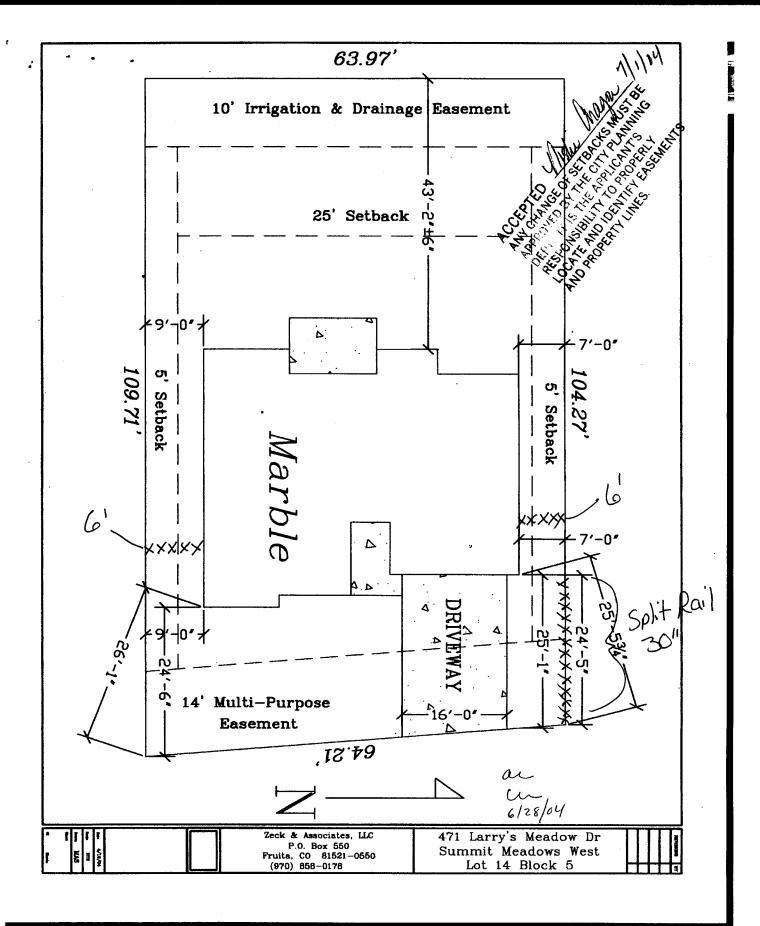

FEE\$ 10.00 TCP\$ None SIF\$ 292.00

## PLANNING CLEARANCE

(Single Family Residential and Accessory Structures)

Community Development Department

BLDG PERMIT NO.



	Your Bridge to a Batter Community
BLDG ADDRESS 471 Larry'S Mradow	Dr. SQ. FT. OF PROPOSED BLDGS/ADDITION
TAX SCHEDULE NO. 2943-152-94-014	SQ. FT. OF EXISTING BLDGS
SUBDIVISION Summit Meadows West	TOTAL SQ. FT. OF EXISTING & PROPOSED
FILING   BLK 5 LOT 14  (1) OWNER Zeck & Associates  (1) ADDRESS   P.O. Box 550  (1) TELEPHONE (970) \$58-0178  (2) APPLICANT Zeck & Associates (2) ADDRESS   P.O. Box 550  (2) TELEPHONE (970) \$58-0178	NO. OF DWELLING UNITS: Before: After: / this Construction NO. OF BUILDINGS ON PARCEL Before: After: / this Construction  USE OF EXISTING BUILDINGS  DESCRIPTION OF WORK & INTENDED USE  TYPE OF HOME PROPOSED:  Site Built Manufactured Home (UBC)  Manufactured Home (HUD)  Other (please specify)
property lines, ingress/egress to the property, driveway loc	MAXIMUM COVERAGE OF INTERIOR OF TRAFFIC ANNX#
Modifications to this Planning Clearance must be approved, in writing, by the Community Development Department. The structure authorized by this application cannot be occupied until a final inspection has been completed and a Certificate of Occupancy has been issued, if applicable, by the Building Department (Section 305, Uniform Building Code).  I hereby acknowledge that I have read this application and the information is correct; I agree to comply with any and all codes, ordinances, laws, regulations or restrictions which apply to the project. I understand that failure to comply shall result in legal action, which may include but not necessarily be limited to non-use of the building(s).  Applicant Signature  Date  Department Approval III IIIIII Date  Date  Occupancy has been completed and a Certificate of Occupancy has been complete	