FEE \$10.00

PERMIT# 13249






## GRAND JUNCTION COMMUNITY DEVELOPMENT DEPARTMENT

## THIS SECTION TO BE COMPLETED BY APPLICANT ##	
PROPERTY ADDRESS: 2502 Hoves	♠ PLOT PLAN
PROPERTY TAX NO: 2945 - 032 - 94 -001	
SUBDIVISION: Colonial Haights	
PROPERTY OWNER: 3/4 5100	
OWNER'S PHONE: 255- 4857	
OWNER'S ADDRESS: 2350 RD	
CONTRACTOR NAME: DER Ferce	
CONTRACTOR'S PHONE: 774-1724	
CONTRACTOR'S ADDRESS: D. 17	
FENCE MATERIAL & HEIGHT: 6' celm	Sel Attached
♠ Plot plan must show property lines and property dimensions, all easements, all rights-of-way, all structures, all setbacks from property lines, & fence height(s). NOTE: PROPERTY LINE IS LIKELY ONE FOOT OR MORE BEHIND THE SIDEWALK.	
THIS SECTION TO BE COMPLETED BY COMMUNITY DEVELOPMENT DEPARTMENT STAFF =	
ZONE LAG-5	SETBACKS: Front 20' from property line (PL) or
SPECIAL CONDITIONS	from center of ROW, whichever is greater.
	Side from PL Rear from PL
Fences exceeding six feet in height require a separate permit from the City/County Building Department. A fence constructed on a corner lot that extends past the rear of the house along the side yard or abuts an alley requires approval from the City Engineer (Section 4.1.J of the Grand Junction Zoning and Development Code).  The owner/applicant must correctly identify all property lines, easements, and rights-of-way and ensure the fence is located within the	
property's boundaries. Covenants, conditions, restrictions, easements and/or rights-of-way may restrict or prohibit the placement of fence(s). The owner/applicant is responsible for compliance with covenants, conditions, and restrictions which may apply. Fences built in easements may be subject to removal at the property owner's sole and absolute expense. Any modification of design and/or material as approved in this fence permit must be approved, in writing, by the Community Development Department Director.	
I hereby acknowledge that I have read this application and the information and plot plan are correct; I agree to comply with any and all codes, ordinances, laws, regulations, or restrictions which apply. I understand that failure to comply shall result in legal action, which may include but not necessarily be limited to removal of the fence(s) at the owner's cost.	
Applicant's Signature	Date 8/25/64
Community Development's Approval 4/18/10 Mag	
$\nu$	•

VALID FOR SIX MONTHS FROM DATE OF ISSUANCE (Section 2.2.E.1.d Grand Junction Zoning & Development Code)
(White: Planning) (Yellow: Customer) (Pink: Code Enforcement)

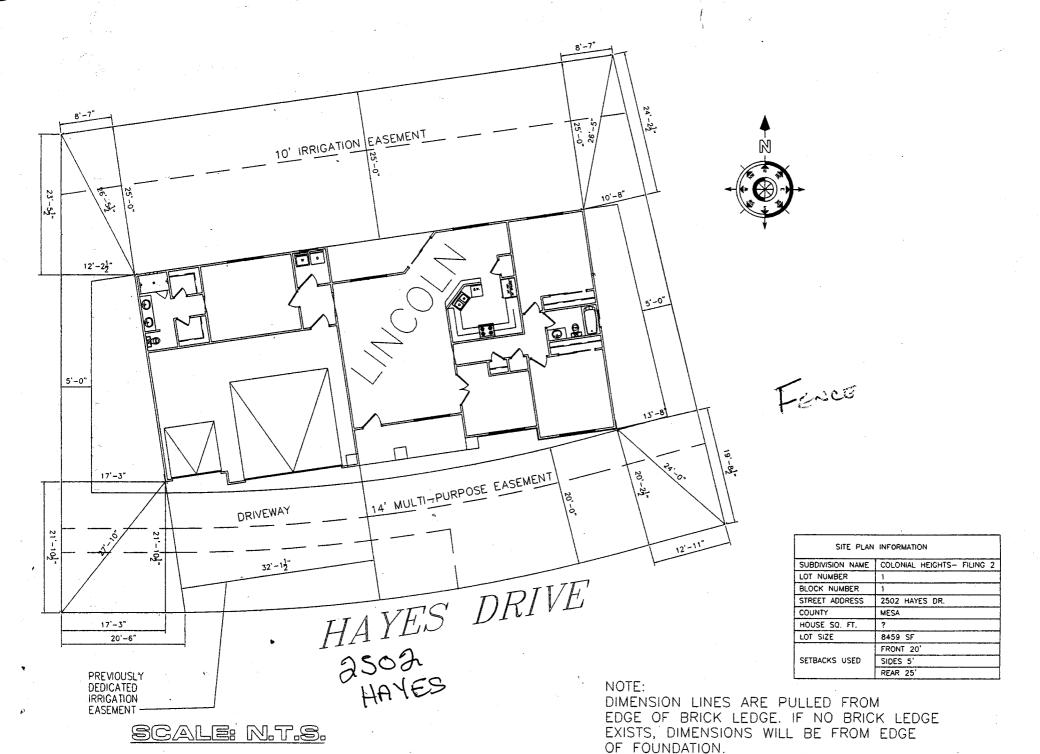

\\P4-server\2004 WORK FILES\DWG FILES\ALL PLATS\COLONIAL HEIGHTS\COLONIAL 2\COLONIAL BLK 1\COLONIAL HTS BLK 1 ONLY !!!!!!.dwg, 05/03/2004 11:40:06 AM, HP LaserJet 1100 (MS)