FEE \$10.00

PERMIT #

13727

GRAND JUNCTION COMMUNITY DEVELOPMENT DEPARTMENT

Property Address: 246 La Plata Ct. Grand Jct, Co P1523
Property Tax No: 2943 - 303 - 74 - 070
Subdivision: Durange Acres
Property Owner: TML Enfer Prises Inc
Owner's Telephone: 970-245-927/
Owner's Address: 2350 G Rol Grand Jcf. CD P1505
Contractor's Name: TML Enterprises, Inc
Contractor's Telephone: 970-245-9271
Contractor's Address: Same
Fence Material & Height: Cedar 6' split rail 4'
Plot plan must show property lines and property dimensions, all easements, all rights-of-way, all structures, all setbacks from property lines, and fence height(s). NOTE: Property line is likely one foot or more behind the sidewalk.

THIS SECTION TO BE COMPLETED BY COM	IMUNITY DEVELOPMENT DEPARTMENT STAFF
ZONERSF-4	SETBACKS: Front $\underline{\mathcal{QO'}}$ from property line (PL) or
SPECIAL CONDITIONS	from center of ROW, whichever is greater.
	Side from PL Rear from PL

Fences exceeding six feet in height require a separate permit from the City/County Building Department. A fence constructed on a corner lot that extends past the rear of the house along the side yard or abuts an alley requires approval from the City Engineer (Section 4.1.J of the Grand Junction Zoning and Development Code).


The owner/applicant must correctly identify all property lines, easements, and rights-of-way and ensure the fence is located within the property's boundaries. Covenants, conditions, restrictions, easements and/or rights-of-way may restrict or prohibit the placement of fence(s). The owner/applicant is responsible for compliance with covenants, conditions, and restrictions which may apply. Fences built in easements may be subject to removal at the property owner's sole and absolute expense. Any modification of design and/or material as approved in this fence permit must be approved, in writing, by the Community Development Department Director.

I hereby acknowledge that I have read this application and the information and plot plan are correct; I agree to comply with any and all codes, ordinances, laws, regulations, or restrictions which apply.) I understand that failure to comply shall result in legal action, which may include but not necessarily be limited to removal of the tence(s) at the owner's cost.

Applicant's Signature
Community Development's Approval
City Engineer's Approval (if required)

Date Date

VALID FOR SIX MONTHS FROM DATE OF ISSUANCE (Section 2.2.E.1.d Grand Junction Zoning & Development Code)

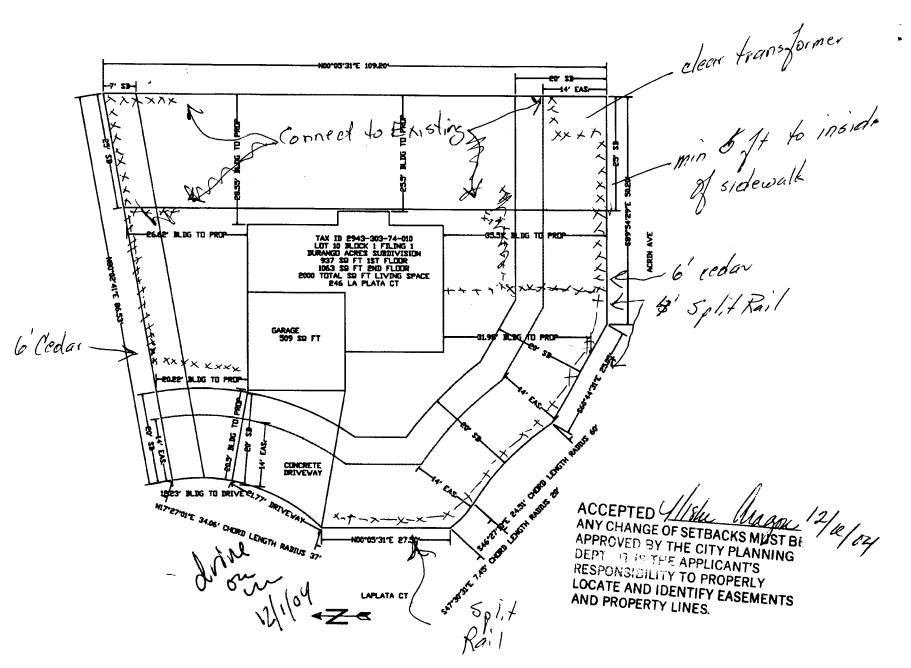

NUTE SCALE 1"=20"