

FEE \$10.00



PERMIT # 13795

FENCE PERMIT
GRAND JUNCTION COMMUNITY DEVELOPMENT DEPARTMENT

Property Address: 2857 Duke Drive
Property Tax No: 2943-071-25-004
Subdivision: The LEGENDS
Property Owner: LINDA ROSE
Owner's Telephone: 970-243-1318
Owner's Address: 2857 Duke Drive GJ, CO 81502
Contractor's Name: Arrowhead Landscaping & Fencing, Inc.
Contractor's Telephone: 970-242-0785
Contractor's Address: 2840 Arvin Court GJ, CO 81503
Fence Material & Height: 6' Vinyl Privacy

Plot plan must show property lines and property dimensions, all easements, all rights-of-way, all structures, all setbacks from property lines, and fence height(s). NOTE: Property line is likely one foot or more behind the sidewalk.

THIS SECTION TO BE COMPLETED BY COMMUNITY DEVELOPMENT DEPARTMENT STAFF
ZONE PD
SETBACKS: Front 20' from property line (PL) or
SPECIAL CONDITIONS
Side 0' from PL Rear 0' from PL

Fences exceeding six feet in height require a separate permit from the City/County Building Department. A fence constructed on a corner lot that extends past the rear of the house along the side yard or abuts an alley requires approval from the City Engineer (Section 4.1.J of the Grand Junction Zoning and Development Code).

The owner/applicant must correctly identify all property lines, easements, and rights-of-way and ensure the fence is located within the property's boundaries. Covenants, conditions, restrictions, easements and/or rights-of-way may restrict or prohibit the placement of fence(s). The owner/applicant is responsible for compliance with covenants, conditions, and restrictions which may apply. Fences built in easements may be subject to removal at the property owner's sole and absolute expense. Any modification of design and/or material as approved in this fence permit must be approved, in writing, by the Community Development Department Director.

I hereby acknowledge that I have read this application and the information and plot plan are correct; I agree to comply with any and all codes, ordinances, laws, regulations, or restrictions which apply. I understand that failure to comply shall result in legal action, which may include but not necessarily be limited to removal of the fence(s) at the owner's cost.

Applicant's Signature [Signature] Date 6/17/05
Community Development's Approval [Signature] Date 6/17/05
City Engineer's Approval (if required) Date

VALID FOR SIX MONTHS FROM DATE OF ISSUANCE (Section 2.2.E.1.d Grand Junction Zoning & Development Code)

(White: Planning) (Yellow: Customer) (Pink: Code Enforcement)

RECEIVED APR 15 2005

LANDSCAPE PLAN

Case No 04/03/2005

File No 2857 Duke

Property Address 2857 Duke Drive

City Grand Junction

County Mesa

State CO

Zip 81501

Borrower


Lender/Client Linda Rose

L/C Address 2857 Duke Dr., GJ (970) 243-1318

Appraiser Name

Appr Address

Legends
 Plan Type *landscape*
 Subject to Notes
 Rejected
 Date
 President/NOA *[Signature]*

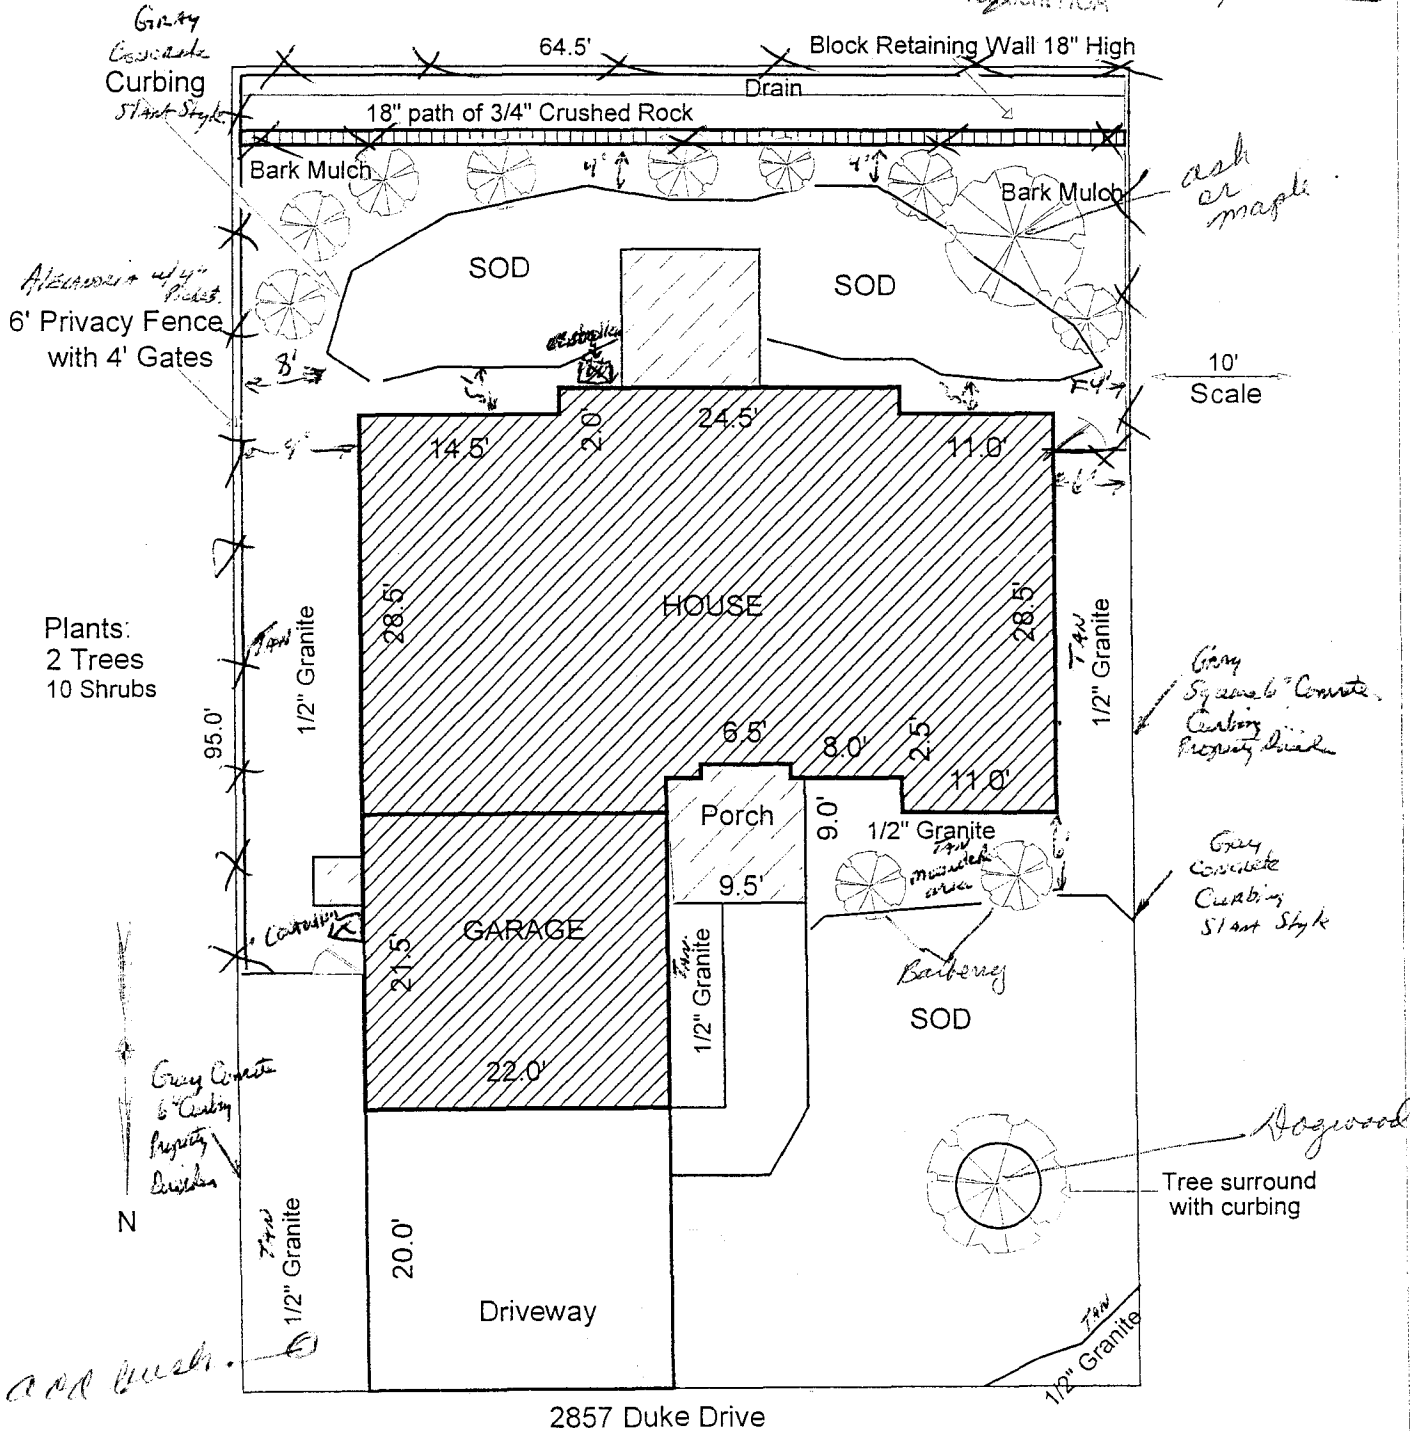

Plants:
2 Trees
10 Shrubs

10'
Scale

N

2857 Duke Drive

Scale: 1 = 12