FEE \$10.00

**FENCE PERMIT** GRAND JUNCTION COMMUNITY DEVELOPMENT DEPARTMENT

Property Address: 725 Willow Creek Road
Property Tax No: 2701 - 333 - 38 - 071
Subdivision: Spanish, Trails Subdivision
Property Owner: Susan Anderson
Owner's Telephone:
Owner's Address: 725 Willow Creek Road
Contractor's Name: William Fister
Contractor's Telephone: 244-9092
Contractor's Address: 556 Court Road
Fence Material & Height: 4' Tan Nicgra
Plot plan must show property lines and property dimensions, all easements, all rights-of-way, all structures, all setbacks

Plot plan must show property lines and property dimensions, all easements, all rights-of-way, all structures, all setbacks from property lines, and fence height(s). NOTE: Property line is likely one foot or more behind the sidewalk.

THIS SECTION TO BE COMPLETED BY	COMMUNITY DEVELOPMENT DEPARTMENT STAFF
ZONE	SETBACKS: Front <u>201</u> from property line (PL) or
SPECIAL CONDITIONS Sec funce restri	1 Chores from center of ROW, whichever is greater.
for lots facing CANYON View	) Arside 0' from PL Rear 0' from PL

Fences exceeding six feet in height require a separate permit from the City/County Building Department. A fence constructed on a corner lot that extends past the rear of the house along the side yard or abuts an alley requires approval from the City Engineer (Section 4.1.J of the Grand Junction Zoning and Development Code).

<u>The owner/applicant must correctly identify all property lines, easements, and rights-of-way and ensure the fence is located within the property's boundaries</u>. Covenants, conditions, restrictions, easements and/or rights-of-way may restrict or prohibit the placement of fence(s). The owner/applicant is responsible for compliance with covenants, conditions, and restrictions which may apply. Fences built in easements may be subject to removal at the property owner's sole and absolute expense. Any modification of design and/or material as approved in this fence permit must be approved, in writing, by the Community Development Department Director.

I hereby acknowledge that I have read this application and the information and plot plan are correct; I agree to comply with any and all codes, ordinances, laws, regulations, or restrictions which apply. I understand that failure to comply shall result in legal action, which may include but not necessarily be ignified to removal of the fence(s) at the owner's cost.

Applicant's Signature	1.1
Community Development's Approval	Mishi anagos
City Engineer's Approval (if required)	

Date 10/14 Date Date


VALID FOR SIX MONTHS FROM DATE OF ISSUANCE (Section 2.2.E.1.d Grand Junction Zoning & Development Code)

(White: Planning)

(Yellow: Customer)

(Pink: Code Enforcement)

PERMIT #

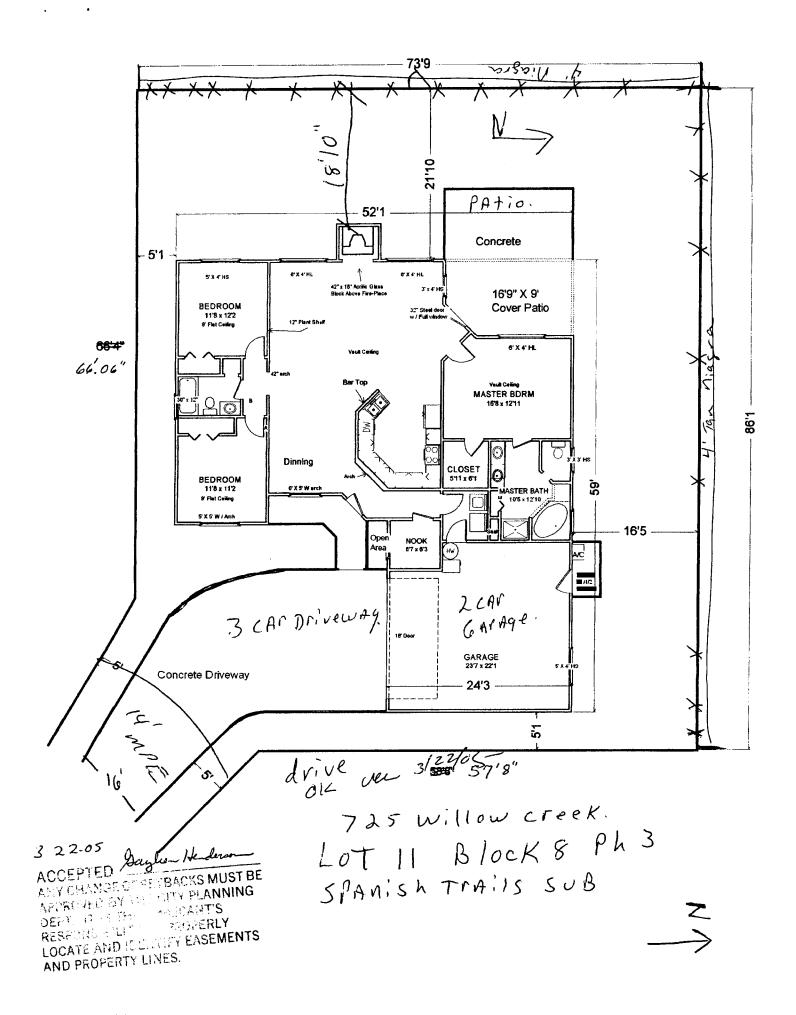

۰.