FEE \$18.00 W/ Rev Permit 14606
FENCE PERMIT
GRAND JUNCTION COMMUNITY DEVELOPMENT DEPARTMENT
P
Property Address: 703 24 3/4 RO, Grand Jot, CO 81505
Property Tax No: 2701 - 334 - 22 - 002
Subdivision: Fair MINOR
Property Owner: Donald R - Joyce F Anderson
Owner's Telephone: 970-241-1755 res 248-2822 WE Owner's Address: 703 243/4 RD, Grand Jd, CO 81505
Owner's Address: 703 243/4 RD, Grand Jd, CO 81505
Contractor's Name:
Contractor's Telephone:
Contractor's Address:
Fence Material & Height: 10' and 3' Viny! Force

Plot plan must show property lines and property dimensions, all easements, all rights-of-way, all structures, all setbacks from property lines, and fence height(s). NOTE: Property line is likely one foot or more behind the sidewalk.

THIS SECTION TO BE COMPLETED BY COM	MUNITY DEVELOPMENT DEPARTMENT STAFF
ZONE	SETBACKS: Front from property line (PL) or
SPECIAL CONDITIONS <u>PEVOCABLE Permit</u>	from center of ROW, whichever is greater.
approved per attached plan	Side from PL Rear from PL

Fences exceeding six feet in height require a separate permit from the City/County Building Department. A fence constructed on a corner lot that extends past the rear of the house along the side yard or abuts an alley requires approval from the City Engineer (Section 4.1.J of the Grand Junction Zoning and Development Code).

The owner/applicant must correctly identify all property lines, easements, and rights-of-way and ensure the fence is located within the property's boundaries. Covenants, conditions, restrictions, easements and/or rights-of-way may restrict or prohibit the placement of fence(s). The owner/applicant is responsible for compliance with covenants, conditions, and restrictions which may apply. Fences built in easements may be subject to removal at the property owner's sole and absolute expense. Any modification of design and/or material as approved in this fence permit must be approved, in writing, by the Community Development Department Director.

I hereby acknowledge that I have read this application and the information and plot plan are correct; I agree to comply with any and all codes, ordinances, laws, regulations, or restrictions which apply. I understand that failure to comply shall result in legal action, which may include but not necessarily be limited to removal of the fence(s) at the owner's cost.

Applicant's Signature	Date 5-3.07
Community Development's Approval	Date 5/3/07
City Engineer's Approval (if required)	Date

VALID FOR SIX MONTHS FROM DATE OF ISSUANCE (Section 2.2.E.1.d Grand Junction Zoning & Development Code)

(White: Planning)

(Yellow: Customer)

(Pink: Code Enforcement)

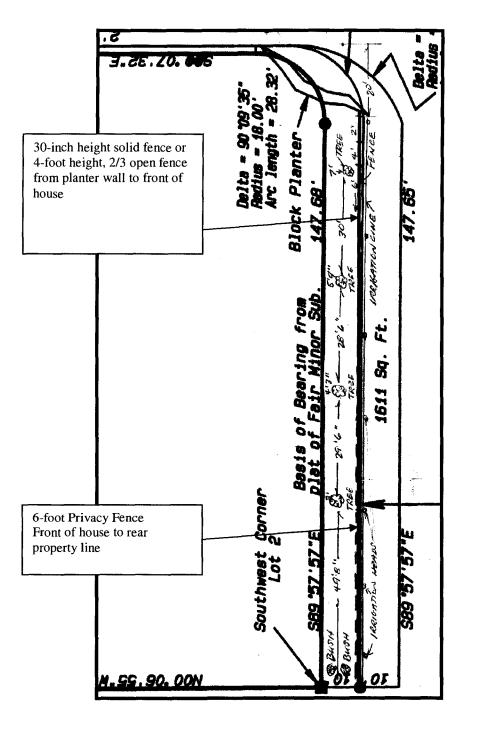


EXHIBIT C - SITE PLAN IMPROVEMENTS IN RIGHT-OF-WAY

ر

•

,