

# Fence Permit

PERMIT # **NO** 15389

Public Works & Planning Department  
250 North 5th Street  
Grand Junction, CO 81501  
Phone: (970) 244-1430 FAX: (970) 256-4031

Fee \$10.00

Property Address: 678 Arthur Ct.  
 Property Tax No: 2945-032-88-001  
 Subdivision: Colonial Heights  
 Property Owner: Hillary & Brian Wilson  
 Owner's Telephone: 257-9243  
 Owner's Address: 678 Arthur Ct.  
 Contractor's Name: Eagle Landscaping  
 Contractor's Telephone: \_\_\_\_\_  
 Contractor's Address: \_\_\_\_\_  
 Fence Material & Height: PEDAR 6 FOOT

Plot plan must show property lines and property dimensions, all easements, all rights-of-way, all structures, all setbacks from property lines, and fence height(s). NOTE: Property line is likely one foot or more behind the sidewalk.

**THIS SECTION TO BE COMPLETED BY PLANNING STAFF**

ZONE <u>RS</u>	SETBACKS: Front <u>20</u> from property line (PL) or
SPECIAL CONDITIONS _____	_____ from center of ROW, whichever is greater.
_____	Side <u>0</u> from PL Rear <u>0</u> from PL

Fences exceeding six feet in height require a separate permit from the City/County Building Department. A fence constructed on a corner lot that extends past the rear of the house along the side yard or abuts an alley requires approval from the City Engineer (Section 4.1.J of the Grand Junction Zoning and Development Code).

The owner/applicant must correctly identify all property lines, easements, and rights-of-way and ensure the fence is located within the property's boundaries. Covenants, conditions, restrictions, easements and/or rights-of-way may restrict or prohibit the placement of fence(s). The owner/applicant is responsible for compliance with covenants, conditions, and restrictions which may apply. Fences built in easements may be subject to removal at the property owner's sole and absolute expense. Any modification of design and/or material as approved in this fence permit must be approved, in writing, by the Public Works & Planning Department Director.

I hereby acknowledge that I have read this application and the information and plot plan are correct; I agree to comply with any and all codes, ordinances, laws, regulations, or restrictions which apply. I understand that failure to comply shall result in legal action, which may include but not necessarily be limited to removal of the fence(s) at the owner's cost.

Applicant's Signature Hillary Wilson Date 7/11/08  
 Planning Approval [Signature] Date 7/14/08  
 City Engineer's Approval (if required) \_\_\_\_\_ Date \_\_\_\_\_


**VALID FOR SIX MONTHS FROM DATE OF ISSUANCE** (Section 2.2.E.1.d Grand Junction Zoning & Development Code)

(White: Planning) (Yellow: Applicant) (Pink: Neighborhood Services)

# City of Grand Junction GIS Zoning Map ©



SCALE 1 : 238

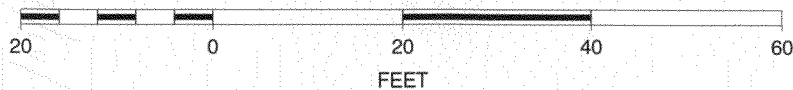

ACCEPTED *Lydia Ryzhik* 7/11/08  
ANY CHANGE OF SETBACKS MUST BE  
APPROVED BY THE CITY PLANNING DIVISION  
IT IS THE APPLICANT'S RESPONSIBILITY TO  
PROPERLY LOCATE AND IDENTIFY  
SETBACKS AND PROPERTY LINES.

