

Fence Permit

PERMIT # Nº 15787

Fee \$10.00

Public Works & Planning Department 250 North 5th Street Grand Junction, CO 81501 Phone: (970) 244-1430 FAX: (970) 256-4031

Property Address: 193 Sun Hawk DR			
Property Tax No: 2943- 321-26-003			
Subdivision: Hawko Nest			
Property Owner: 30 RJ UC			
Owner's Telephone: 242-8134			
Owner's Address: 710 5 15th			
Contractor's Name: RITEWAY SUSTEM'S UC			
Contractor's Telephone: 250-7244			
Contractor's Address: 761 25 Rd			
Fence Material & Height: 6' VINY/ GATE 56'			
Plot plan must show property lines and property dimensions, all easements, all rights-of-way, all structures, al setbacks from property lines, and fence height(s). NOTE: Property line is likely one foot or more behind the sidewalk			
THIS SECTION TO BE COMPLETED BY PLANNING STAFF			
ZONE <u>R-</u> SETBACKS: Front from property line (PL) or			
SPECIAL CONDITIONS from center of ROW, whichever is greater.			
Side from PL Rear from PL			

Fences exceeding six feet in height require a separate permit from the City/County Building Department. A fence constructed on a corner lot that extends past the rear of the house along the side yard or abuts an alley requires approval from the City Engineer (Section 4.1.J of the Grand Junction Zoning and Development Code).

The owner/applicant must correctly identify all property lines, easements, and rights-of-way and ensure the fence is located within the property's boundaries. Covenants, conditions, restrictions, easements and/or rights-of-way may restrict or prohibit the placement of fence(s). The owner/applicant is responsible for compliance with covenants, conditions, and restrictions which may apply. Fences built in easements may be subject to removal at the property owner's sole and absolute expense. Any modification of design and/or material as approved in this fence permit must be approved, in writing, by the Public Works & Planning Department Director.

I hereby acknowledge that I have read this application and the information and plot plan are correct; I agree to comply with any and all codes, ordinances, laws, regulations or restrictions which apply. I understand that failure to comply shall result in legal action, which may include but not necessarily be limited to removal of the fence(s) at the owner's cost.


Applicant's Signature	Date_/	0-07.09
Planning Approval	Date	10-7-09
City Engineer's Approval (if required)	Date	_, _,

VALID FOR SIX MONTHS FROM DATE OF ISSUANCE (Section 2.2.E.1.d Grand Junction Zoning & Development Code)

(White: Planning)

(Yellow: Applicant)

(Pink: Neighborhood Services)

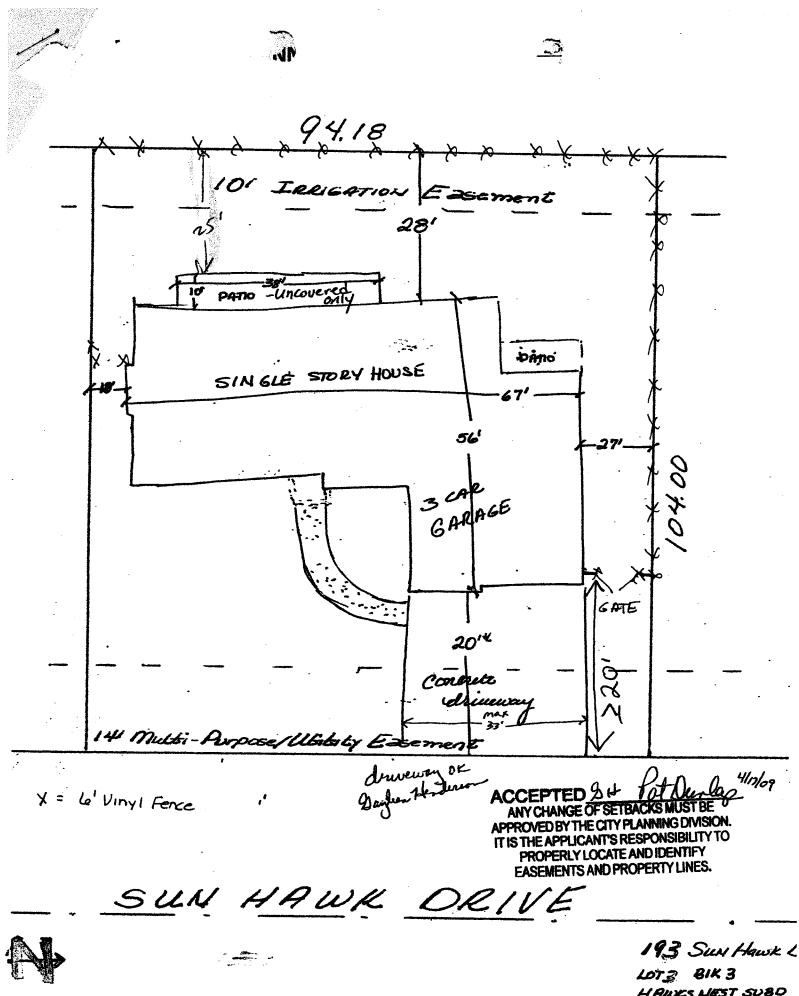

HAWKS NEST SUBD Fil One