

Fence Permit

Public Works & Planning Department 250 North 5th Street **Grand Junction, CO 81501** Phone: (970) 244-1430 FAX: (970) 256-4031

15789 ·


PERMIT # Nº

Fee \$10.00

| Property Address: 2995 Golden | - lawk | Way | | |
|---|--|--|--|--|
| Property Tax No: 2943-321 - 30 - | 018 | | | |
| Subdivision: HAWKS NEST | | | | |
| Property Owner: 30 Rd, UC | | | | |
| Owner's Telephone: 242-8134 | | | | |
| Owner's Address: 710 S1 Sb St | ··- | | | 40.0 |
| Contractor's Name: RITERIAN System | <u>ns</u> | | - | |
| Contractor's Telephone: 250-7244 | | | | |
| Contractor's Address: 761 25 Pd | | | | |
| Fence Material & Height: 61 VIOY 1 | | | | |
| Plot plan must show property lines and property dimesetbacks from property lines, and fence height(s). NOTE | | | | |
| THIS SECTION TO BE COM | Plereo sy | PLANNING ST | AFF | |
| | | | | |
| ZONE R-Y | | : Front | _ from pro | operty line (PL) or |
| ZONE _ R-Y SPECIAL CONDITIONS | SETBACKS | : Front | | operty line (PL) or chever is greater. |
| • | SETBACKS: | : Front | ROW, whic | , |
| • | SETBACKS Side | : Front from center of F from PL y Building Departm | ROW, which | chever is greater from PL e constructed on a co |
| SPECIAL CONDITIONS Fences exceeding six feet in height require a separate permit from ner lot that extends past the rear of the house along the side yard | Side n the City/County or abuts an alley ements, and right nents and/or right covenants, condi- | 
| SPECIAL CONDITIONS Fences exceeding six feet in height require a separate permit from ner lot that extends past the rear of the house along the side yard 4.1.J of the Grand Junction Zoning and Development Code). The owner/applicant must correctly identify all property lines, easo property's boundaries. Covenants, conditions, restrictions, easemence(s). The owner/applicant is responsible for compliance with an easements may be subject to removal at the property owner's statements. 




VALID FOR SIX MONTHS FROM DATE OF ISSUANCE (Section 2.2.E.1.d Grand Junction Zoning & Development Code)

(White: Planning) (Yellow: Applicant) (Pink: Neighborhood Services)

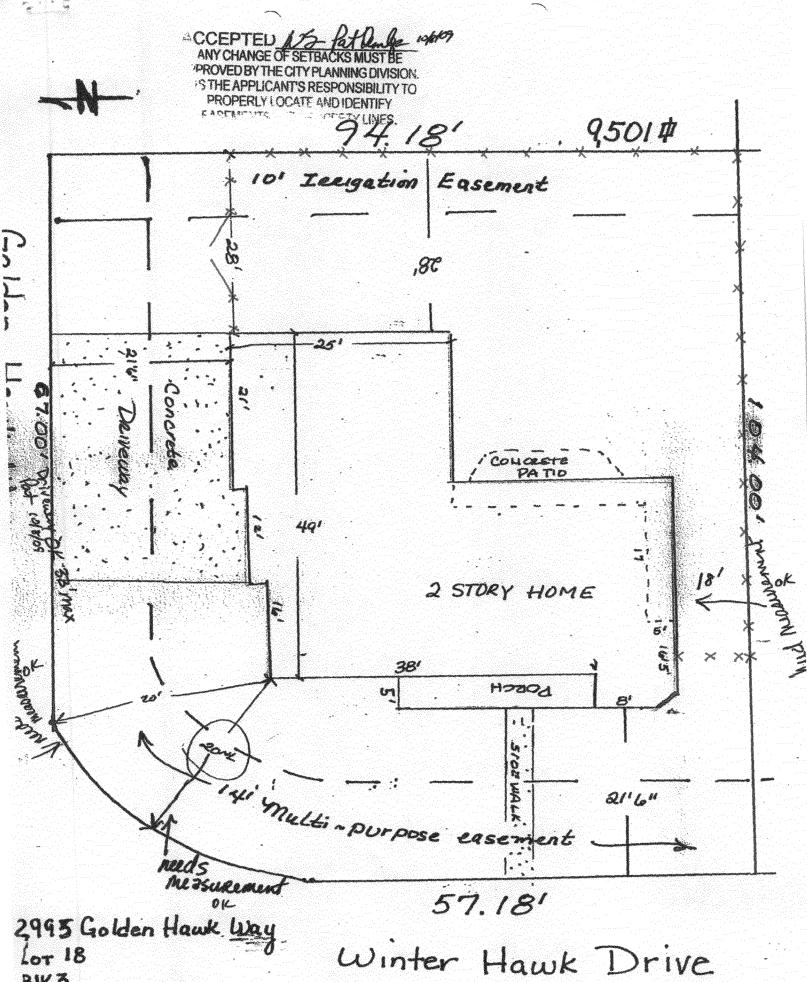

BIK 3 Hawks Nest Sund.