

Fence Permit

PERMIT # Nº

15933

Fee \$10.00

Public Works & Planning Department 250 North 5th Street Grand Junction, CO 81501 Phone: (970) 244-1430 FAX: (970) 256-4031


VALID FOR SIX MONTHS FROM DATE OF ISSUANCE (Section 2.2.E.1.d Grand Junction Zoning & Development Code)

(White: Planning)

(Yellow: Applicant)

(Pink: Neighborhood Services)



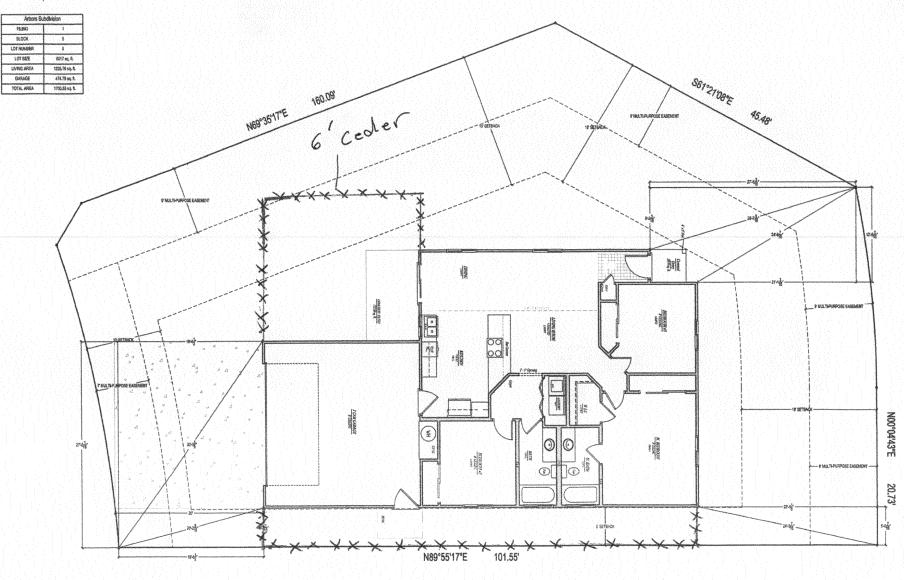



The Maple

at 561 Crestwood Ave - Blk 5-Lot 5

Revisions

A

B

C

D

E

Oness #p

AD1

E2V bate 9/3/0

Dete 8/27//

State 1/4" = 1

SITE PL/