

# Fence Permit

PERMIT # NO 16358

Public Works & Planning Department

250 North 5th Street

Grand Junction, CO 81501

Phone: (970) 244-1430 FAX: (970) 256-4031

Fee \$10.00

PMT - 2010-431

Property Address: 2981 Fenwick Ln 81504

Property Tax No: 2443-201-18-003

Subdivision: Swan Meadows

Property Owner: Sunshine II Construction

Owner's Telephone: 970-255-8853

Owner's Address: 2350 GRd

Contractor's Name: Valleywide Fence

Contractor's Telephone: 970-523-8150

Contractor's Address: 2105 E Main St.

Fence Material & Height: Li Vinyl Fence (4' Solid/2' top open)

Plot plan must show property lines and property dimensions, all easements, all rights-of-way, all structures, all setbacks from property lines, and fence height(s). NOTE: Property line is likely one foot or more behind the sidewalk.

ZONE <u>R-4</u>		SETBACKS: Front _____ from property line (PL) or	
SPECIAL CONDITIONS _____		_____ from center of ROW, whichever is greater.	
_____	Side _____ from PL	Rear _____ from PL	_____

Fences exceeding six feet in height require a separate permit from the City/County Building Department. A fence constructed on a corner lot that extends past the rear of the house along the side yard or abuts an alley requires approval from the City Engineer (Section 4.1.J of the Grand Junction Zoning and Development Code).

The owner/applicant must correctly identify all property lines, easements, and rights-of-way and ensure the fence is located within the property's boundaries. Covenants, conditions, restrictions, easements and/or rights-of-way may restrict or prohibit the placement of fence(s). The owner/applicant is responsible for compliance with covenants, conditions, and restrictions which may apply. Fences built in easements may be subject to removal at the property owner's sole and absolute expense. Any modification of design and/or material as approved in this fence permit must be approved, in writing, by the Public Works & Planning Department Director.

I hereby acknowledge that I have read this application and the information and plot plan are correct; I agree to comply with any and all codes, ordinances, laws, regulations, or restrictions which apply. I understand that failure to comply shall result in legal action, which may include but not necessarily be limited to removal of the fence(s) at the owner's cost.

Applicant's Signature [Signature] Date 12/3/10

Planning Approval [Signature] Date 12/8/10


City Engineer's Approval (if required) \_\_\_\_\_ Date \_\_\_\_\_

**VALID FOR SIX MONTHS FROM DATE OF ISSUANCE** (Section 2.2.E.1.d Grand Junction Zoning & Development Code)

(White: Planning)

(Yellow: Applicant)

(Pink: Neighborhood Services)

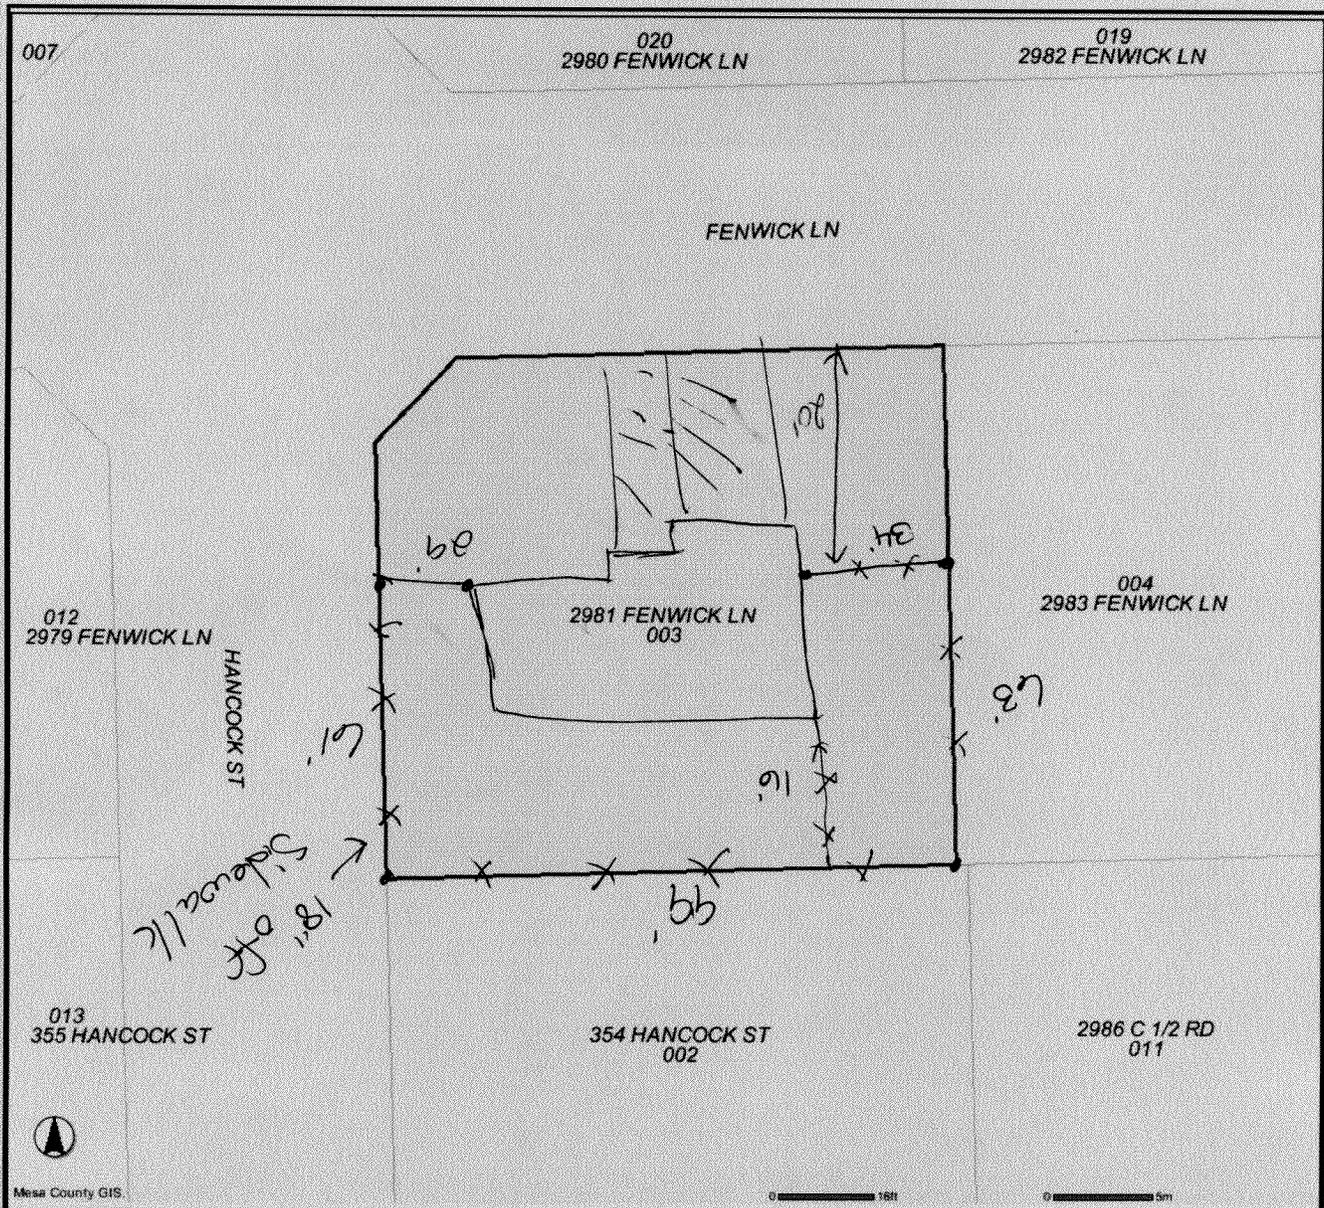

Mesa County GIS  
 544 Rood Ave.  
 Grand Junction, CO 81501

DISCLAIMER : The Geographic Information System (GIS) and its components are designed as a source of reference for answering inquiries, for planning and for modeling. GIS is not intended or does not replace legal description information in the chain of title and other information contained in official government records such as the County Clerk and Records office or the courts. In addition, the representations of locations in this GIS cannot be substituted for actual legal surveys.

LEGEND	
+ Hospitals	Colorado National Monument
* Police Stations	BLM Special Areas
▲ Fire Stations	Black Ridge Canyons
▬ Schools	COLORADO CANYONS NATIONAL CONSERVATION AREA
≡ State Highways	BLM
— Roads	National Forest
■ Lakes	
~ Canals	