




FENCE PERMIT
GRAND JUNCTION COMMUNITY DEVELOPMENT DEPARTMENT

THIS SECTION TO BE COMPLETED BY APPLICANT

PROPERTY ADDRESS: 25 rd E Buchanan Dr
PROPERTY TAX NO: 2945-032-99-001
SUBDIVISION: Colonial
PROPERTY OWNER: Blue Star
OWNER'S PHONE: 255-8853
OWNER'S ADDRESS: 2350 rd
CONTRACTOR NAME: D&R Fence
CONTRACTOR'S PHONE: 874-1826
CONTRACTOR'S ADDRESS: 1570 H-50 rd Delta
FENCE MATERIAL & HEIGHT: 6' cedar

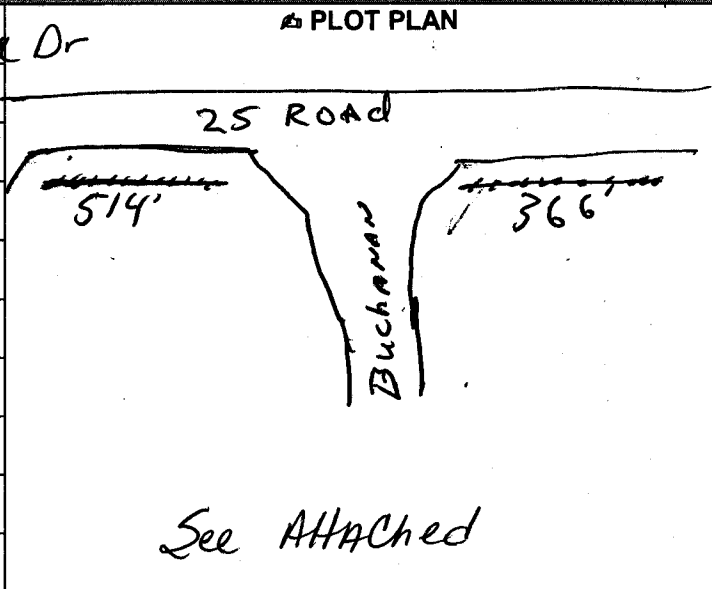

Plot plan must show property lines and property dimensions, all easements, all rights-of-way, all structures, all setbacks from property lines, & fence height(s). NOTE: PROPERTY LINE IS LIKELY ONE FOOT OR MORE BEHIND THE SIDEWALK.

THIS SECTION TO BE COMPLETED BY COMMUNITY DEVELOPMENT DEPARTMENT STAFF

ZONE RMF-5
SETBACKS: Front from property line (PL) or
SPECIAL CONDITIONS See Laura's drawing from center of ROW, whichever is greater.
Side from PL Rear from PL

Fences exceeding six feet in height require a separate permit from the City/County Building Department. A fence constructed on a corner lot that extends past the rear of the house along the side yard or abuts an alley requires approval from the City Engineer (Section 4.1.J of the Grand Junction Zoning and Development Code).


The owner/applicant must correctly identify all property lines, easements, and rights-of-way and ensure the fence is located within the property's boundaries. Covenants, conditions, restrictions, easements and/or rights-of-way may restrict or prohibit the placement of fence(s). The owner/applicant is responsible for compliance with covenants, conditions, and restrictions which may apply. Fences built in easements may be subject to removal at the property owner's sole and absolute expense. Any modification of design and/or material as approved in this fence permit must be approved, in writing, by the Community Development Department Director.

I hereby acknowledge that I have read this application and the information and plot plan are correct; I agree to comply with any and all codes, ordinances, laws, regulations, or restrictions which apply. I understand that failure to comply shall result in legal action, which may include but not necessarily be limited to removal of the fence(s) at the owner's cost.

Applicant's Signature [Signature] Date 7/13/04
Community Development's Approval [Signature] Date 7/13/04
City Engineer's Approval (if required) Date

VALID FOR SIX MONTHS FROM DATE OF ISSUANCE (Section 2.2.E.1.d Grand Junction Zoning & Development Code)
(White: Planning) (Yellow: Customer) (Pink: Code Enforcement)

City of Grand Junction GIS Zoning Map

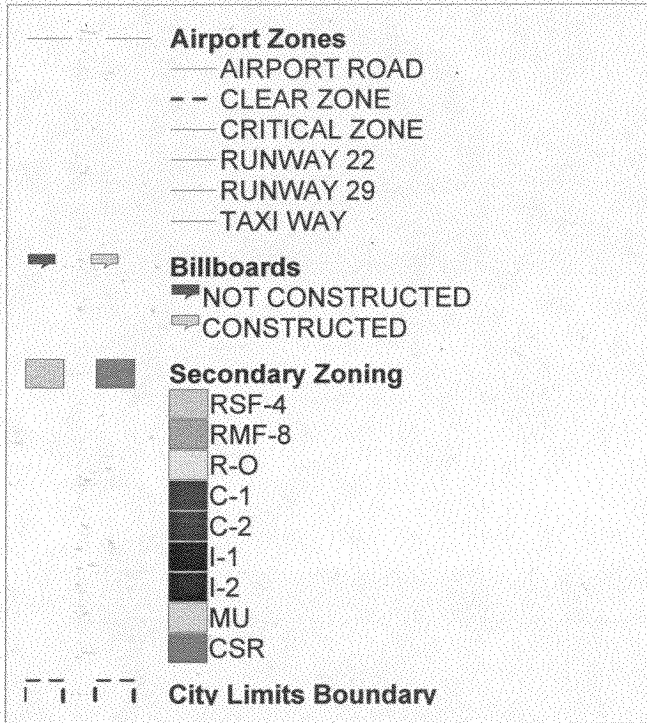

















SCALE 1 : 2,722



Colonial Heights Fence

*575' sight distance OK
Fence at back (east side of tract)*

-  PUMP STATIONS
-  SANITARY MANHOLES
-  PRIVATE MANHOLES
-  COMBINED SANITARY MANHOLES
-  FORCED MAIN MANHOLES
-  STORM MANHOLES
-  CATCH BASINS
-  IRRIGATION GATES
-  CATCH BASIN LATERALS
-  ABANDONED SEWER
-  FORCE MAINS
-  FORCE MAINS-NOT SURVEYED
-  COMBINED SEWER
-  SANITARY SEWER
-  SANITARY SEWER-NOT SURVEYED
-  STORM SEWER



SCALE 1 : 2,400

