



# FENCE PERMIT

## GRAND JUNCTION COMMUNITY DEVELOPMENT DEPARTMENT

THIS SECTION TO BE COMPLETED BY APPLICANT

PROPERTY ADDRESS 2826 B.3 Road G.J 81503  PLOT PLAN

TAX SCHEDULE NO 2943-303-67-014

PROPERTY OWNER John + Meredith Wort

OWNER'S PHONE (405) 303-2391

OWNER'S ADDRESS 712 Hidden Lake Dr  
Seminole OK 74868

CONTRACTOR Bookcliff Fence + Vinyl

CONTRACTOR'S PHONE 216-7828

CONTRACTOR'S ADDRESS 469 Pera St.  
Clifton CO 81520

FENCE MATERIAL Vinyl w/ Lattice

FENCE HEIGHT 6'

See Attached

Plot plan must show property lines and property dimensions, all easements, all rights-of-way, all structures, all setbacks from property lines, & fence height(s). NOTE: PROPERTY LINE IS LIKELY ONE FOOT OR MORE BEHIND THE SIDEWALK.

THIS SECTION TO BE COMPLETED BY COMMUNITY DEVELOPMENT DEPARTMENT STAFF

ZONE RMF-5 SETBACKS: Front 20' from property line (PL) or  
SPECIAL CONDITIONS 5' off sidewalk from center of ROW, whichever is greater.  
Side 0' from PL Rear 0' from PL


Fences exceeding six feet in height require a separate permit from the City/County Building Department. A fence constructed on a corner lot that extends past the rear of the house along the side yard or abuts an alley requires approval from the City Engineer (Section 4.1.J of the Grand Junction Zoning and Development Code).

The owner/applicant must correctly identify all property lines, easements, and rights-of-way and ensure the fence is located within the property's boundaries. Covenants, conditions, restrictions, easements and/or rights-of-way may restrict or prohibit the placement of fence(s). The owner/applicant is responsible for compliance with covenants, conditions, and restrictions which may apply. Fences built in easements may be subject to removal at the property owner's sole and absolute expense. Any modification of design and/or material as approved in this fence permit must be approved, in writing, by the Community Development Department Director.

I hereby acknowledge that I have read this application and the information and plot plan are correct; I agree to comply with any and all codes, ordinances, laws, regulations, or restrictions which apply. I understand that failure to comply shall result in legal action, which may include but not necessarily be limited to removal of the fence(s) at the owner's cost.

Applicant's Signature Paul Labay Date 3/28/03  
Community Development's Approval Hayden Date 3/28/03  
City Engineer's Approval (if required) Laura C. Lambert Date 3/28/03

VALID FOR SIX MONTHS FROM DATE OF ISSUANCE (Section 2.2.E.1.d Grand Junction Zoning & Development Code)  
(White: Planning) (Yellow: Customer) (Pink: Code Enforcement)

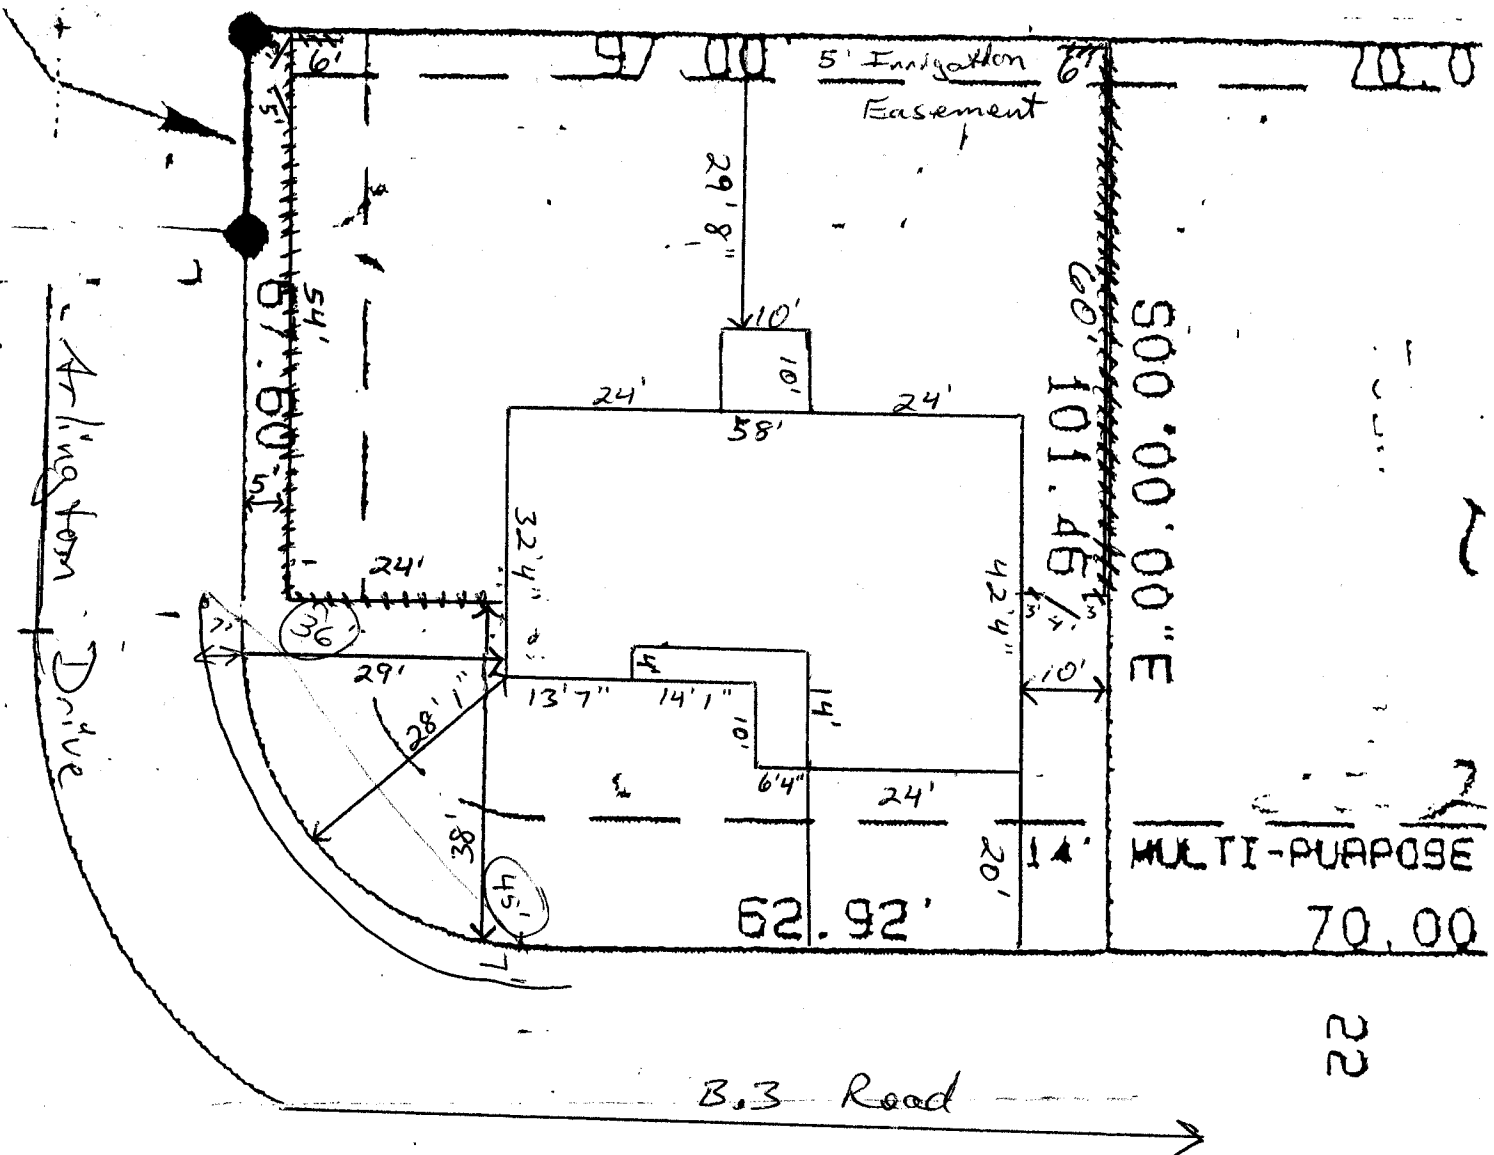

22

OK  
 all  
 3/28/03

2826 B.3 Road  
 Lot 1 Block 2 Arrowhead Acres II  
 Filing 3  
 Parcel # 2943-303-67-014