

FEE \$10.00

PERMIT # 14204

FENCE PERMIT
GRAND JUNCTION COMMUNITY DEVELOPMENT DEPARTMENT

Property Address: 128 Dry Creek
Property Tax No: 2943-324-13-012
Subdivision: Red Tail Ridge
Property Owner: Ridemore Enterprises
Owner's Telephone: 242-7444
Owner's Address: 703 232110 Road
Contractor's Name: Ridemore Enterprises
Contractor's Telephone: 242-7444
Contractor's Address: 703 232110 Road
Fence Material & Height: 4' Tall (max) concrete w/stucco finish

Plot plan must show property lines and property dimensions, all easements, all rights-of-way, all structures, all setbacks from property lines, and fence height(s). NOTE: Property line is likely one foot or more behind the sidewalk.

THIS SECTION TO BE COMPLETED BY COMMUNITY DEVELOPMENT DEPARTMENT STAFF
ZONE RSF-4
SPECIAL CONDITIONS
SETBACKS: Front 20' from property line (PL) or from center of ROW, whichever is greater.
Side 0' from PL Rear 0' from PL

Fences exceeding six feet in height require a separate permit from the City/County Building Department. A fence constructed on a corner lot that extends past the rear of the house along the side yard or abuts an alley requires approval from the City Engineer (Section 4.1.J of the Grand Junction Zoning and Development Code).


The owner/applicant must correctly identify all property lines, easements, and rights-of-way and ensure the fence is located within the property's boundaries. Covenants, conditions, restrictions, easements and/or rights-of-way may restrict or prohibit the placement of fence(s). The owner/applicant is responsible for compliance with covenants, conditions, and restrictions which may apply. Fences built in easements may be subject to removal at the property owner's sole and absolute expense. Any modification of design and/or material as approved in this fence permit must be approved, in writing, by the Community Development Department Director.

I hereby acknowledge that I have read this application and the information and plot plan are correct; I agree to comply with any and all codes, ordinances, laws, regulations, or restrictions which apply. I understand that failure to comply shall result in legal action, which may include but not necessarily be limited to removal of the fence(s) at the owner's cost.





Applicant's Signature [Signature] Date 10/11/02
Community Development's Approval [Signature] Date 10/12/02
City Engineer's Approval (if required) Date

VALID FOR SIX MONTHS FROM DATE OF ISSUANCE (Section 2.2.E.1.d Grand Junction Zoning & Development Code)

(White: Planning) (Yellow: Customer) (Pink: Code Enforcement)

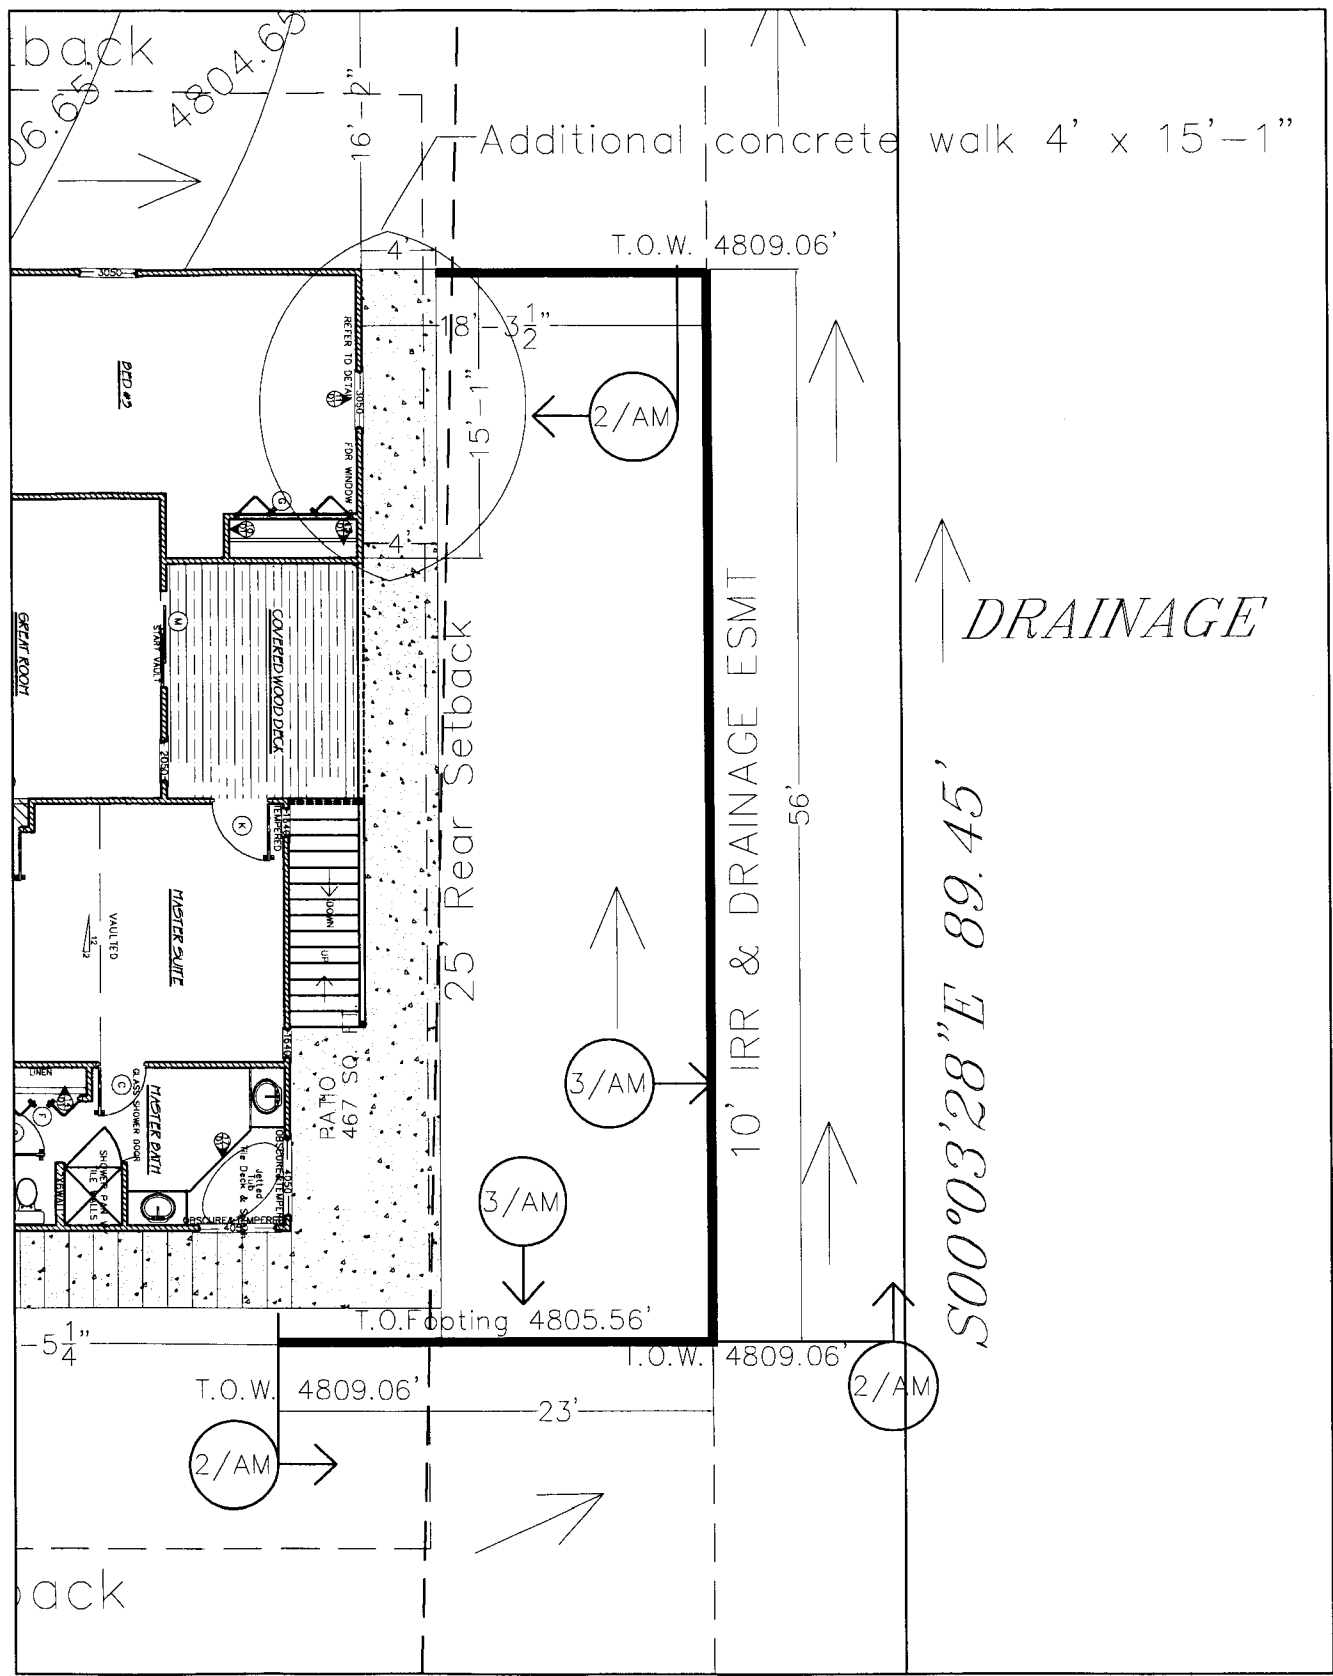

1 PLAN VIEW
AM 1"=10'

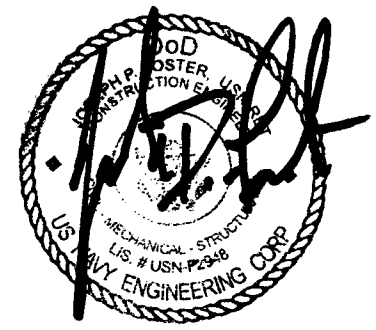 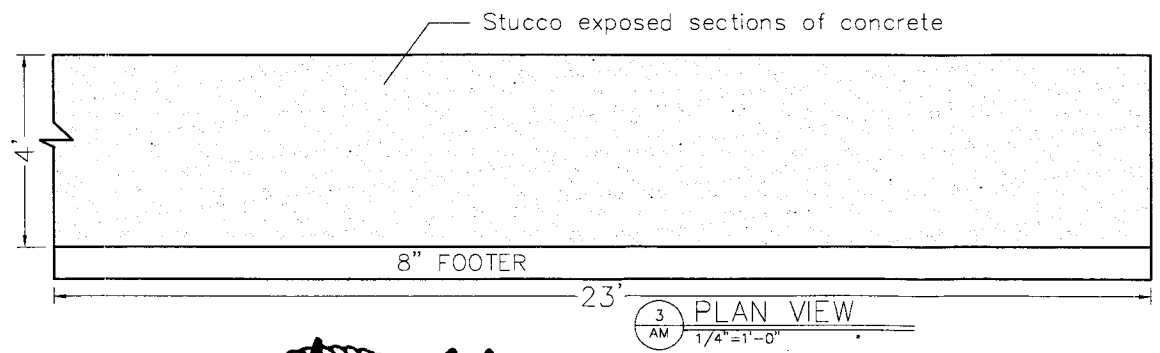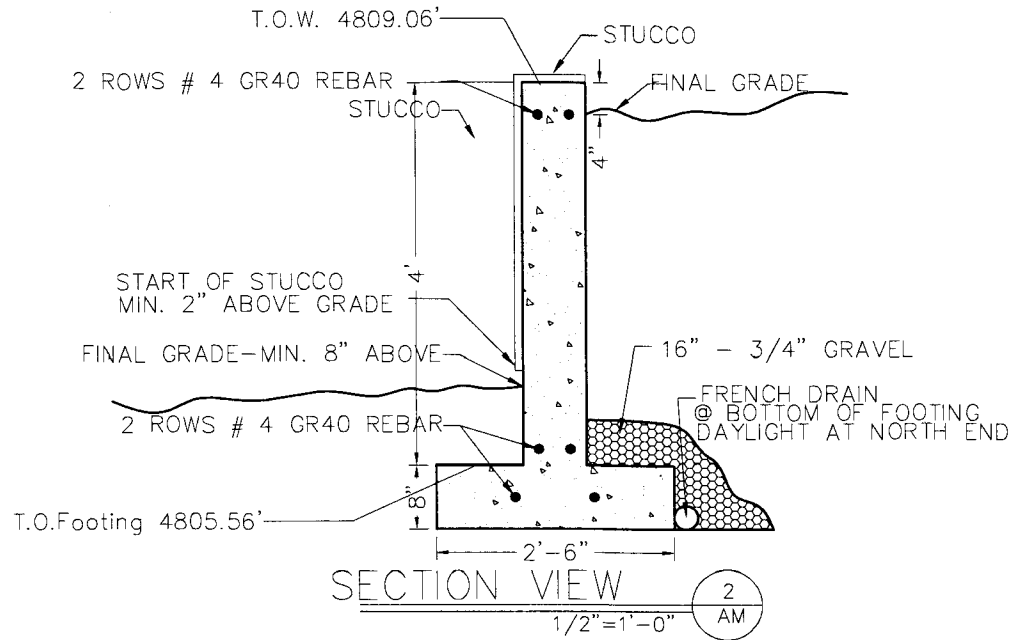

Joseph P. Foster USN Ret. 10/11/06
 Commission expiration: indef.

*Addition of 60 square foot walkway from existing walk to North-East corner of basement, & retaining wall revised to continuous 4' tall x 93'-3 1/2" long retaining wall

Ridmore Enterprises, Inc
 703 23 1/2 Road
 Grand Junction, CO. 81505
 Phone: 970-242-7444
 Fax: 970-242-7454
 Ridmore@casol.net

128 DRY CREEK ROAD
 RETAINING WALL & CONC. WALK
 Ret-wall plan & add walk-way

REVISIONS:
9-27-06
10-2-06
10-6-06
10-10-07
DRAWING BY:
KD
PLAN DATE:
4-26-06

AM2