



Fence Permit

PERMIT # NO 16372

Public Works & Planning Department
250 North 5th Street
Grand Junction, CO 81501
Phone: (970) 244-1430 FAX: (970) 256-4031

Fee \$10.00

Property Address: 2976 SWAN MEADOWS DR.

Property Tax No: 2943-021-16-001

Subdivision: Swan Meadows

Property Owner: DAVID L. GARE

Owner's Telephone: 255-7084

Owner's Address: 329 LILAC LN. GRAND JCT.

Contractor's Name: self

Contractor's Telephone: _____

Contractor's Address: _____

Fence Material & Height: CEGAR 6'

Plot plan must show property lines and property dimensions, all easements, all rights-of-way, all structures, all setbacks from property lines, and fence height(s). NOTE: Property line is likely one foot or more behind the sidewalk.

THIS SECTION TO BE COMPLETED BY PLANNING STAFF

ZONE <u>R-4</u>	SETBACKS: Front <u>20</u> from property line (PL) or
SPECIAL CONDITIONS <u>none</u>	_____ from center of ROW, whichever is greater.
	Side <u>0</u> from PL Rear <u>0</u> from PL

Fences exceeding six feet in height require a separate permit from the City/County Building Department. A fence constructed on a corner lot that extends past the rear of the house along the side yard or abuts an alley requires approval from the City Engineer (Section 4.1.J of the Grand Junction Zoning and Development Code).

The owner/applicant must correctly identify all property lines, easements, and rights-of-way and ensure the fence is located within the property's boundaries. Covenants, conditions, restrictions, easements and/or rights-of-way may restrict or prohibit the placement of fence(s). The owner/applicant is responsible for compliance with covenants, conditions, and restrictions which may apply. Fences built in easements may be subject to removal at the property owner's sole and absolute expense. Any modification of design and/or material as approved in this fence permit must be approved, in writing, by the Public Works & Planning Department Director.

I hereby acknowledge that I have read this application and the information and plot plan are correct; I agree to comply with any and all codes, ordinances, laws, regulations, or restrictions which apply. I understand that failure to comply shall result in legal action, which may include but not necessarily be limited to removal of the fence(s) at the owner's cost.

Applicant's Signature David Gare Date 2-19-10

Planning Approval Pat Denley Date 2/19/10

City Engineer's Approval (if required) _____ Date _____

VALID FOR SIX MONTHS FROM DATE OF ISSUANCE (Section 2.2.E.1.d Grand Junction Zoning & Development Code)


(White: Planning)

(Yellow: Applicant)

(Pink: Neighborhood Services)

Building Sketch

Borrower	Any Qualified Veteran				
Property Address	2976 Swan Meadows DRIVE				
City	Grand Junction	County	Mesa	State	CO Zip Code 81504-4464
Lender	The Department of Veterans Affairs				

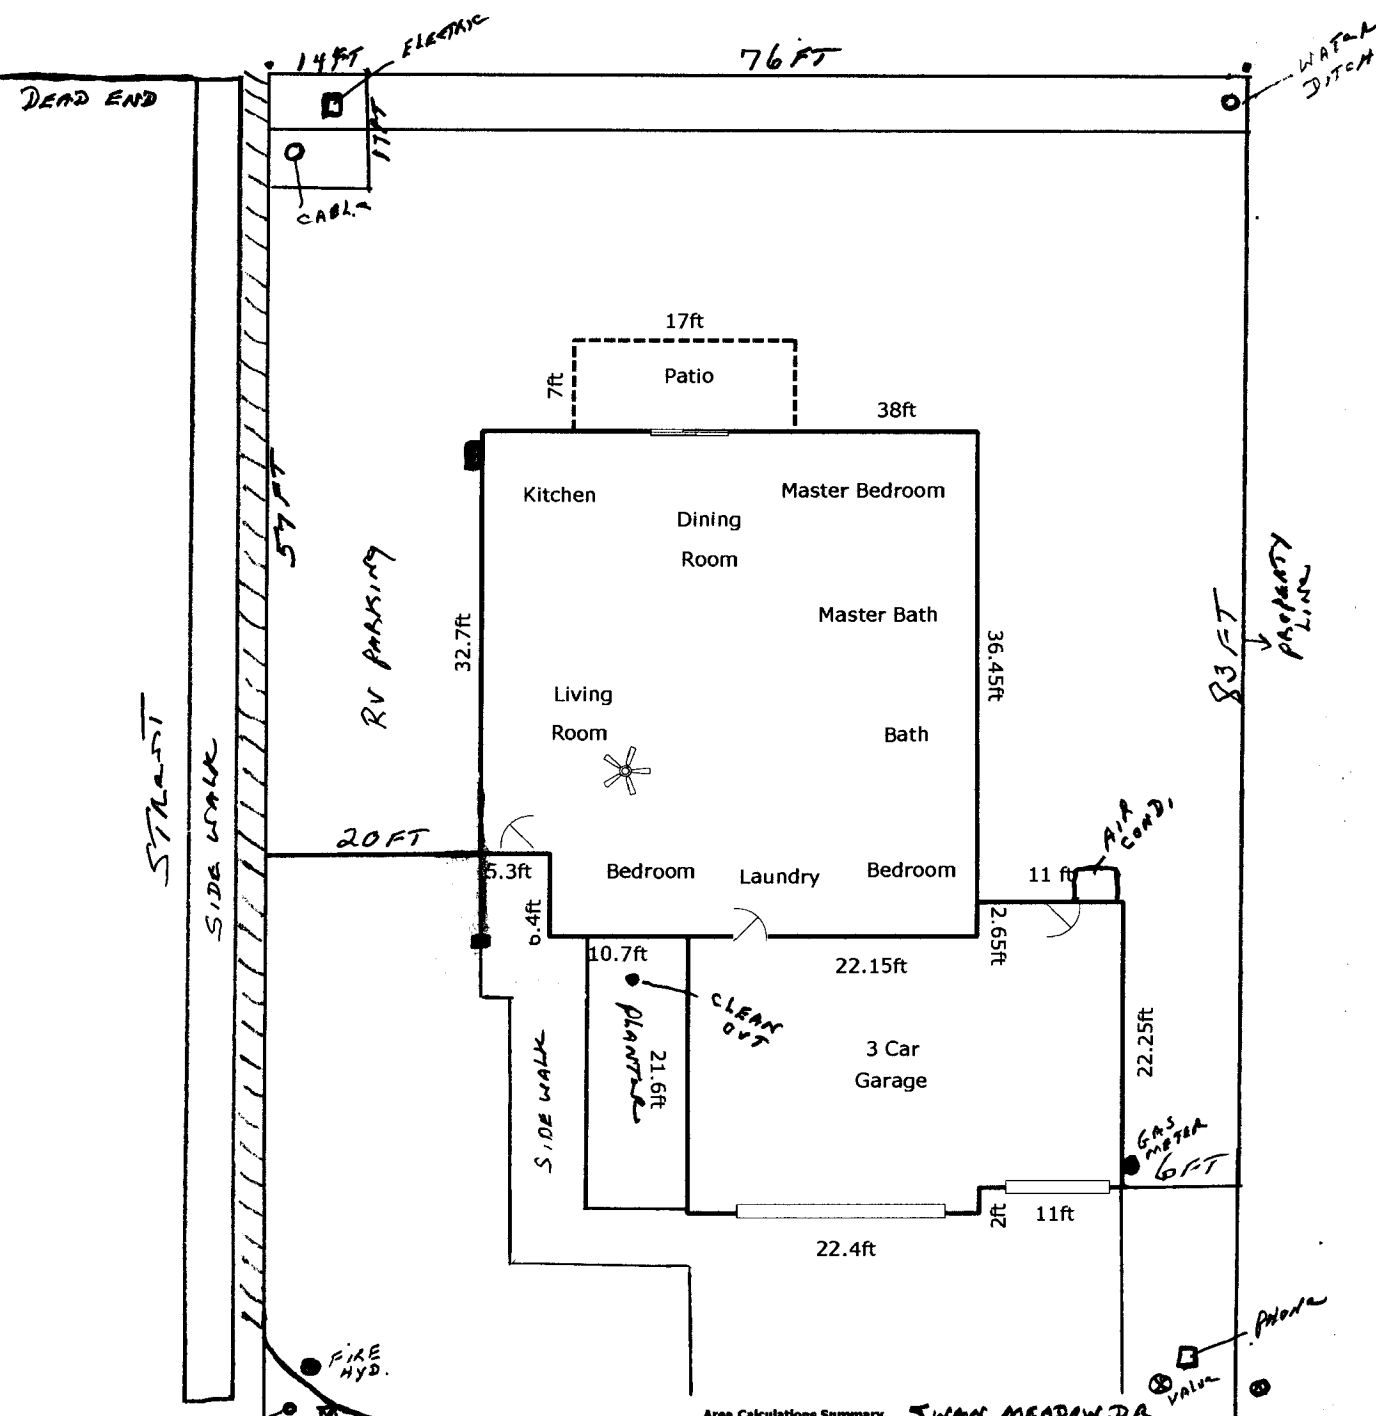

Area Calculations Summary **SWAN MEADOW DR**

Living Area	1455 Sq ft
First Floor	1455 Sq ft
Total Living Area (Rounded):	1455 Sq ft
Non-living Area	
Concrete Patio	119 Sq ft
3 Car Attached	729.3 Sq ft